


TOWN OF BROWNINGTON
 Project ST 35N
 Pin # 99R761
 Route VTSA
 Date 1/1/1941

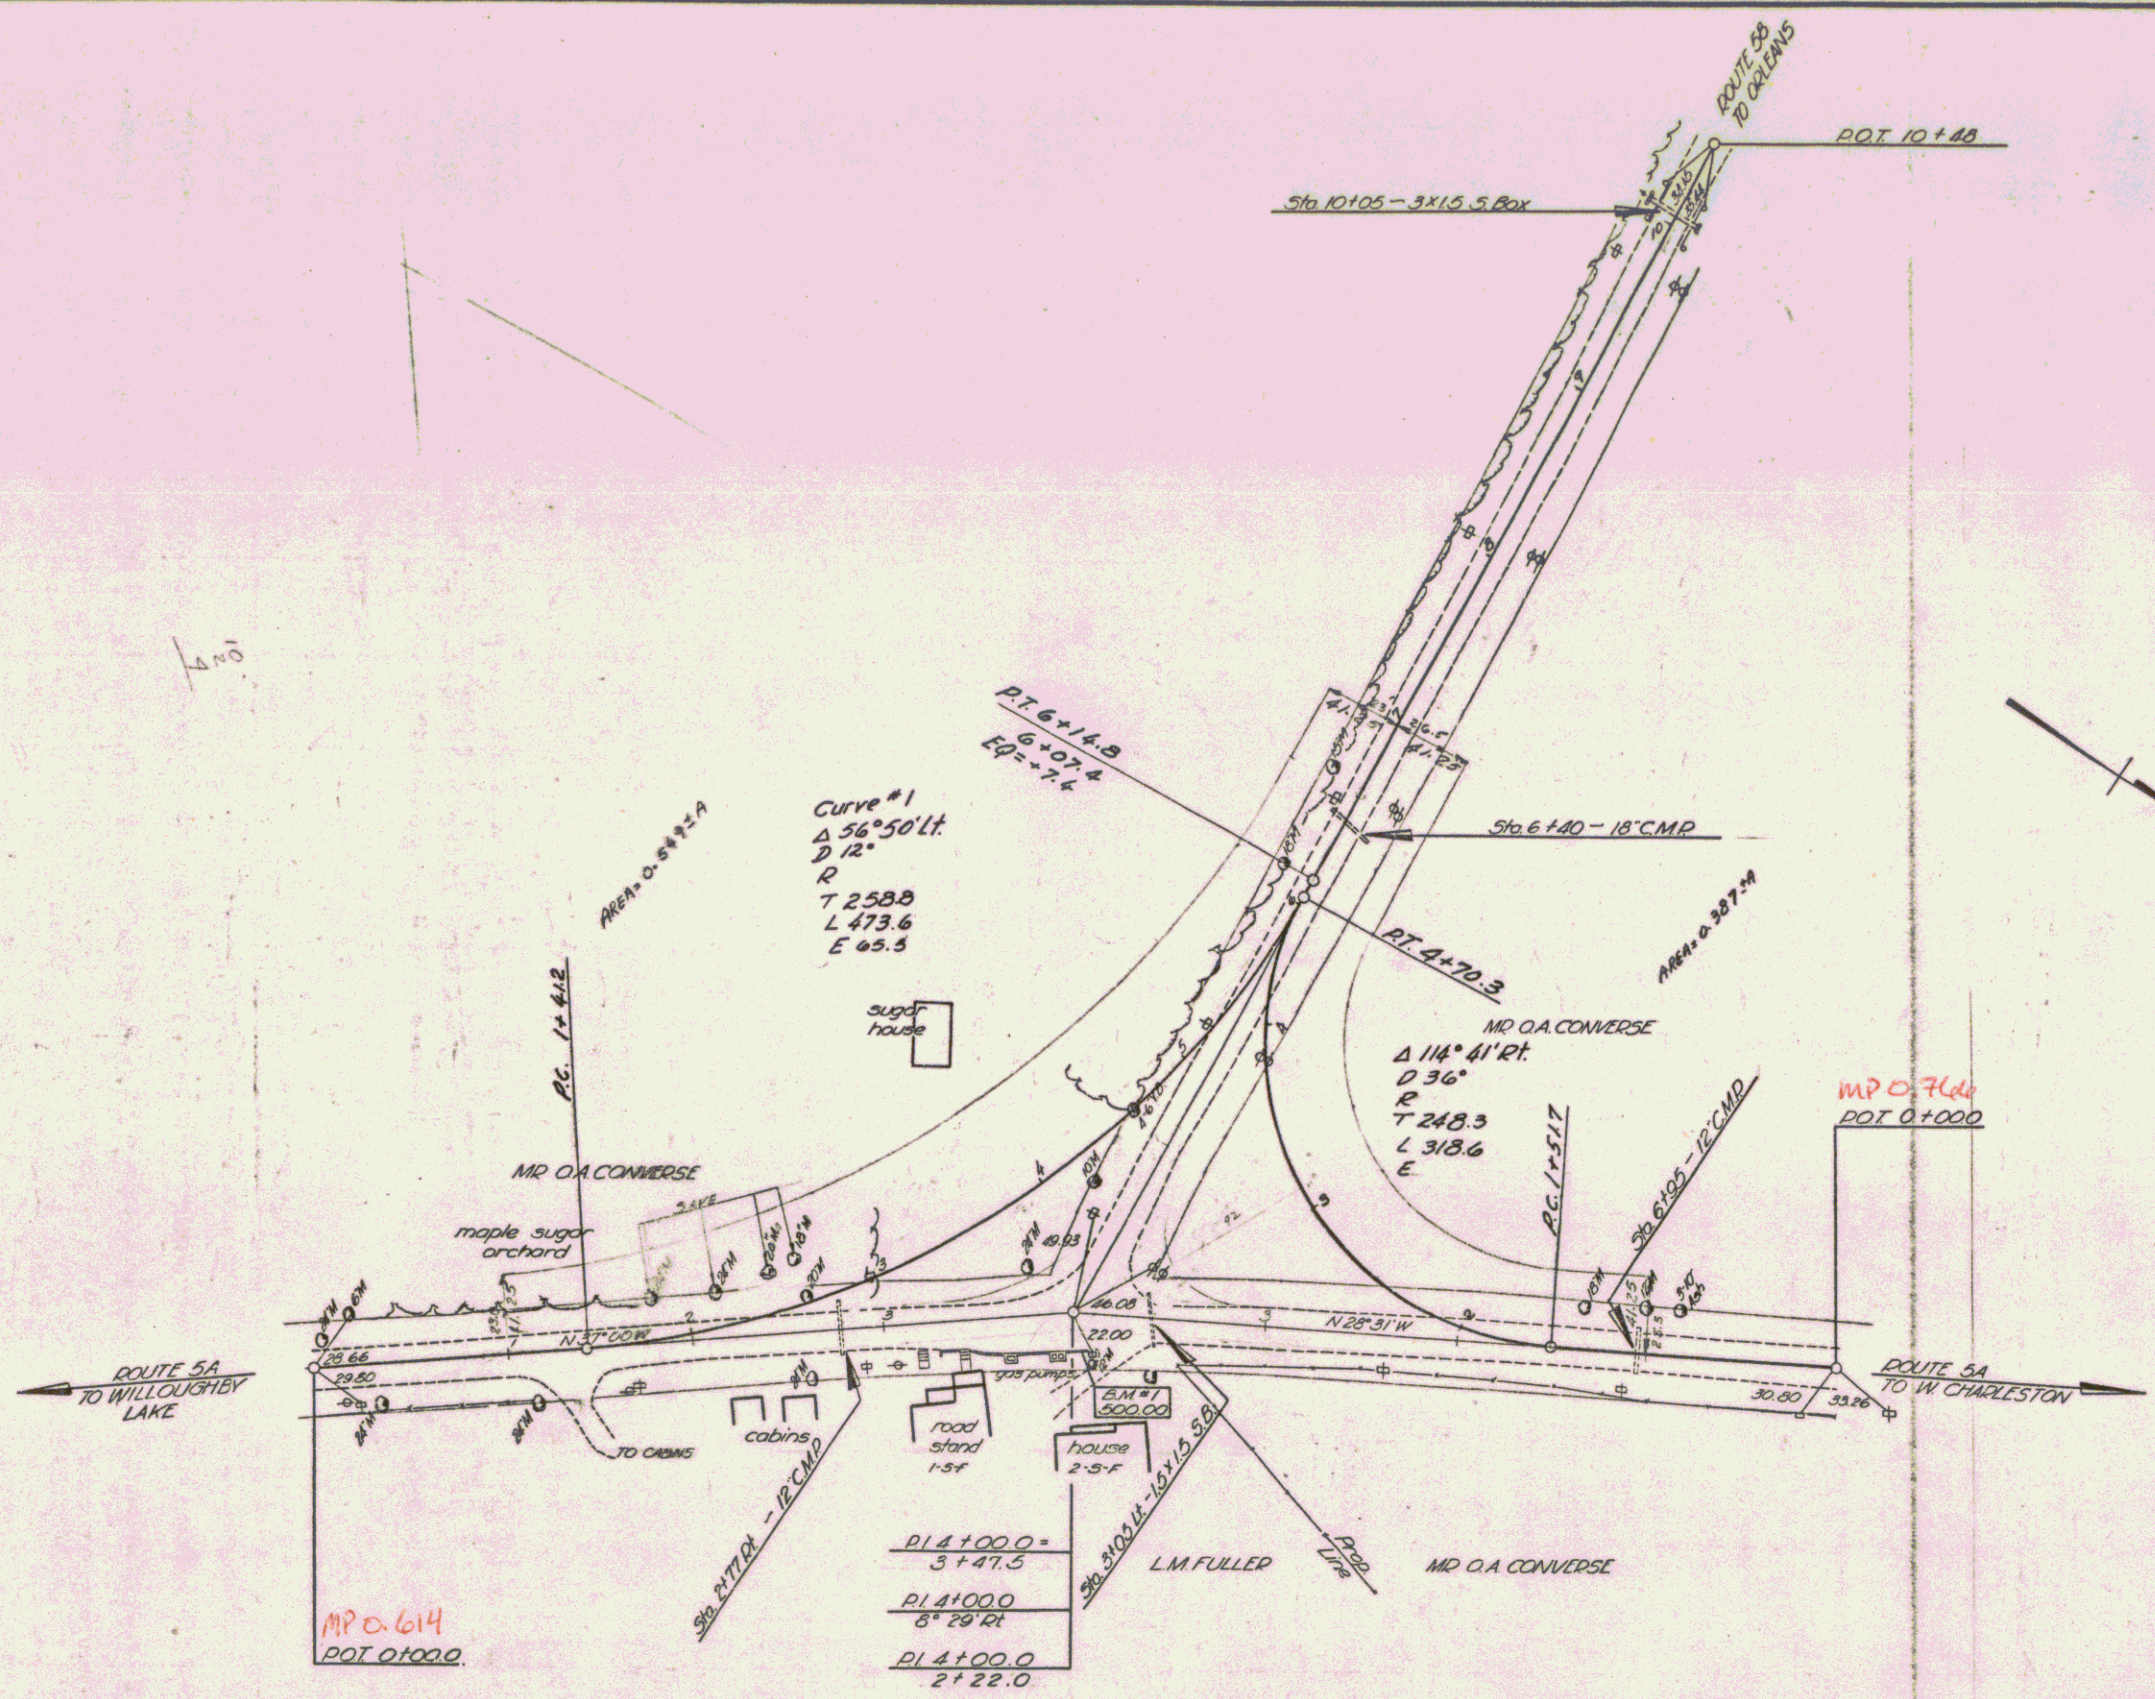

RIGHT-OF-WAY DIVISION
 TOWN FILE
 PERPETUAL
 Town of VTSA
 (To Be Returned To R.O.W. Division)

BROWNINGTON ROUTE 5A

Surveyed by	O. LANE	NOV 1941
Designed by		
Drawn by	E. ROGERS	NOV 1941
Traced by	E. ROGERS	NOV 1941
Checked by		
Series	5A	No. 35N
Sheet	1	of 1

