



PLAN
 DRAWN BY: [Signature]
 CHECKED BY: [Signature]
 DATE: 7-35
 SHEET NO.: 4-38

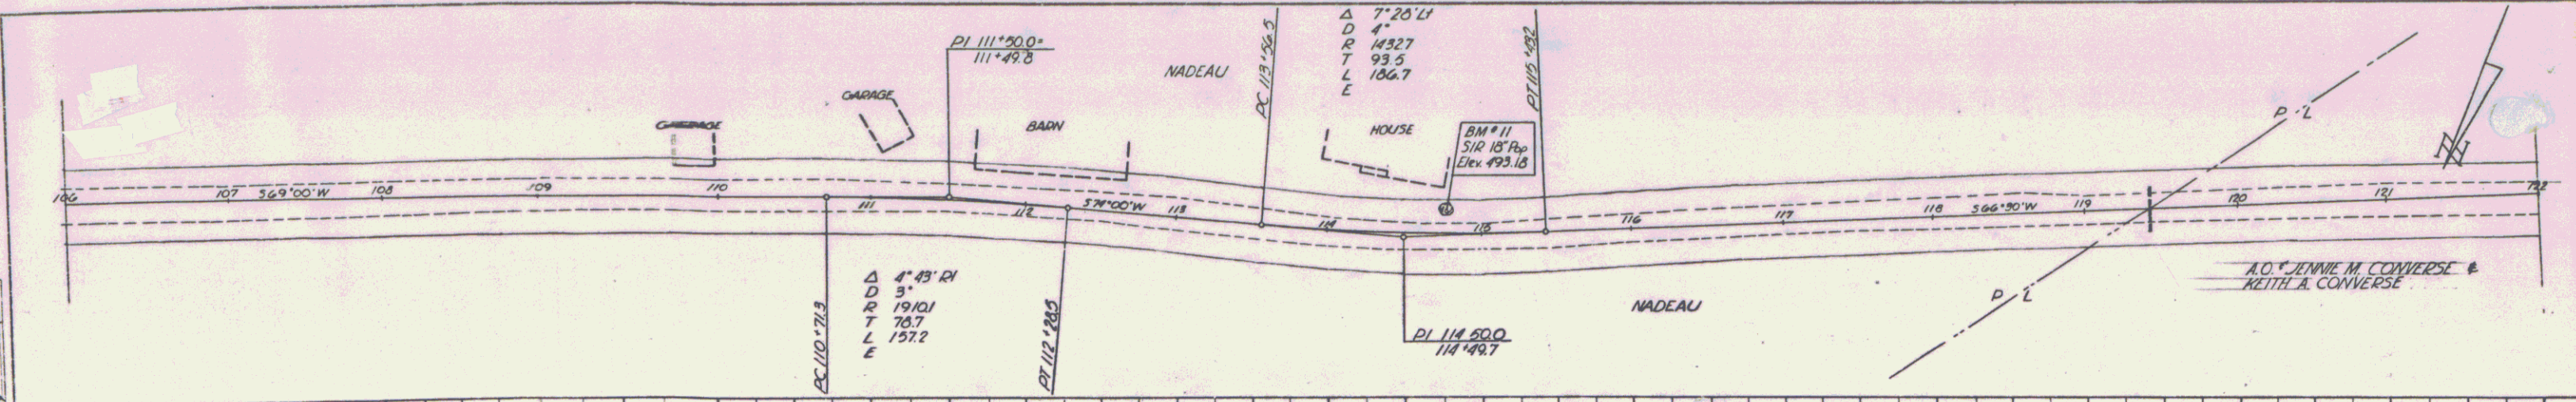

PROFILE
 DRAWN BY: [Signature]
 CHECKED BY: [Signature]
 DATE: [Blank]
 SHEET NO.: [Blank]

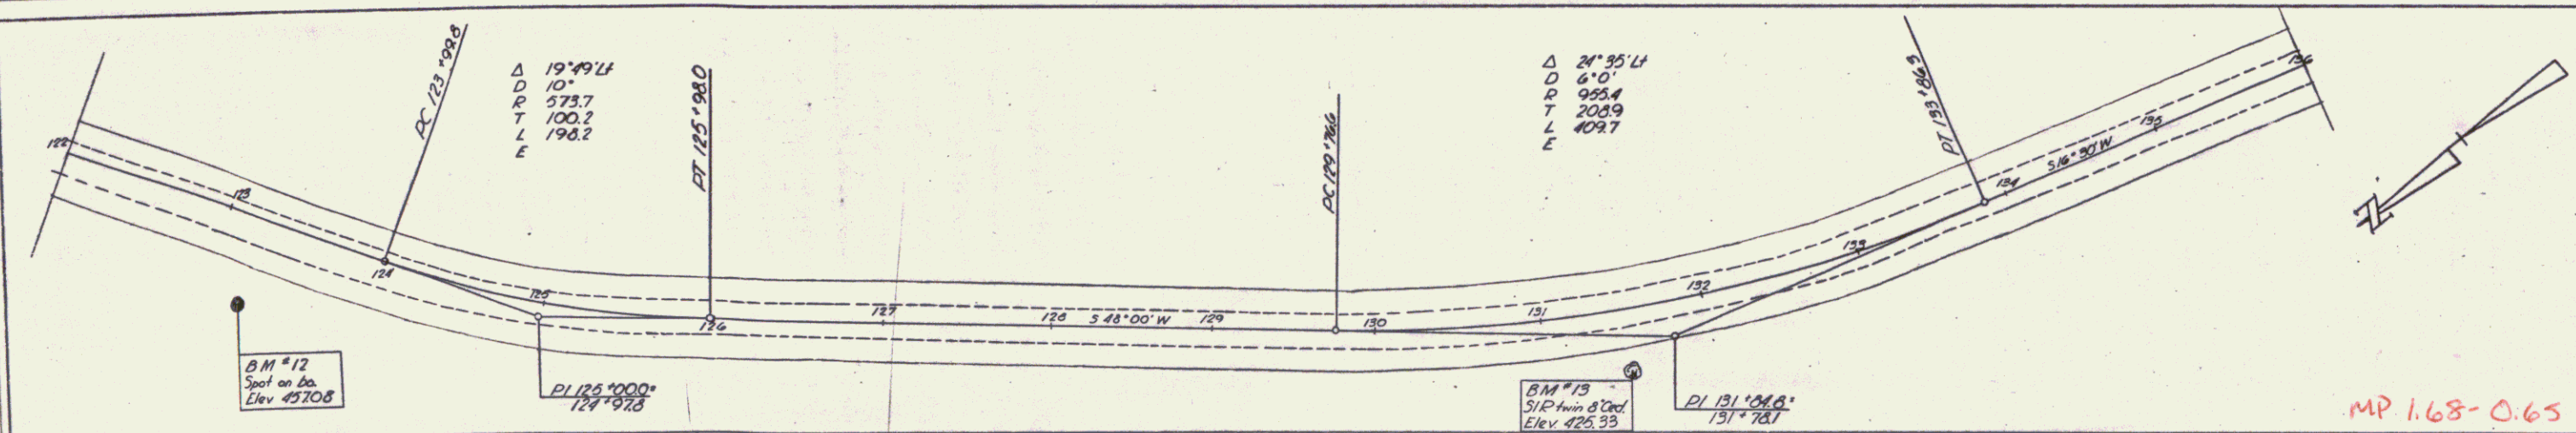

Pin# 992762

Route 115 A

Town Project BROWNINGTON St. 304

Sheet 1

8/1/55

PLATE 2 - PLAN - PROFILE - U.S. P.A.R.E. STANDARD
 KEUTTEL & ESSER CO., NEW YORK
 K & E Co. No. 348-10