


PLAN  
 DATE  
 BY  
 CHECKED  
 DATE  
 BY  
 NO. OF ANY CHECKS

PROFILE  
 DATE  
 BY  
 CHECKED  
 DATE  
 BY  
 NO. OF ANY CHECKS

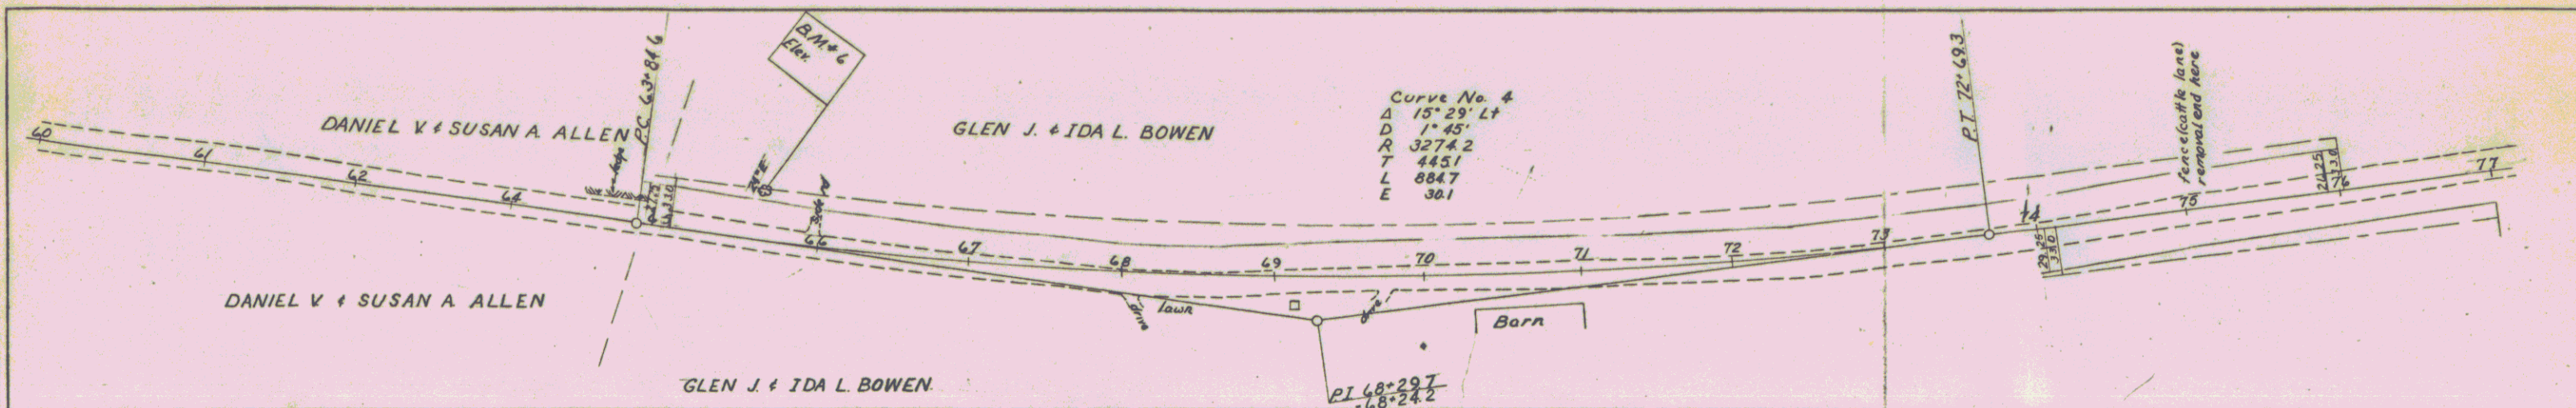

STATION	60	61	62	63	64	65	66	67	68	69	70	71	72	73	74	75	76	77
GRADE																		
VERT. CURV.																		
W.D.C.E.																		
RECORDED																		

GLEN J. + IDA L. BOWEN  
 4A (AC. 3±) STA 64+95 - 76+00 LT  
 SLOPE RIGHTS STA 64 - 95 + 85 - 27 LT  
 4B (AC. 15±) STA 74+00 - 80+35 RT  
 4C (AC. 11±) STA 81+52 - 85+27 RT  
 W.D.C.E. 9/11/55  
 RECORDED CHARLESTON BK 25 PG 166 1/20/56



STATION	76	77	78	79	80	81	82	83	84	85	86	87	88
GRADE													
VERT. CURV.													
W.D.C.E.													
RECORDED													

GLEN J. + IDA L. BOWEN  
 (H.O.M.) STA 81+52 - 85+27  
 W.D.C.E. 9/11/55  
 RECORDED CHARLESTON BK 25 PG 166 1/20/56

PLATES PLAN PROFILE C.F. & I. STANDARD  
 MAPS & SPEC. NO. 104  
 S.E.E. ON NO. 248-30

Sheet 3