

INDEX OF SHEETS

SHEET NO. 1	TITLE PAGE
2	TYPICAL CROSS-SECTION OF IMPROVEMENT
3	PLAN AND PROFILE STA. 0+00 TO STA. 16+00
4	" " " " 16+00 " " 32+00
5	" " " " 32+00 " " 46+85.5
6	BRIDGE - STA. 0+29
7 & 8	BRIDGE - STA. 14+04
9-14	CROSS-SECTIONS


STATE OF VERMONT  
STATE HIGHWAY DEPARTMENT

PLAN AND PROFILE OF PROPOSED  
STATE HIGHWAY  
FEDERAL AID PROJECT

TOWN OF BENNINGTON  
NORTH BENNINGTON ROAD  
FROM BENNINGTON VILLAGE LINE  
TO PERCEY'S CORNER

Acq = 99R766

Plan - 1" = 200'±  
Scales: Profile - 1" = 20'±  
Cross-Sections - 1" = 50'±

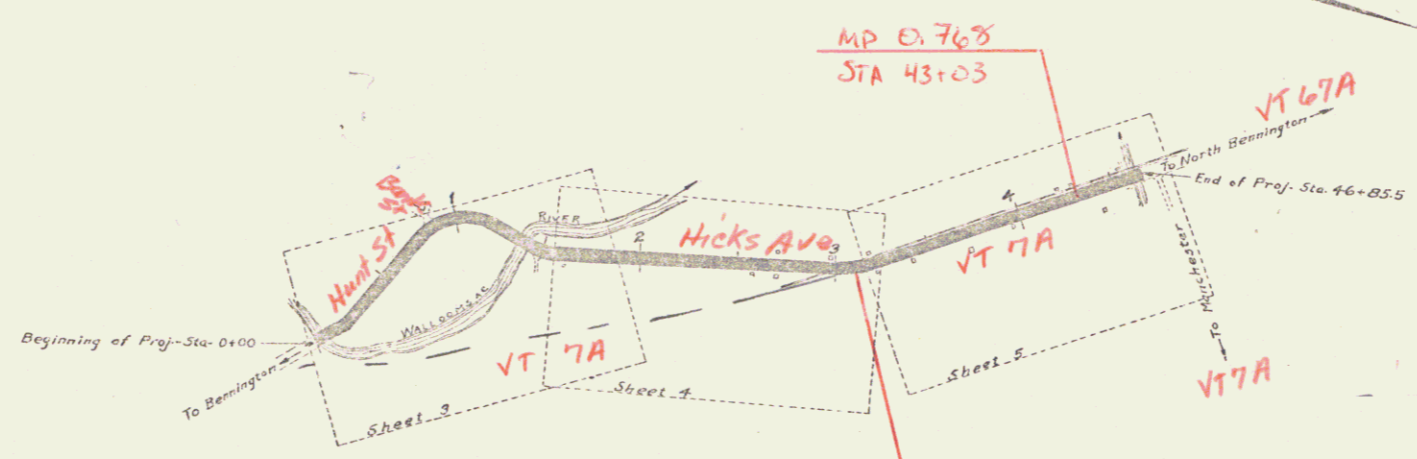

LAYOUT  
Scale - 500 FT. = 1 IN.

CONVENTIONAL SIGNS

COUNTY LINE	---	GROUND ELEVATION	DATA	LINE
TOWN LINE	----	GRADE ELEVATION	DATA	LINE
FENCE LINE	-----			
STONE WALL	-----			
UNFENCED PROPERTY	-----			
GUARD RAIL	-----			
TRAVELED WAY	-----			
RAILROAD	-----			
RETAINING WALL	-----			
BASE OR SURVEY LINE	-----			
CULVERT	-----			
DROP INLET	-----			
TROLLEY POLE	-----			
POWER POLE	-----			
TELEPHONE POLE	-----			
TREES	-----			
HEDGE	-----			

Project FAP 23  
Pin # 99R766  
Route VT 7A  
Date 1/1/1920

RECOMMENDED \_\_\_\_\_  
STATE ENGINEER  
APPROVED \_\_\_\_\_  
GOVERNOR  
SUBMITTED \_\_\_\_\_  
STATE HIGHWAY COMMISSIONER

RECOMMENDED \_\_\_\_\_  
DISTRICT ENGINEER  
BUREAU OF PUBLIC ROADS  
RECOMMENDED FOR APPROVAL \_\_\_\_\_  
CHIEF ENGINEER - BUREAU OF PUBLIC ROADS  
APPROVED \_\_\_\_\_  
DIRECTOR - BUREAU OF PUBLIC ROADS

RIGHT-OF-WAY DIVISION  
TOWN FILE  
PERPETUAL  
Date of 057  
(To Be Returned To R.O.W. Division)

Series F. No. 23 Filed  
Sheet 2 of 10

SEARNS R. JENKINS 1157 1