
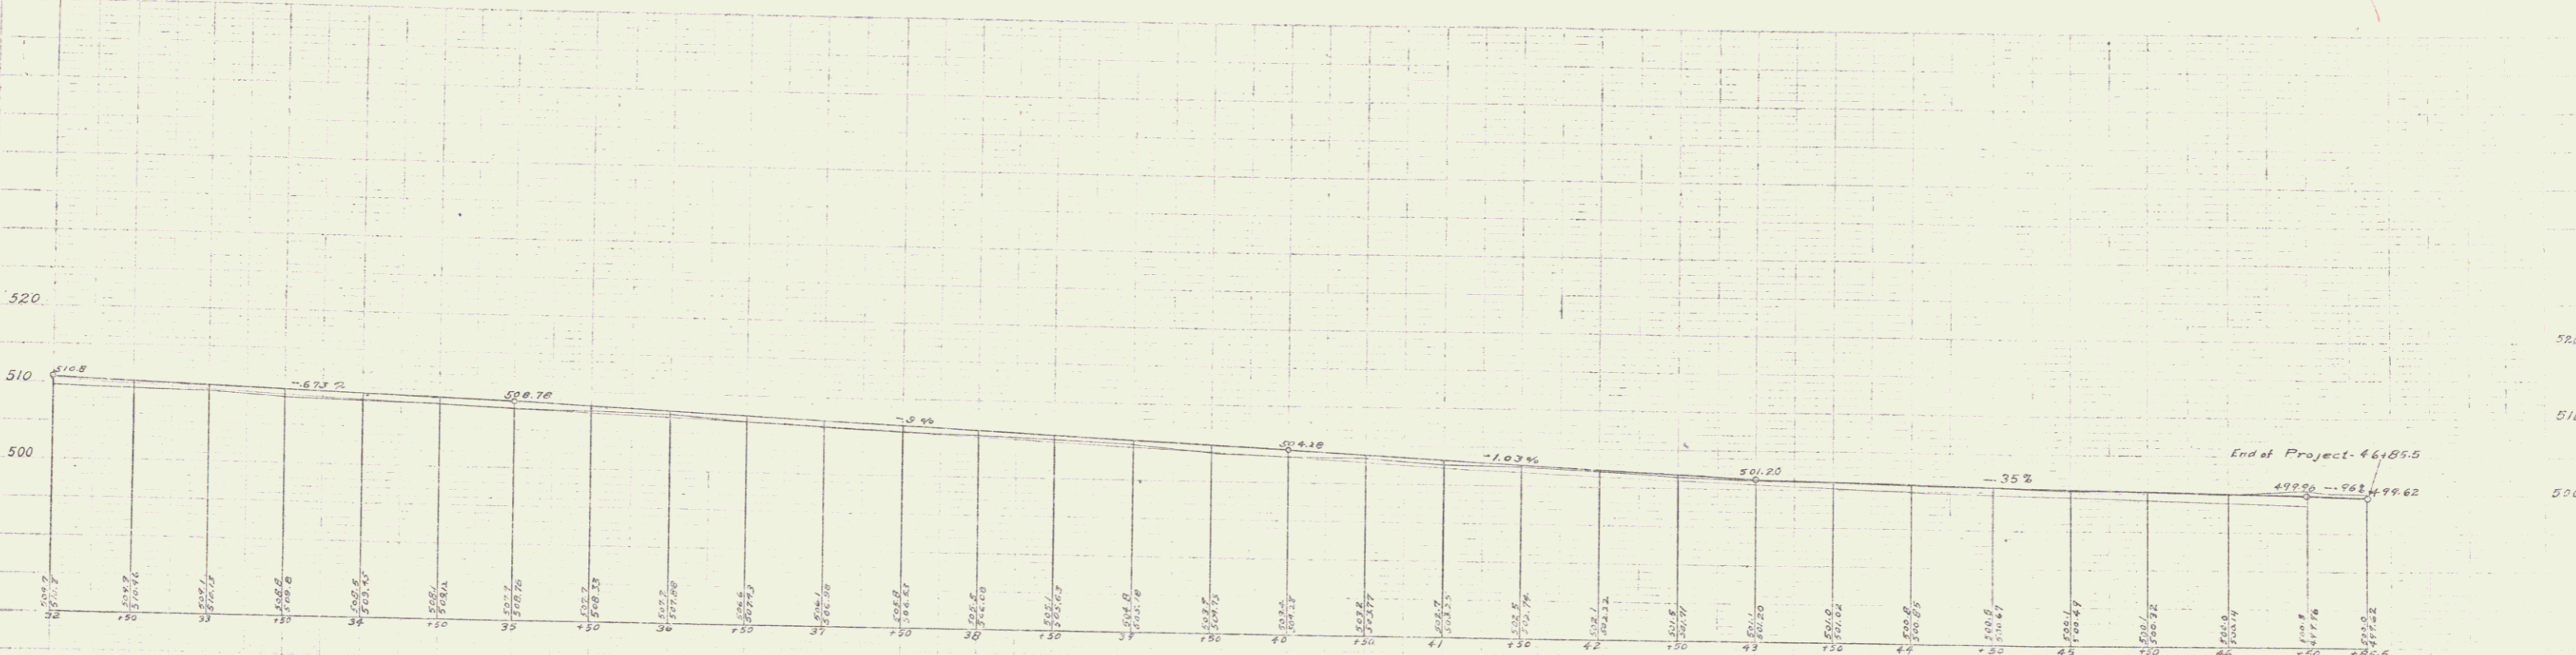


SUB-BASE REQUIRED  
Sta. 32+00 to Sta. 90+00 Length 580 R.

YEAR	STATE	FED. AID	PERCENTAGE	TOTAL
BUILD	YEAR	AMOUNT		
9	VT	23	100.0	23
		5		5
		14		14

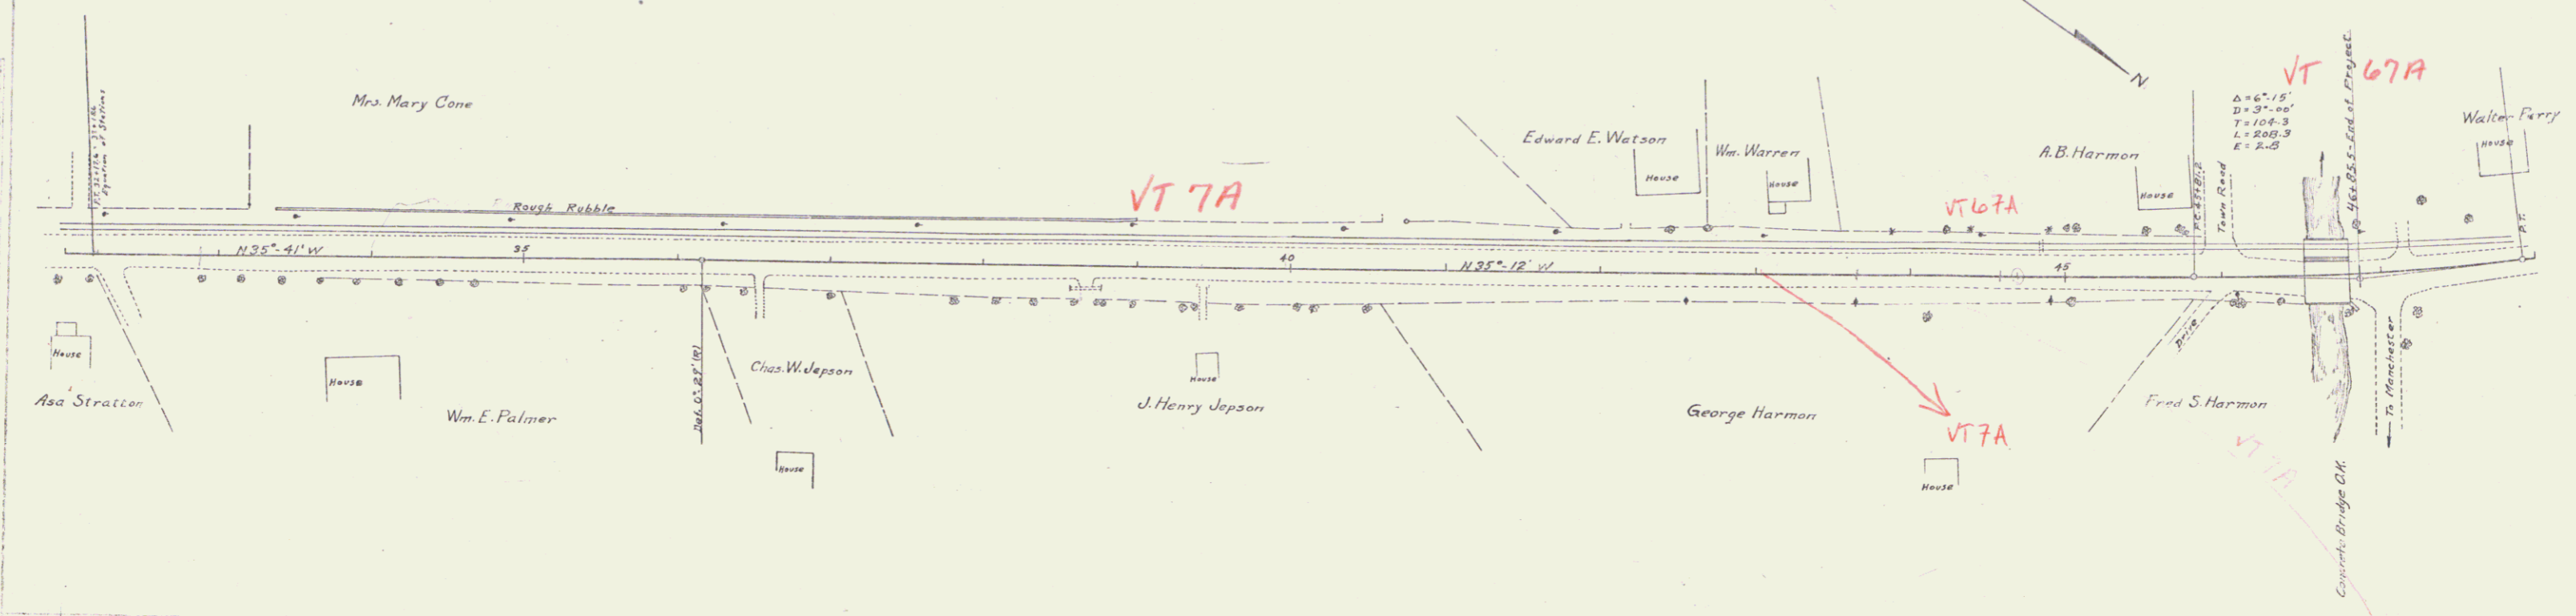

B.M. Spike in Stump 33' W. of Sta. 40+74 = 50.85  
B.M. Concrete guard at E. side railing post on bridge W. of Sta. 46+01 - Elev: 500.00