

WOOD GUARD RAIL REQUIRED

START STATION	LEFT	RIGHT
497+25	24'	24'
500+50	24'	24'
497+25	24'	24'

GRADUALLY COBBLE GUTTER REQUIRED

STA	STA	POS	WIDTH	AREA
497+32	497+82	LT	Varies	48.3

NEW BENT CONCRETE PIPE CURVES REQUIRED

STATION	CHY	LEN	COE. R.	COE. S.	PIPE SIZE
497+25	18'	00'44"	1.00	0.00	No. 42
500+50	18'	06'32"	1.00	0.00	No. 50



NEW BENT CONCRETE BOX CURVES REQUIRED

STATION	DATE	CHY. R.	PIPE SIZE
497+25	4'6"	280'	24" No. 280
		280'	24" No. 280

INTERNAL CURB W/HD

STA-STA	POS	WIDTH	LENGTH
497+25-497+50	AT	2'	50'

124 A 19.30 6 128

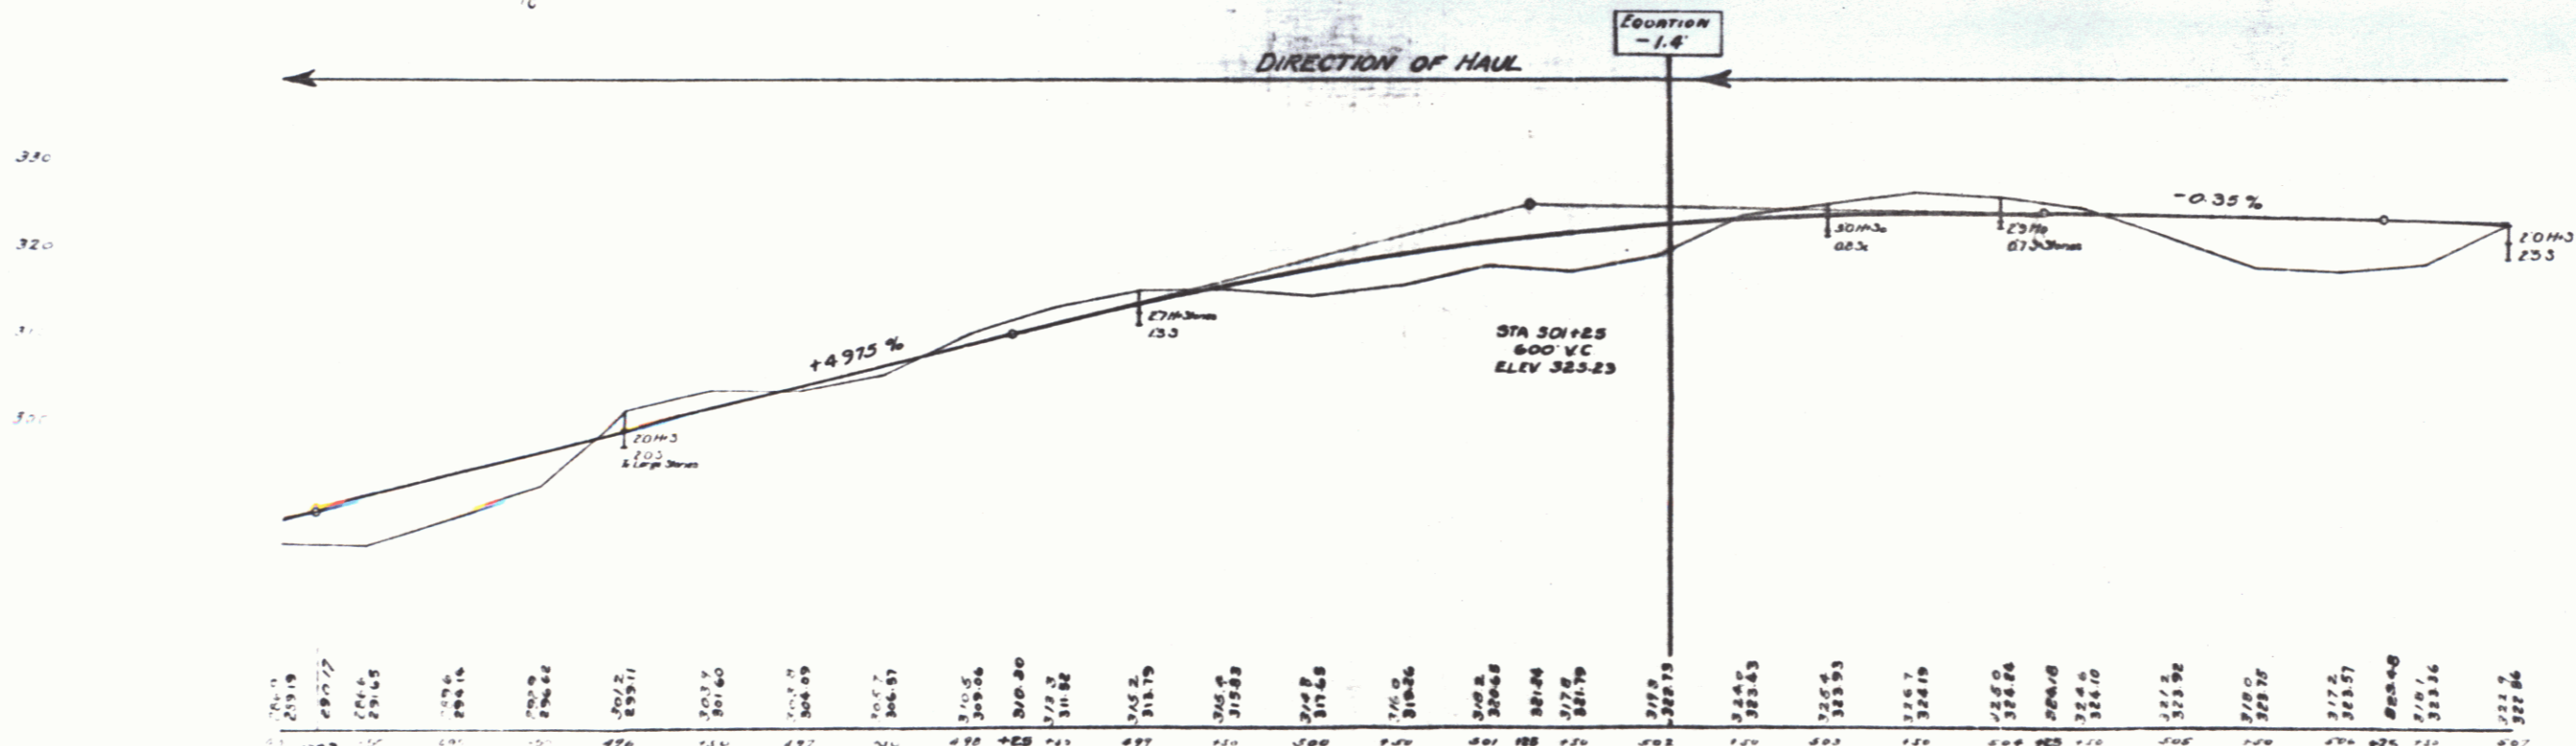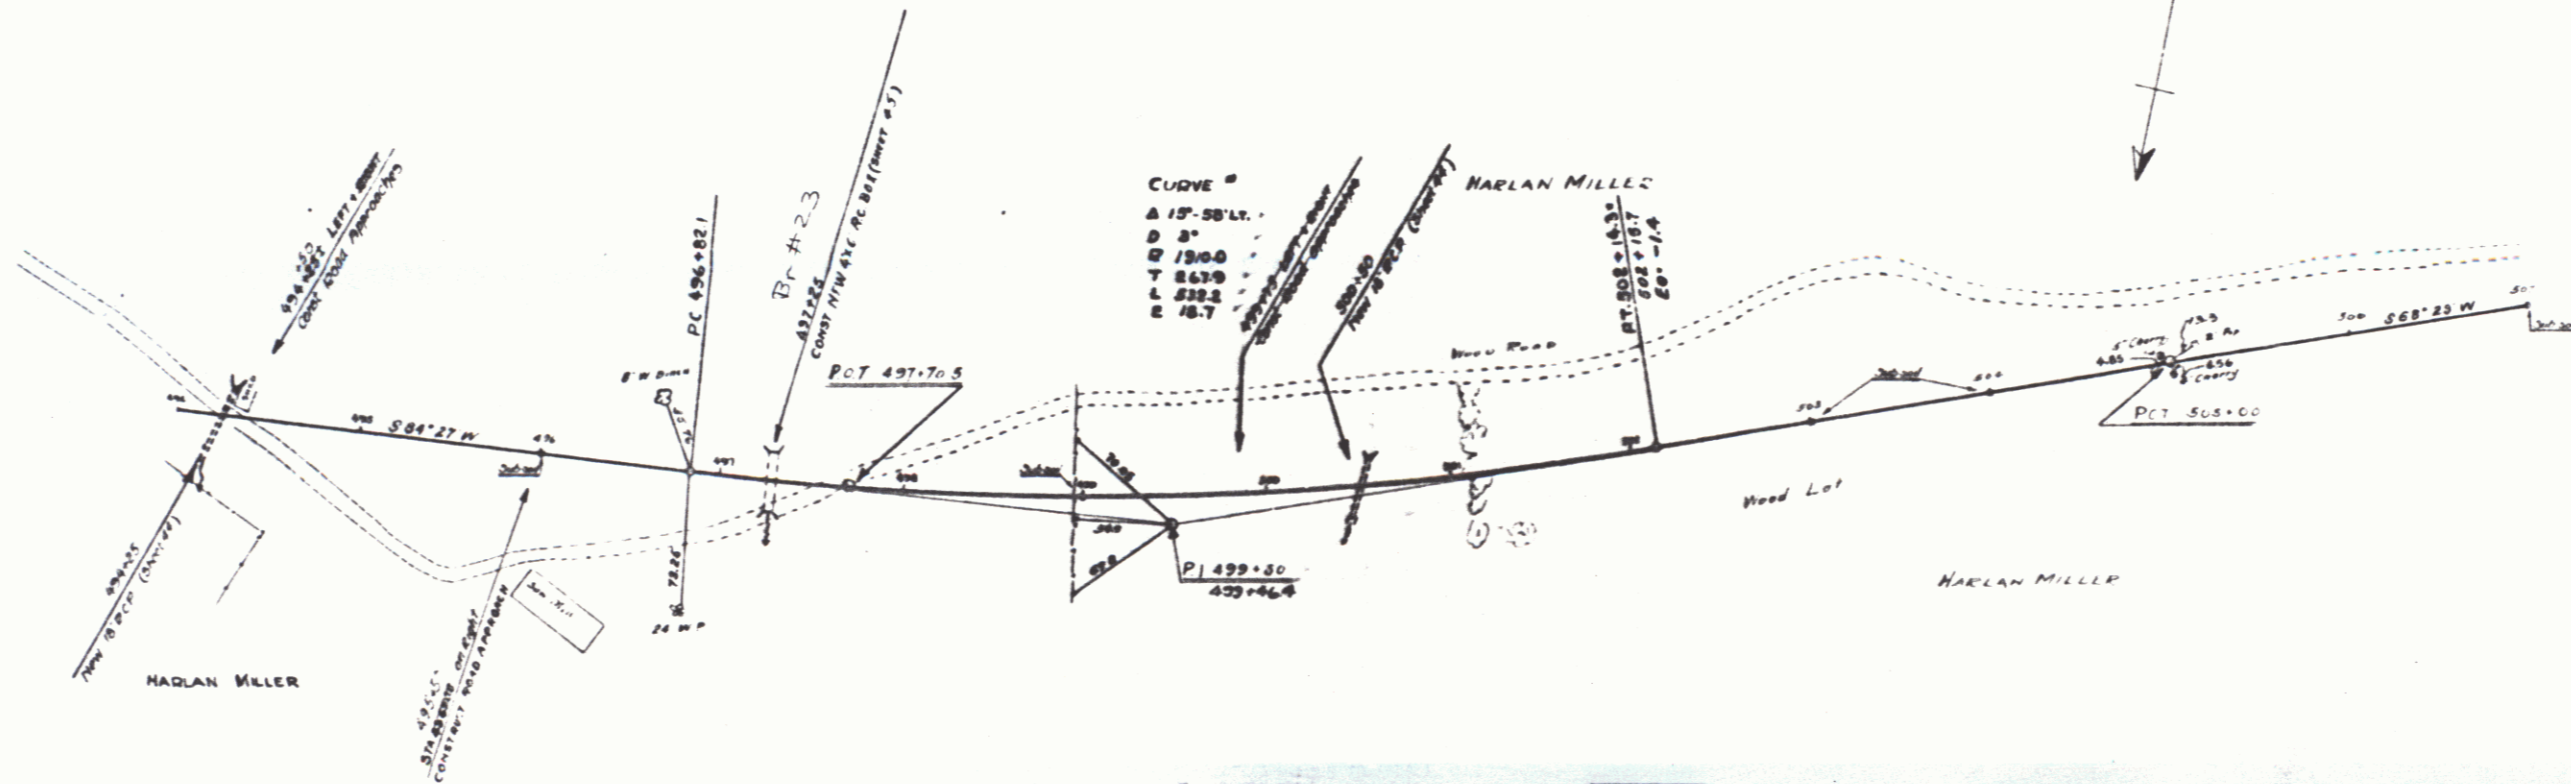

ELEV 323.23 SPIKE IN BODY OF PIPE RIGHT STA 498+00 ELEV 308.44
 D.M. BO A SPIKE IN BODY OF PIPE RIGHT STA 503+04 ELEV 329.17

PLANS COMPLETED	1-28-00
REVISIONS	DATE
POT 497+70.5 Ties Removed	4/8/00
P.C. 496+02.1 Ties Added	4/8/00

SEE SHEET 124 A
 SHEET 6 OF 128

4