

WOOD CURB EMB REQUIRED

CULVERT STATION	LEFT	RIGHT
536+46	24'	

CABLE GUARD EMB REQUIRED

STATIONS	LEFT	RIGHT
536+00-536+60	140'	
536+60-544+60	208'	
543+25-544+25	3'	0'
536+30-536+35	7'	140'
542+00-544+73	213'	

NEW REIN CONCRETE PIPE CULVERTS REQUIRED

STATION	DIAM	LENGTH	CONC	REIN STEEL
536+96	24"	36'	3-2#4	50 lbs
543+30	36"	46'	3-2#4	50 lbs
40	52	44		

GRADED COBBLE GUTTER REQUIRED

STATION	WIDTH	LENGTH	DEPTH
536+00-536+60	4'-0"	60'	4-1/2"
536+60-544+60	4'-0"	80'	4-1/2"
543+25-544+25	4'-0"	10'	4-1/2"
536+30-536+35	4'-0"	5'	4-1/2"
542+00-544+73	4'-0"	73'	4-1/2"

NEW REIN CONCRETE BOX CULVERTS REQUIRED



STATION	SIZE	CONC	REIN STEEL
535+25	4x6	4093 lb	4030 lb
		414	3437

INTEGRAL CURB USED

STATION	HT	LENGTH
536+00-536+60	2'	140'
542+50-544+20	2'	250'
542+00-544+33	2'	220'

INTEGRAL CURB USED

STATION	HT	LENGTH
536+00-536+60	2'	140'
542+50-544+20	2'	250'
542+00-544+33	2'	220'

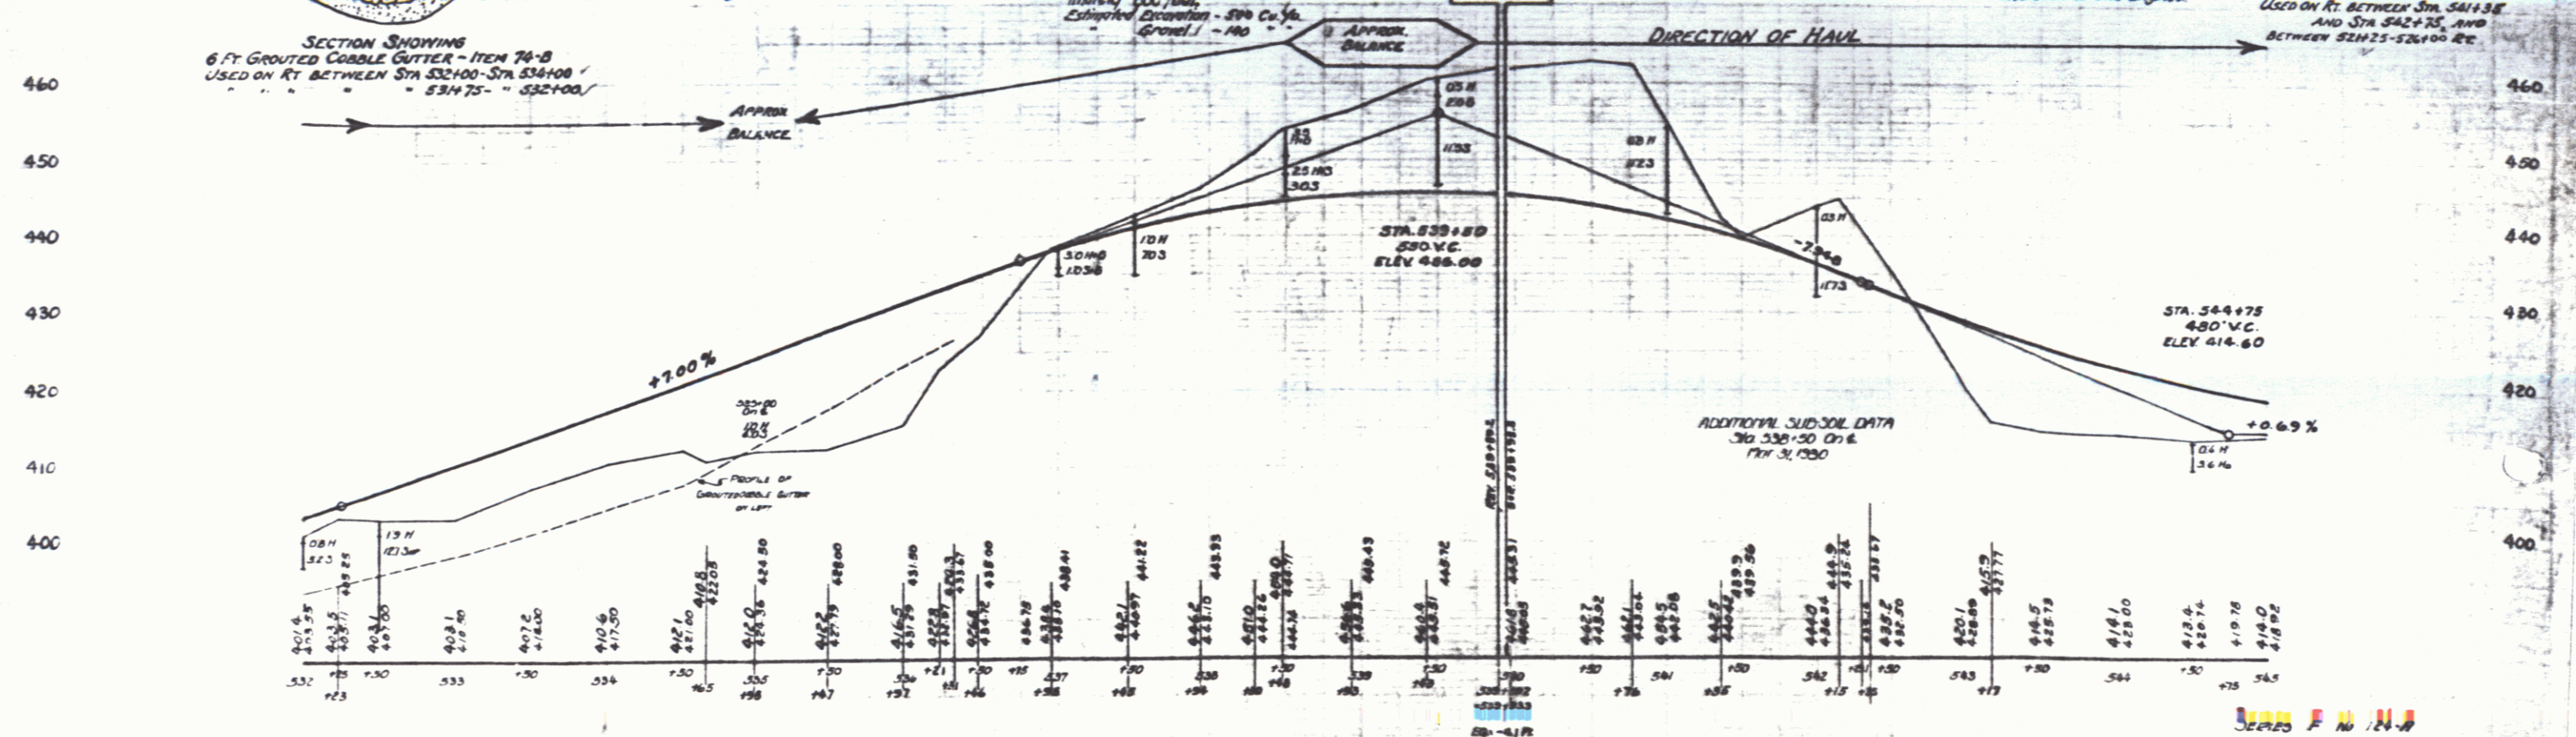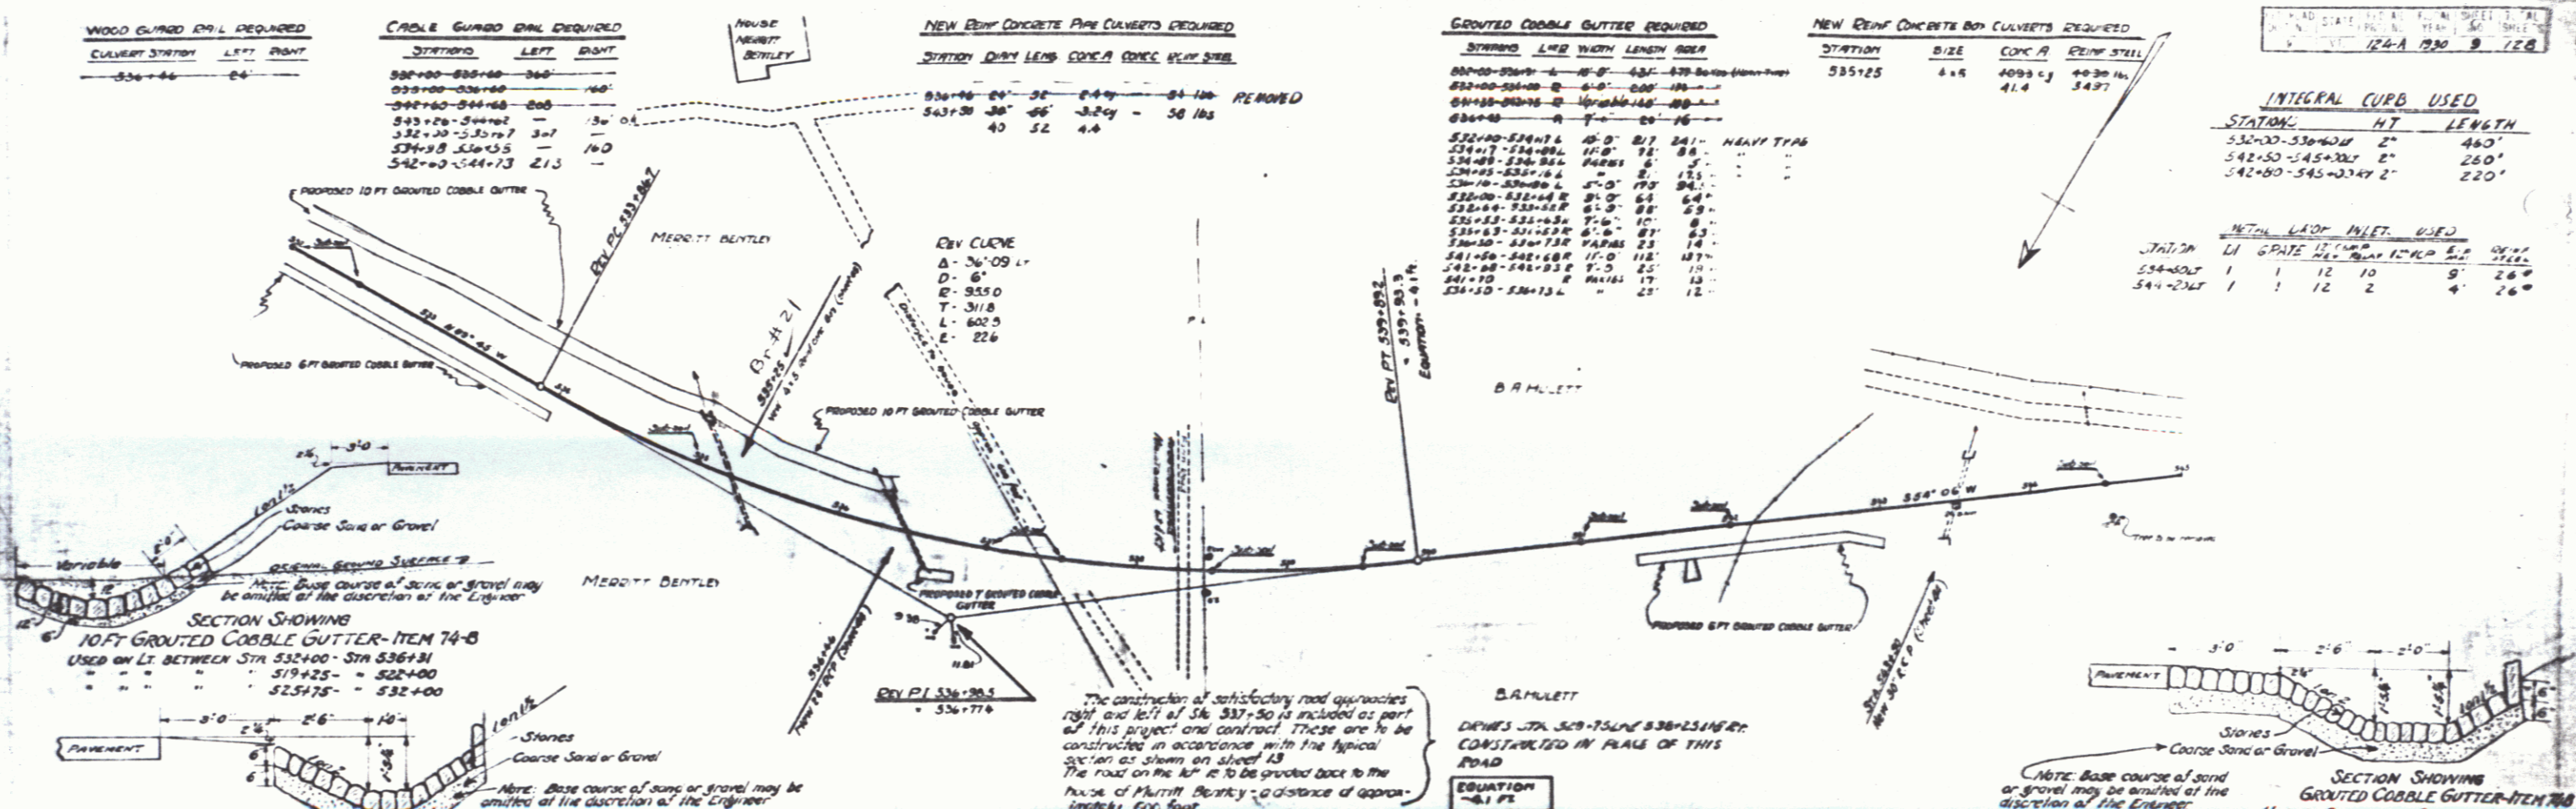

Sheet 12 of 128