

WOOD GUMMED DRILL REQUIRED

CLASSIFY STATION	LEFT	RIGHT
336+75	24'	24'
366+30	24'	24'

NEW REINFORCED CONCRETE PIPE CULVERTS REQUIRED



STATION	DEPTH	LENGTH	DIAMETER	NO. OF	PILES
336+75	18"	30'	48"	3	3
366+30	18"	40'	36"	3	3

CONCRETE PIPE CULVERTS REQUIRED

STATION	DEPTH	LENGTH	DIAMETER	NO. OF	PILES
307+43	18"	30'	48"	3	3
308+00	18"	30'	48"	3	3
313+00	18"	14'	48"	3	3
316+65	18"	34'	48"	3	3
327+30	18"	24'	48"	3	3
365+30	18"	30'	48"	3	3

(20' pile in, removed because too short)

DIST. NO.	STATE	FED. AID	FISCAL YEAR	DATE
1	V	724-A	79-80	11

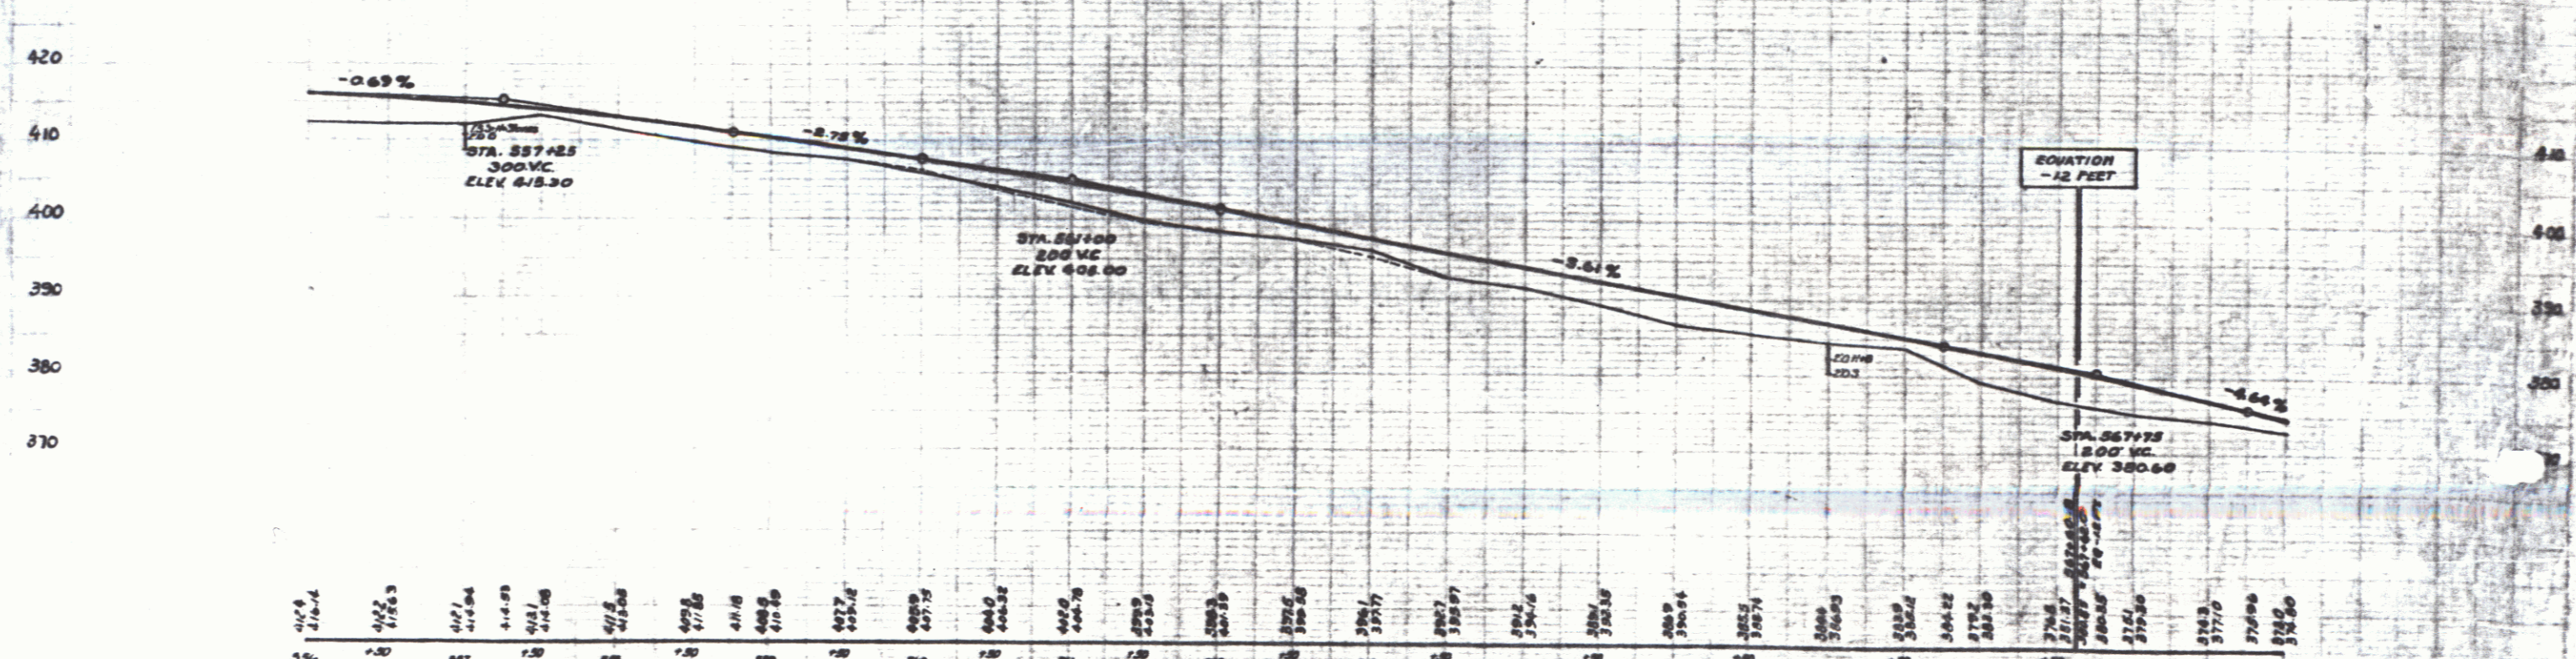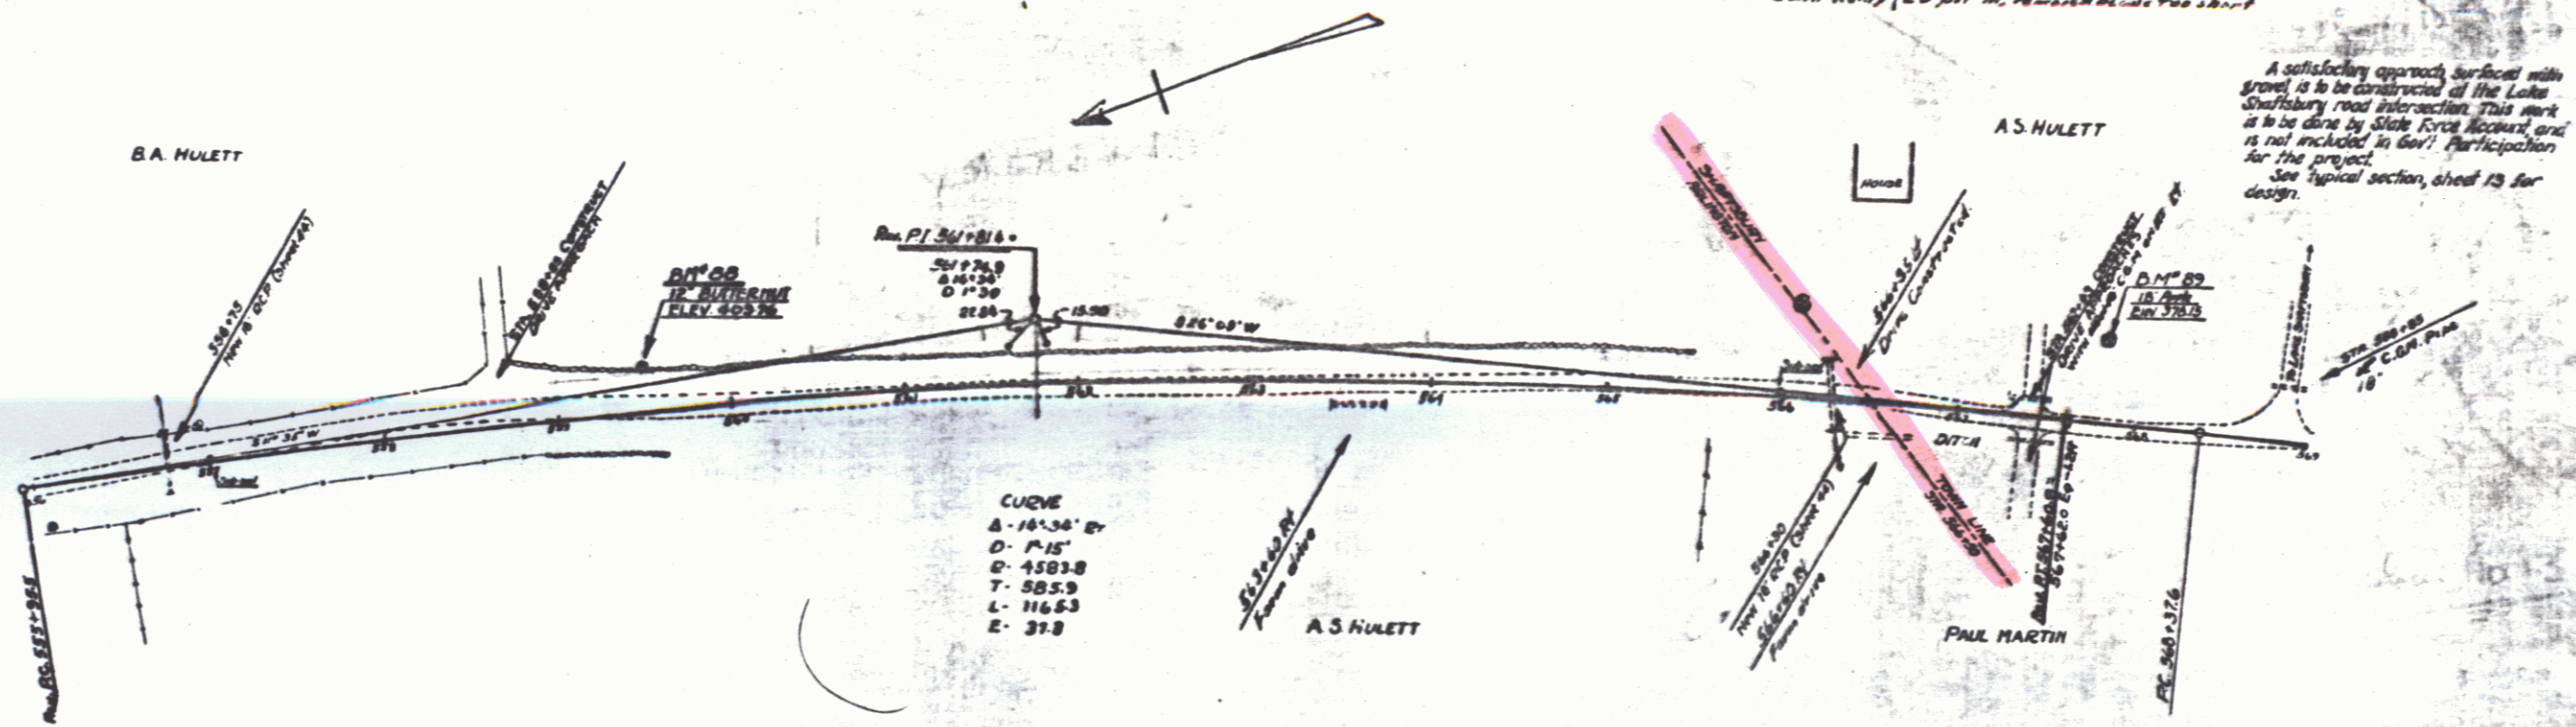

350+ 351+ 352+ 353+ 354+ 355+ 356+ 357+ 358+ 359+ 360+ 361+ 362+ 363+ 364+ 365+ 366+ 367+ 368+ 369+ 370+ 371+ 372+ 373+ 374+ 375+ 376+ 377+ 378+ 379+ 380+

D.M. 88 SPIKE IN CROWN OF 18" DUTTERAUX 16' LT. STA 369+80 - ELEV 409.76
 D.M. 89 SPIKE IN CROWN OF 15" PIPE, 42' LT. STA 367+80 - ELEV 378.15

Sheet F 10124-B
 Sheet 8 of 128

9