

WOOD GUIDE CABLE REQUIRED

STATION	LEFT	RIGHT
624+00	24'	24'
625+00	24'	24'

CABLE GUIDE CABLE REQUIRED

STATION	LEFT	RIGHT
614+00-619+00	200'	200'
617+00-619+00	-	-

NEW BENCH MARKS FOR CABLES REQUIRED

STATION	LEFT	RIGHT
625+00	18'	18'
625+00	18'	18'
625+00	18'	18'


EXISTING CABLES CABLES REQUIRED

STATION	LEFT	RIGHT
625+00	18'	18'
625+00	18'	18'

ROADWAY PAVEMENT CABLES REQUIRED

STATION	LEFT	RIGHT
625+00	18'	18'
625+00	18'	18'

DIST. NO.	STATE	FILE NO.	YEAR	NO.	SHEET
1	VT.	124-A	1930	14	128

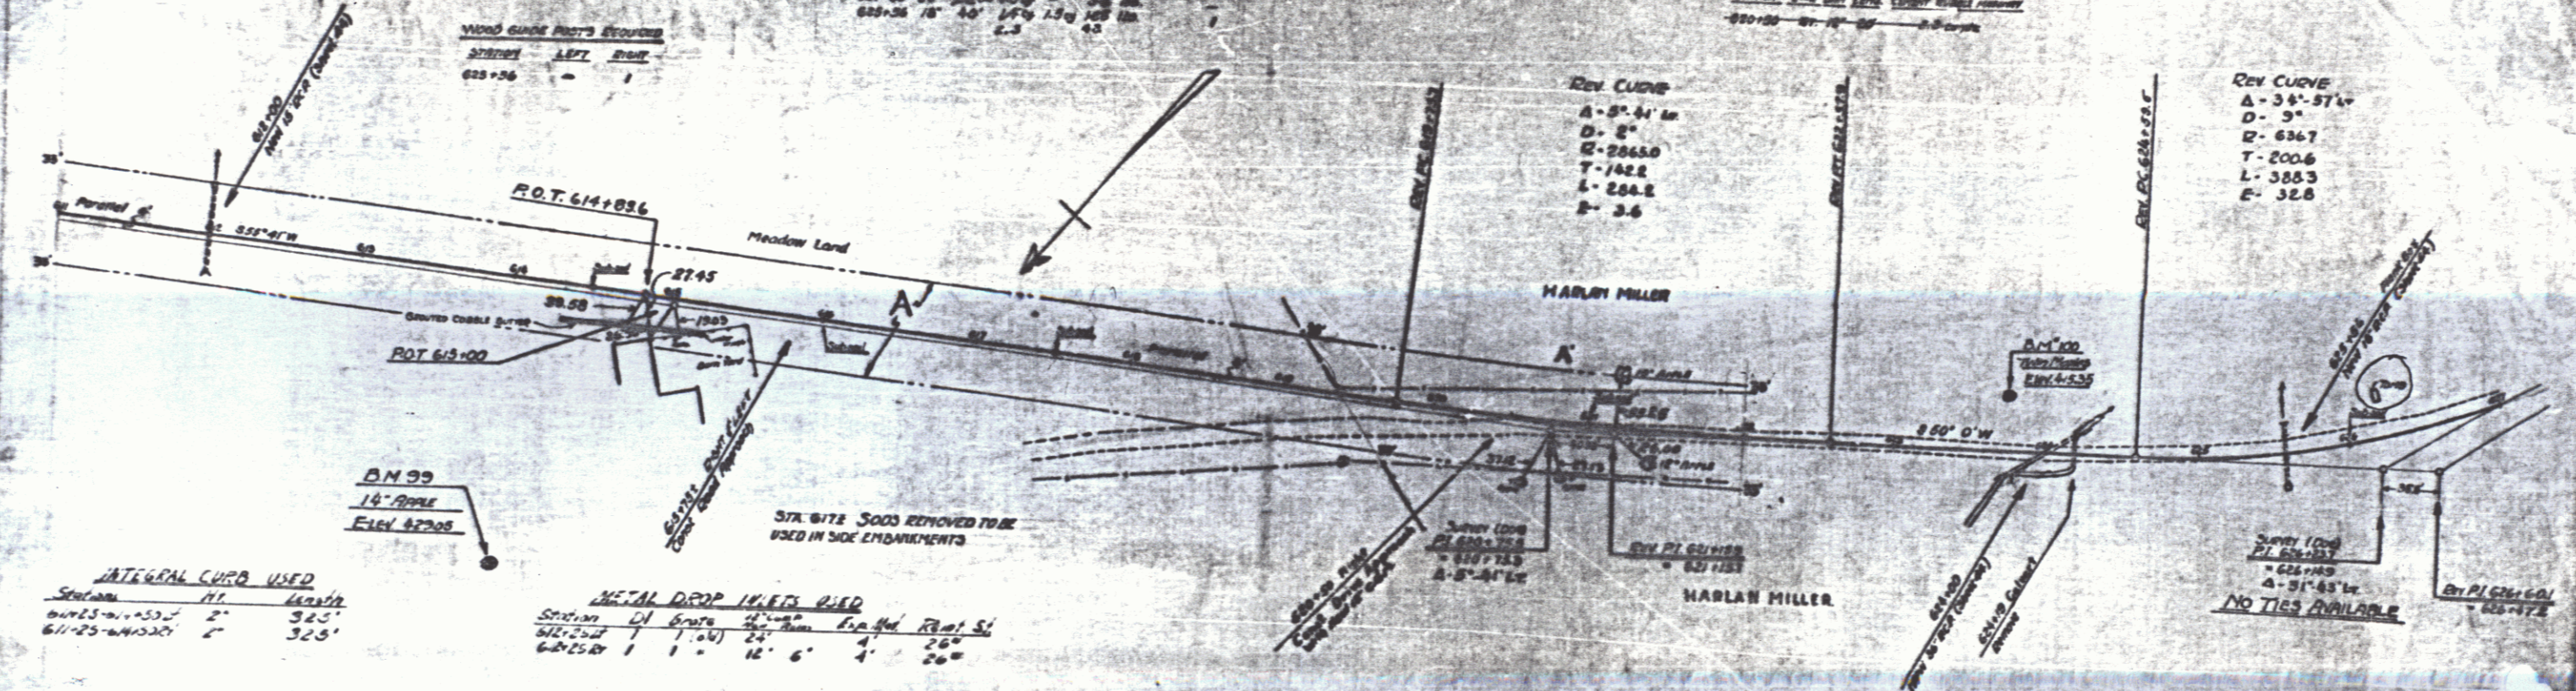


INTEGRAL CURVE USED

Station	HI	LO
614+50	2'	32.5'
617+50	2'	32.5'

METAL DROP MARKS USED

Station	HI	LO
614+50	1'	16.6'
617+50	1'	16.6'

PACEL	INSTRUMENT	GRANTOR	GRANTEE	RECORDED	REMARKS
A	QCD	1/15/30	RUTH MATTISON	TOWN OF SHRAFTSBURY	5K PAGE 1/30/30
K	QCD	1/11/30	HARLAN MILLER	TOWN OF SHRAFTSBURY	3P PAGE 1-21-30

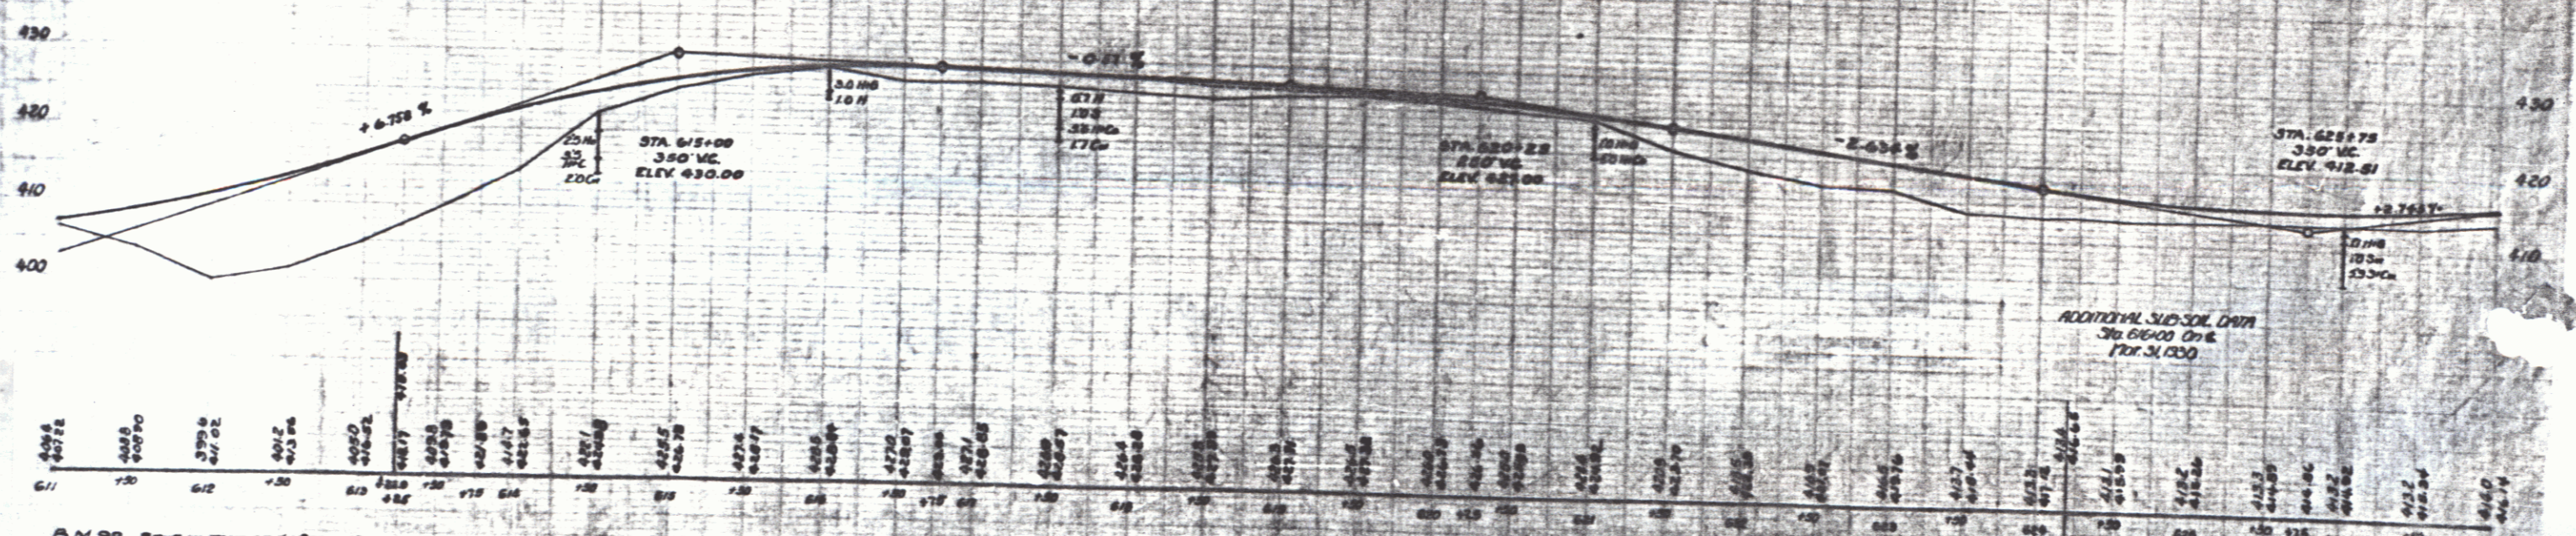

B.M. 99 SPIKE IN ROOT OF 1/4 APPLE, 180 FT. OFF 616 MC. ELEV. 429.00
 B.M. 100 SPIKE IN ROOT OF THIN MAPLE, 31 FT. 12 OF 378 411 MC. ELEV. 415.35

PLANS COMPLETED

NO.	DATE
1	1/15/30
2	1/17/30
3	1/19/30
4	1/21/30

Checked by 126-UP
 Sheet 14 of 128