

WOOD CURVED BRACKETS REQUIRED

CHORD STATION	LEFT	RIGHT
627+80	26'	26'
636+80	26'	26'

WALL GUIDE POSTS REQ'D

STATION	LEFT	RIGHT
631+00	N	Z

CIRCLE CURVED BRACKETS REQUIRED

SITUATION	LEFT	RIGHT
625+72 - 630+80	26'	26'

NEW CURVE QUOTE FOR CURVES PROVIDED

STATION	LEFT	RIGHT
627+80	26'	26'
636+80	26'	26'


NEW CURVE QUOTE FOR CURVES PROVIDED

STATION	LEFT	RIGHT
630+20	21'	21'


CONVENTION FOR CURVES REQUIRED

STATION	LEFT	RIGHT
630+20	21'	21'

NO.	STATE	FED. AID	FISCAL	SHEET
D.		PROG. NO.	YEAR	NO.
1	VI	24-1	1969	2

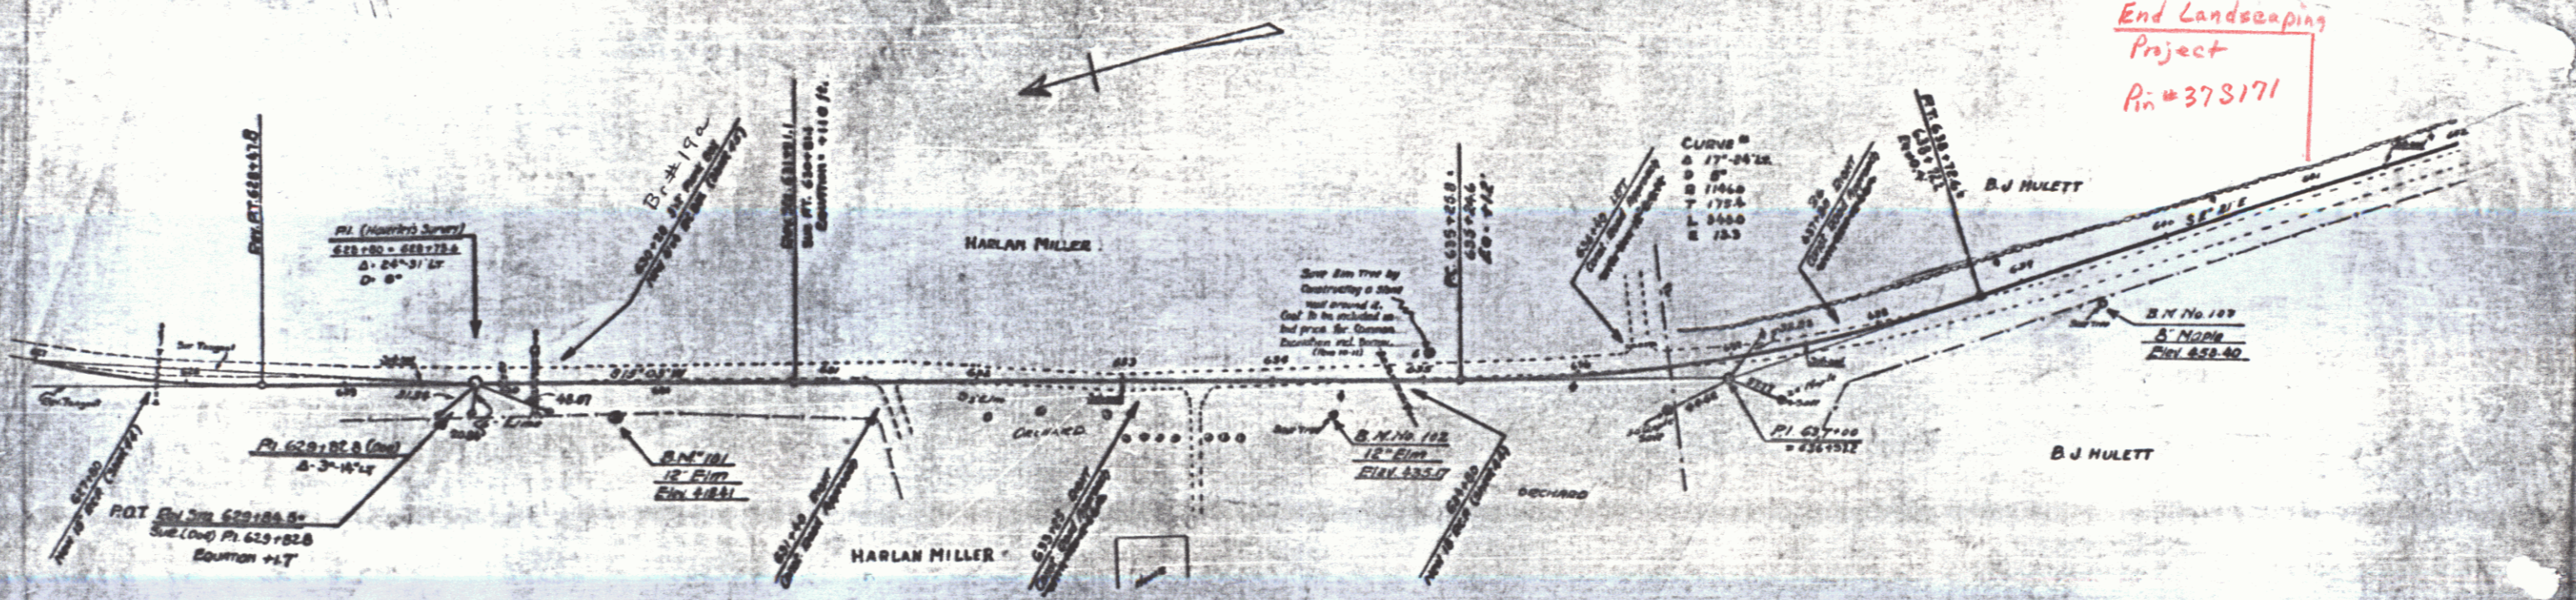

End Landscaping Project
P# 378171

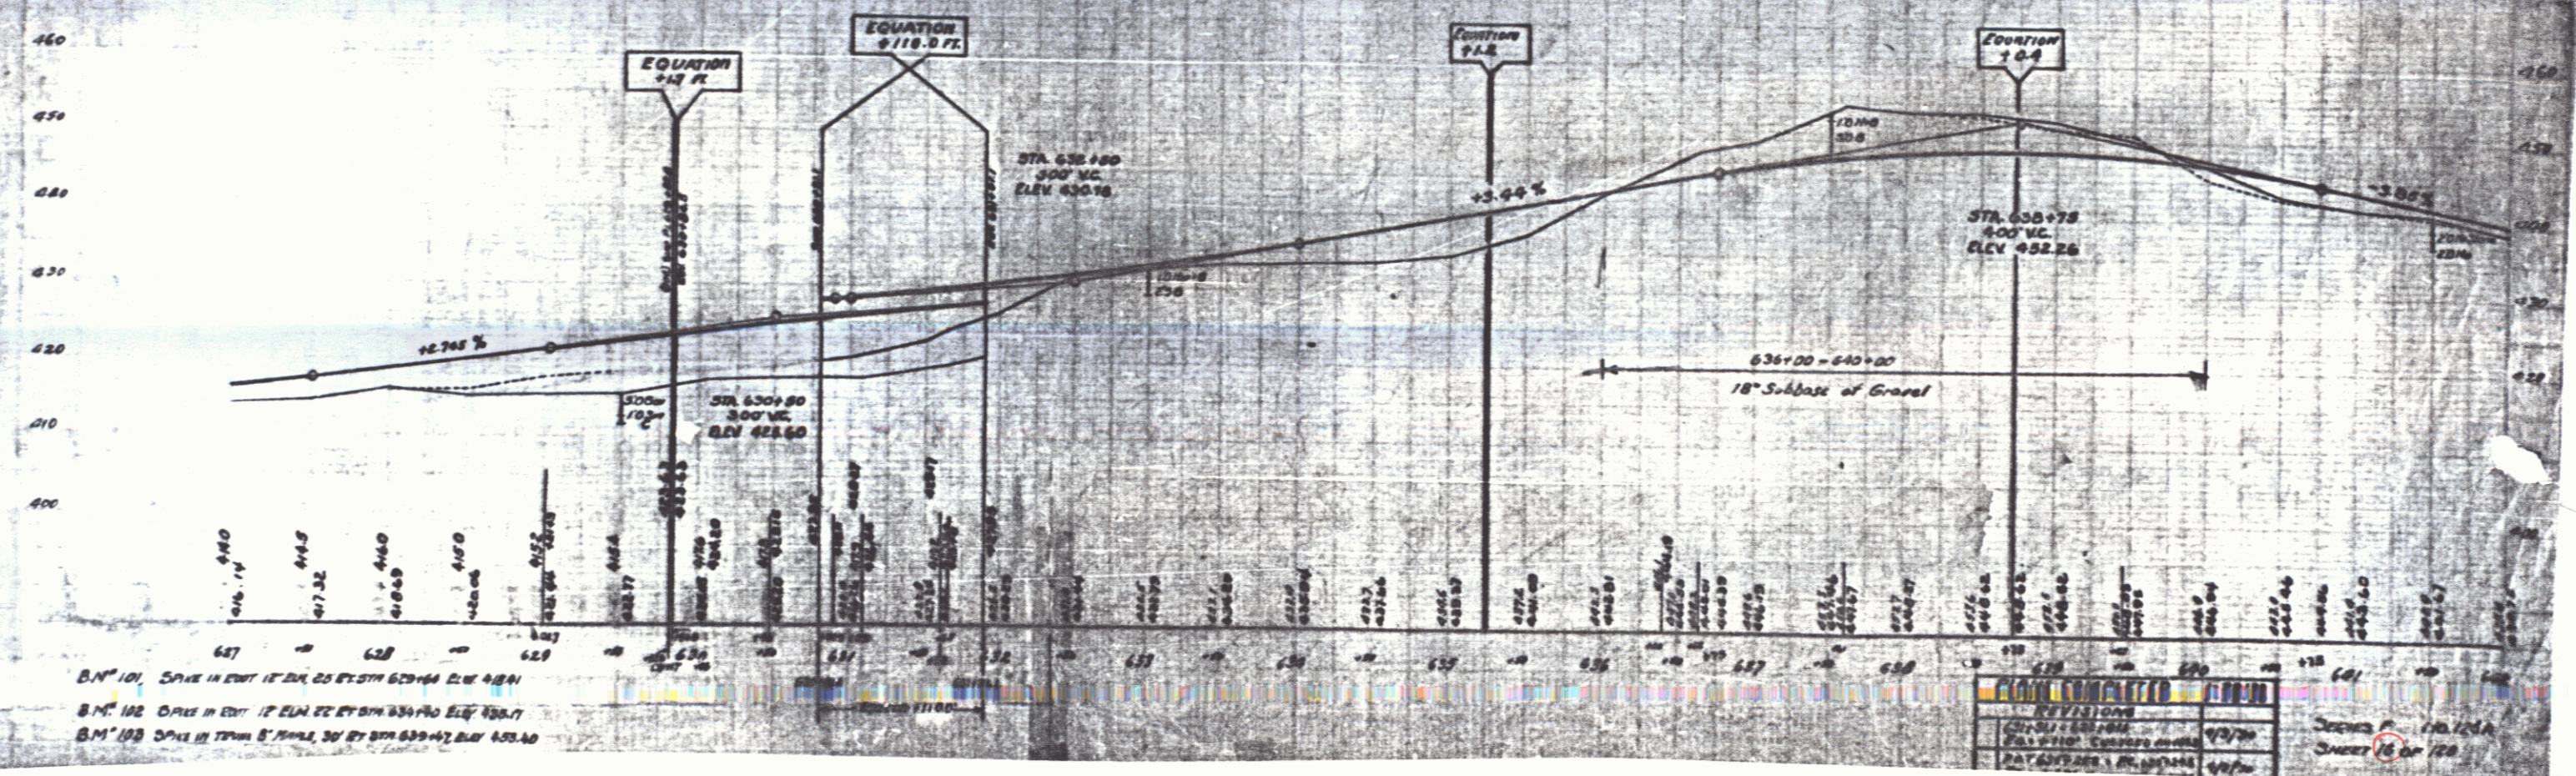

B.M. 101, SPK 14 1/2" DIA. 25' BY STA 629+64 ELEV 428.41
 B.M. 102, SPK 14 1/2" DIA. 25' BY STA 630+70 ELEV 430.7
 B.M. 103, SPK 14 1/2" DIA. 25' BY STA 639+42 ELEV 435.50

NO.	DATE	BY	REVISION
1	10/20/68	J.M.	DESIGN
2	11/10/68	J.M.	CONSTRUCTION