

**WOOD BOUND EPH. REQUIRED**

CURVE	START	LEFT	RIGHT
733+34	04'	04'	

**GRAVIT. CORRECTION REQUIRED**

STATION	TYPE	REMARKS	DATE
737+35	L	Revised	41 sp.
737+40	L	Revised	26 sp.
741+40	L	Revised	23 sp.



**NEW CURVE CORRECTIONS FOR CURVES REQUIRED**

STATION	TYPE	REMARKS	DATE
733+34	18'	24'	30 sp. 33 sp.

**CONCRETE FOR CURVES REQUIRED**

STATION	TYPE	REMARKS
737+35	L	23 sp. 24 sp.
737+40	L	Revised - 20 sp. 21 sp.
741+40	L	21 sp. 22 sp.
741+45	L	20 sp. 21 sp.
743+40	L	20 sp. 21 sp.
733+35	L	22 sp. 23 sp.

STATE OF MISSISSIPPI  
 DIVISION OF HIGHWAYS  
 PROJECT NO. 128-A  
 SHEET 22 OF 128

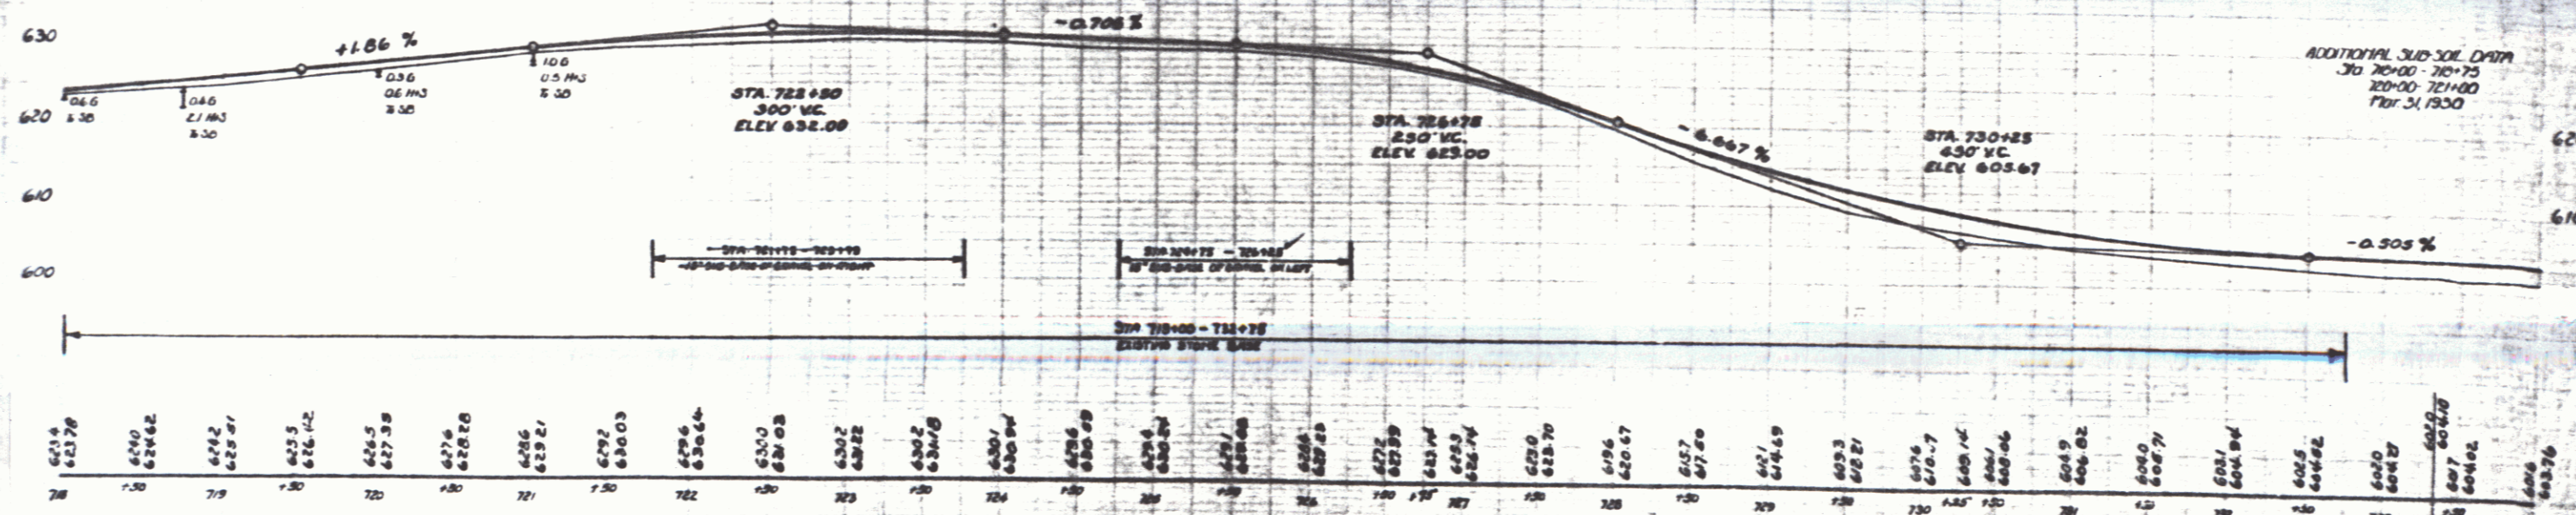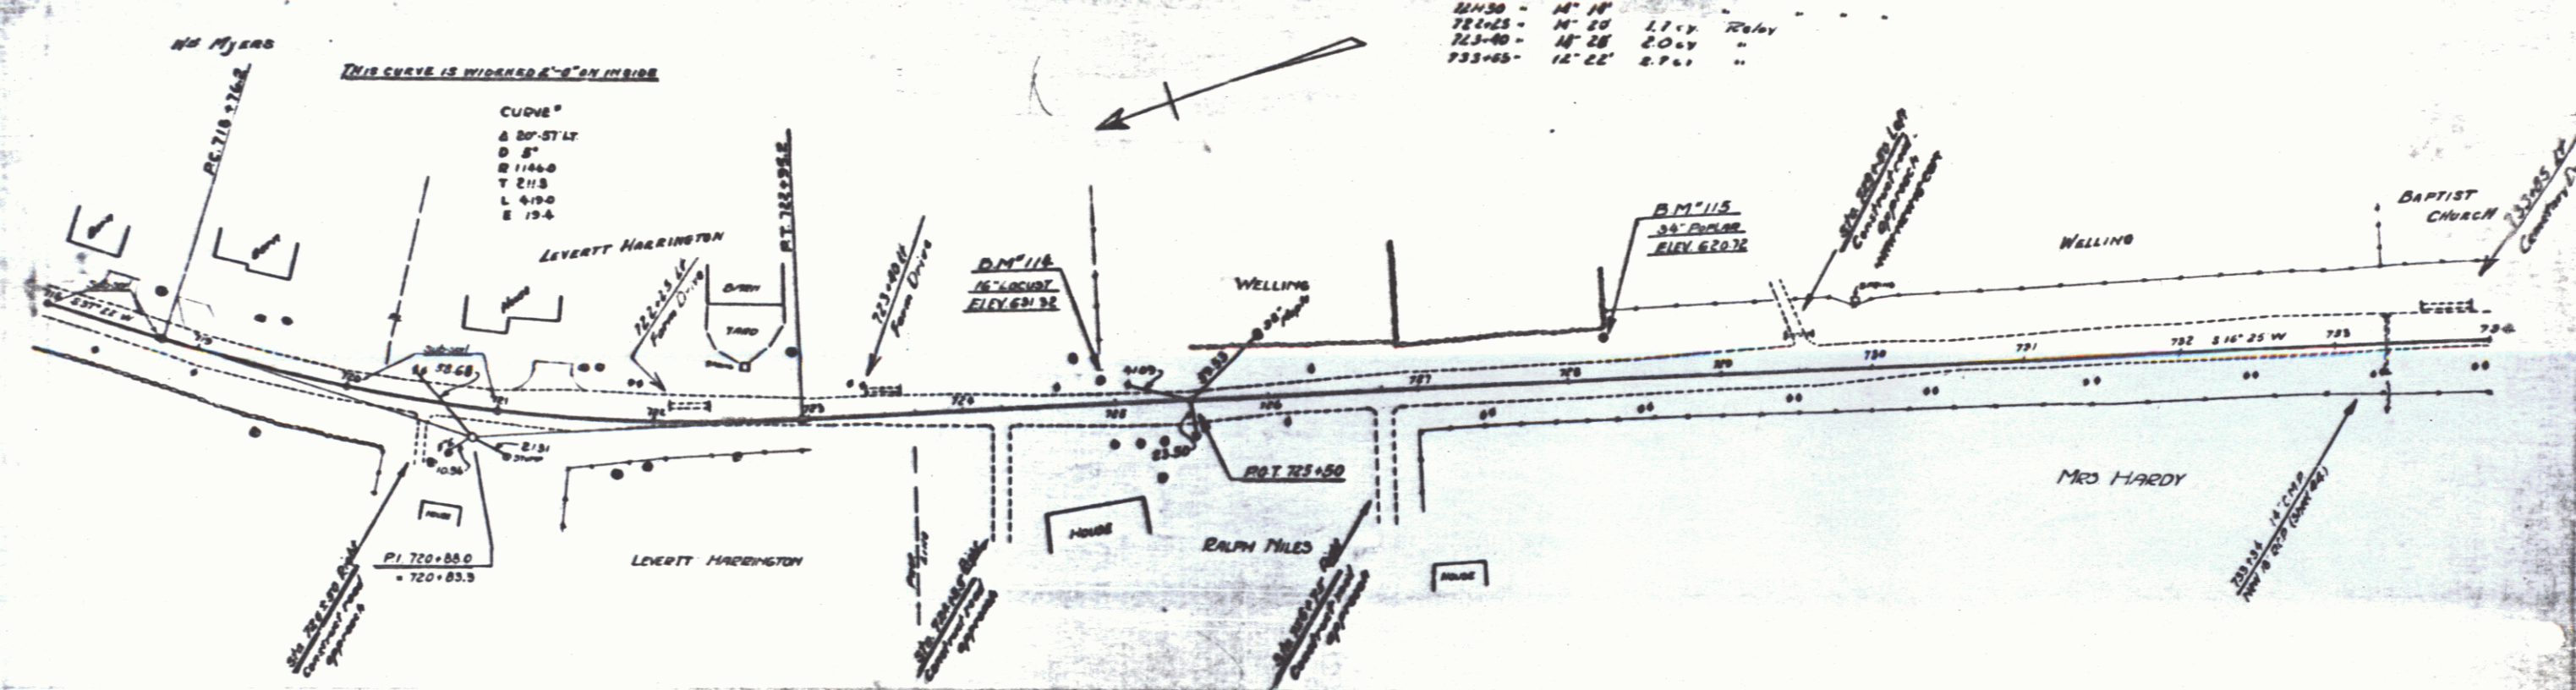

B.M. 114 36" DIAMETER 13' 11" STA 724+95 ELEV 631.32  
 B.M. 115 36" DIAMETER 24' 11" STA 728+25 ELEV 620.72

SERIES P. 128-A  
 SHEET 22 OF 128