
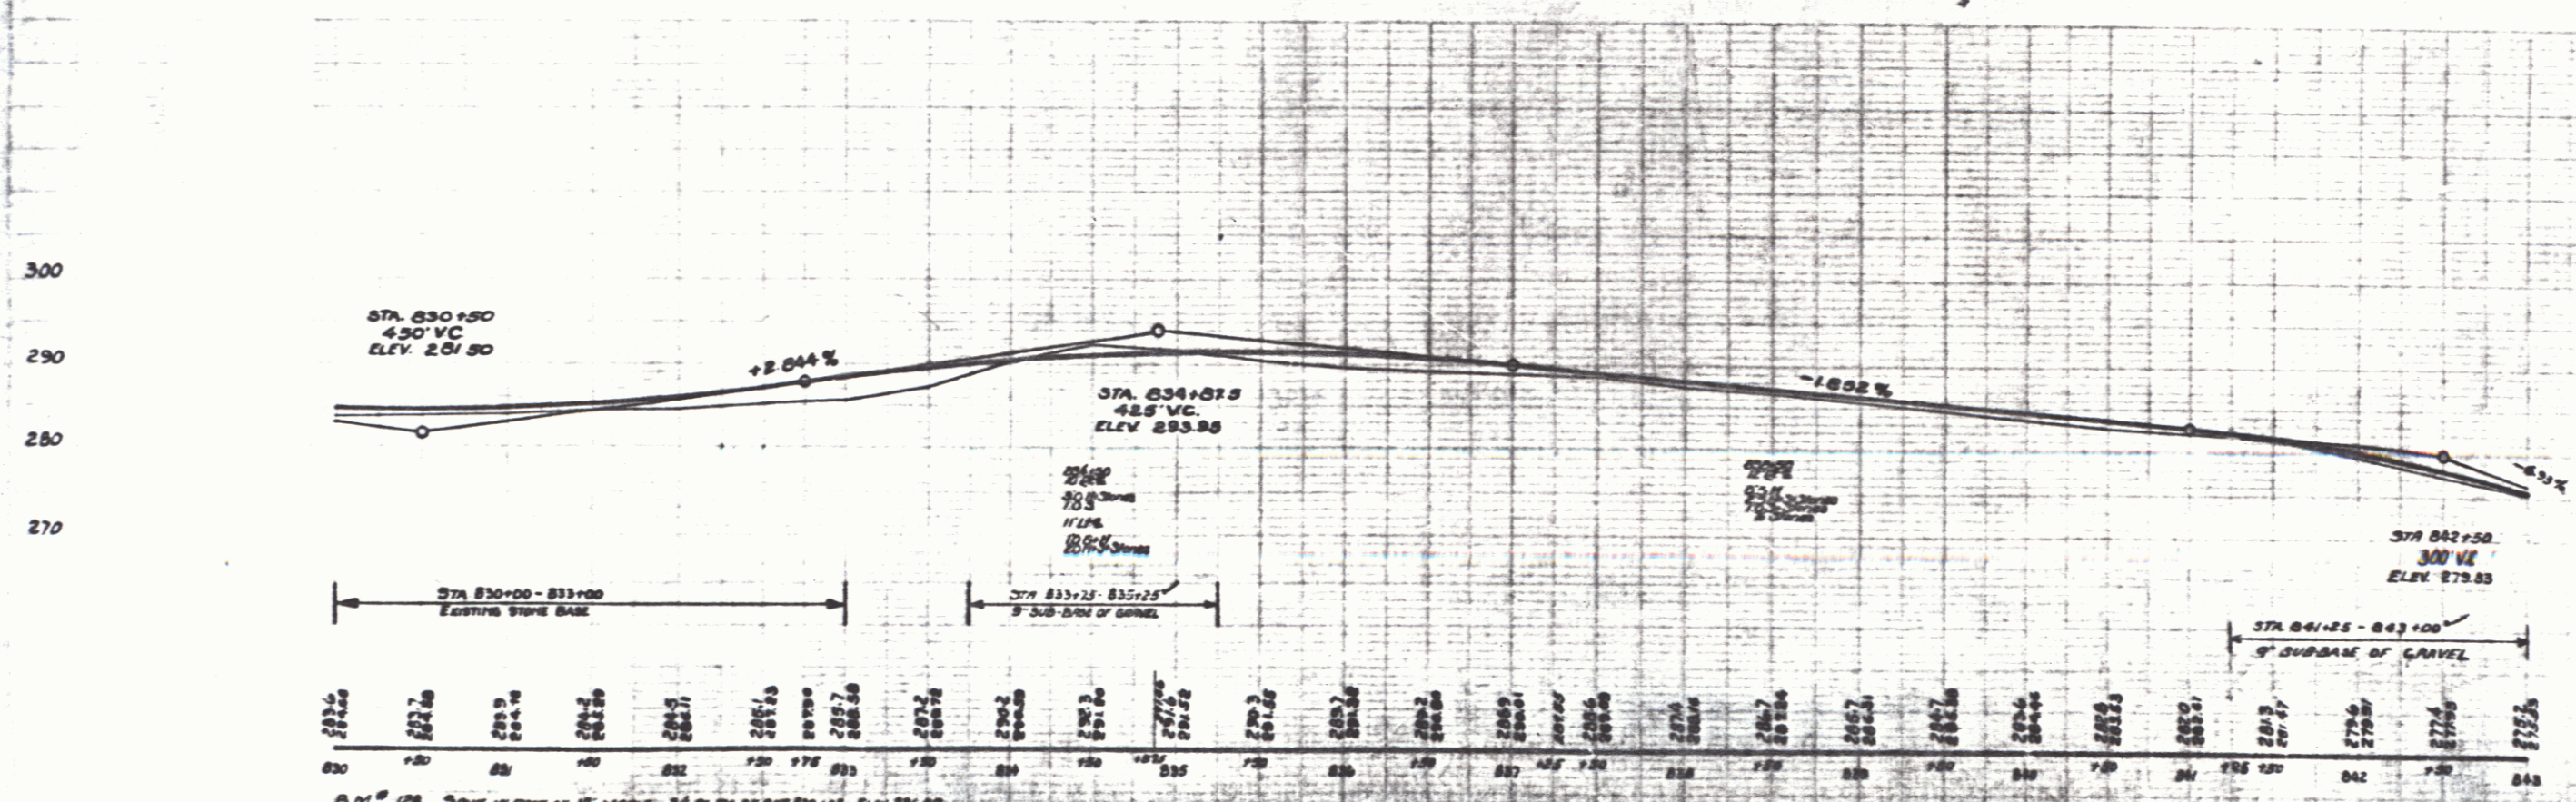


FILE NO. 124-A
 DATE 12-1-1930

EXISTING PIPE CONCRETS

STATION	SIZE	DEPTH	CONCRETE	REMARKS
841+10	18"	18"	2.1	2.1
833+25	18"	18"	2.1	2.1
836+10	12"	22"	2.0	2.0
833+53	12"	20"	2.0	2.0

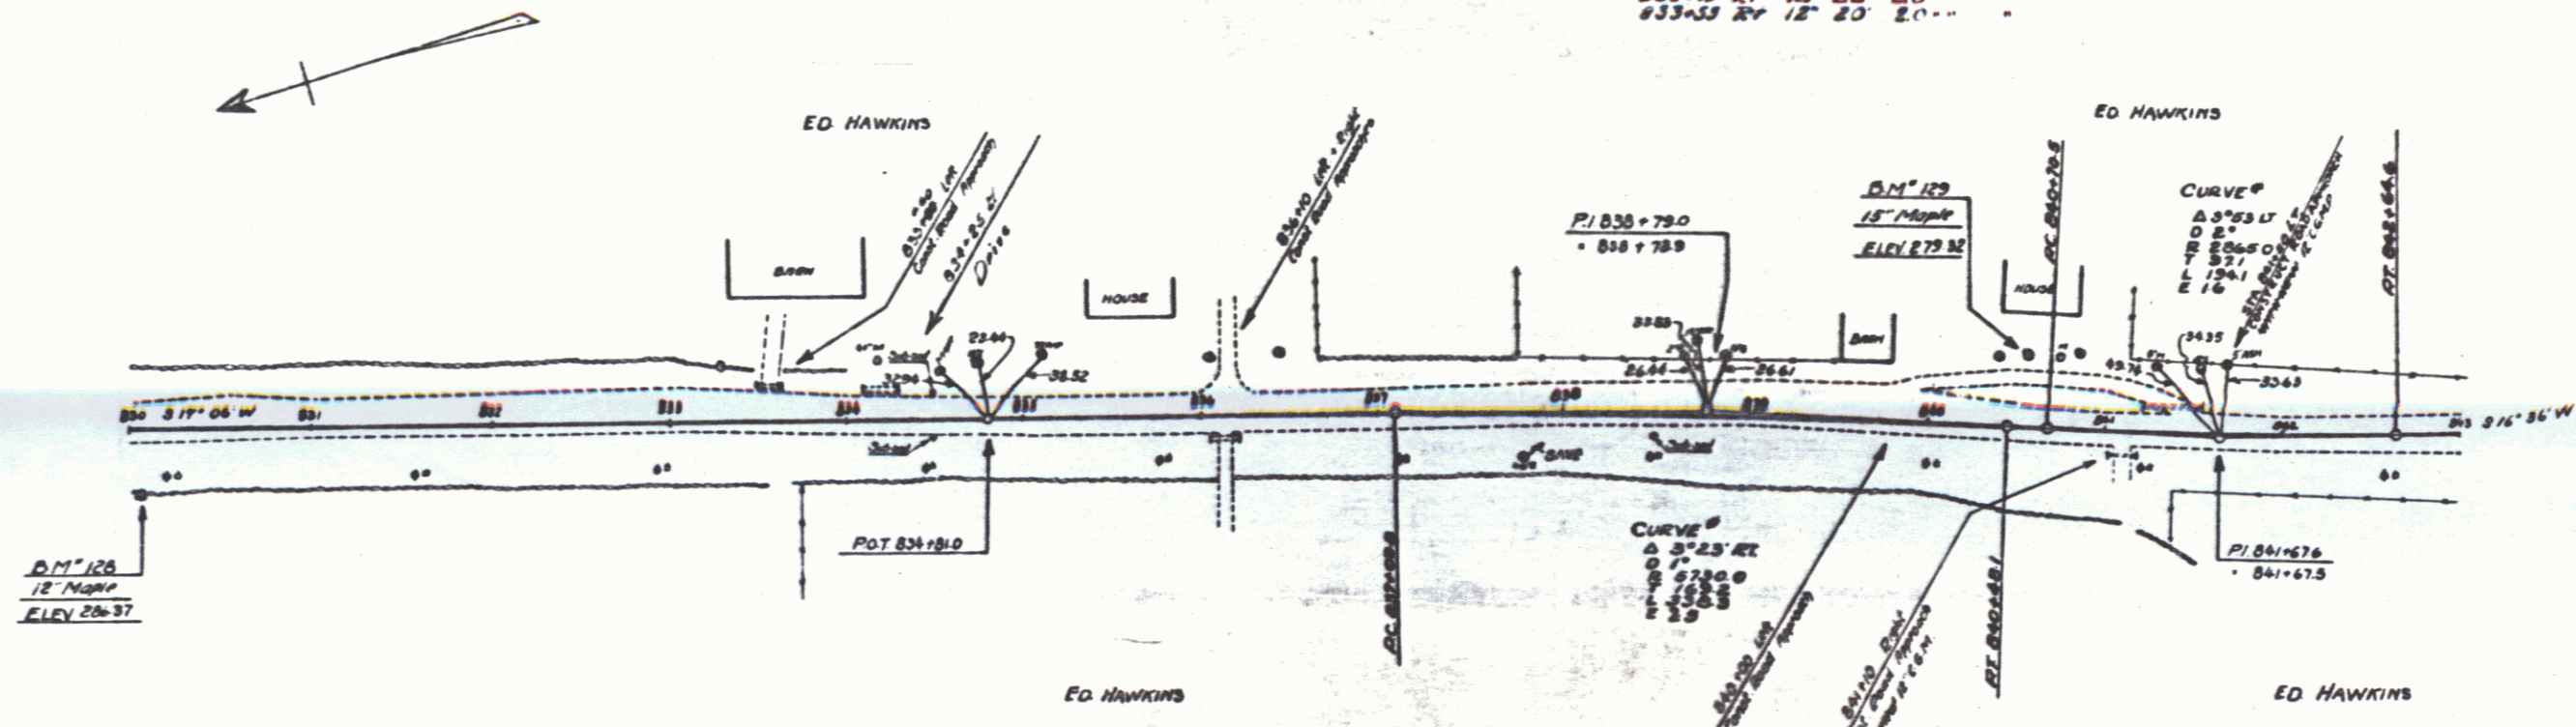

D.M. 128 34 FT. IN FOOT OF 12" MARK, 34 FT. W. OF STA. 830+00 - ELEV. 276.37
 D.M. 129 34 FT. IN FOOT OF 12" MARK, 34 FT. W. OF STA. 830+00 - ELEV. 279.32