

WOOD GUANO BARS REQUIRED

CULVERT SIZE	LEFT	RIGHT
36" x 36"	24	24



NEW 12" CONCRETE PIPE CULVERTS REQUIRED

STATION	DATE	LENGTH	CONCRETE	SMALL	SMALL
337+00	36"	36'	24	-	24

ROADWAY PIPE CULVERTS REQUIRED

STATION	DATE	LENGTH	CONCRETE	SMALL	SMALL
337+00	36"	36'	24	-	24

1244

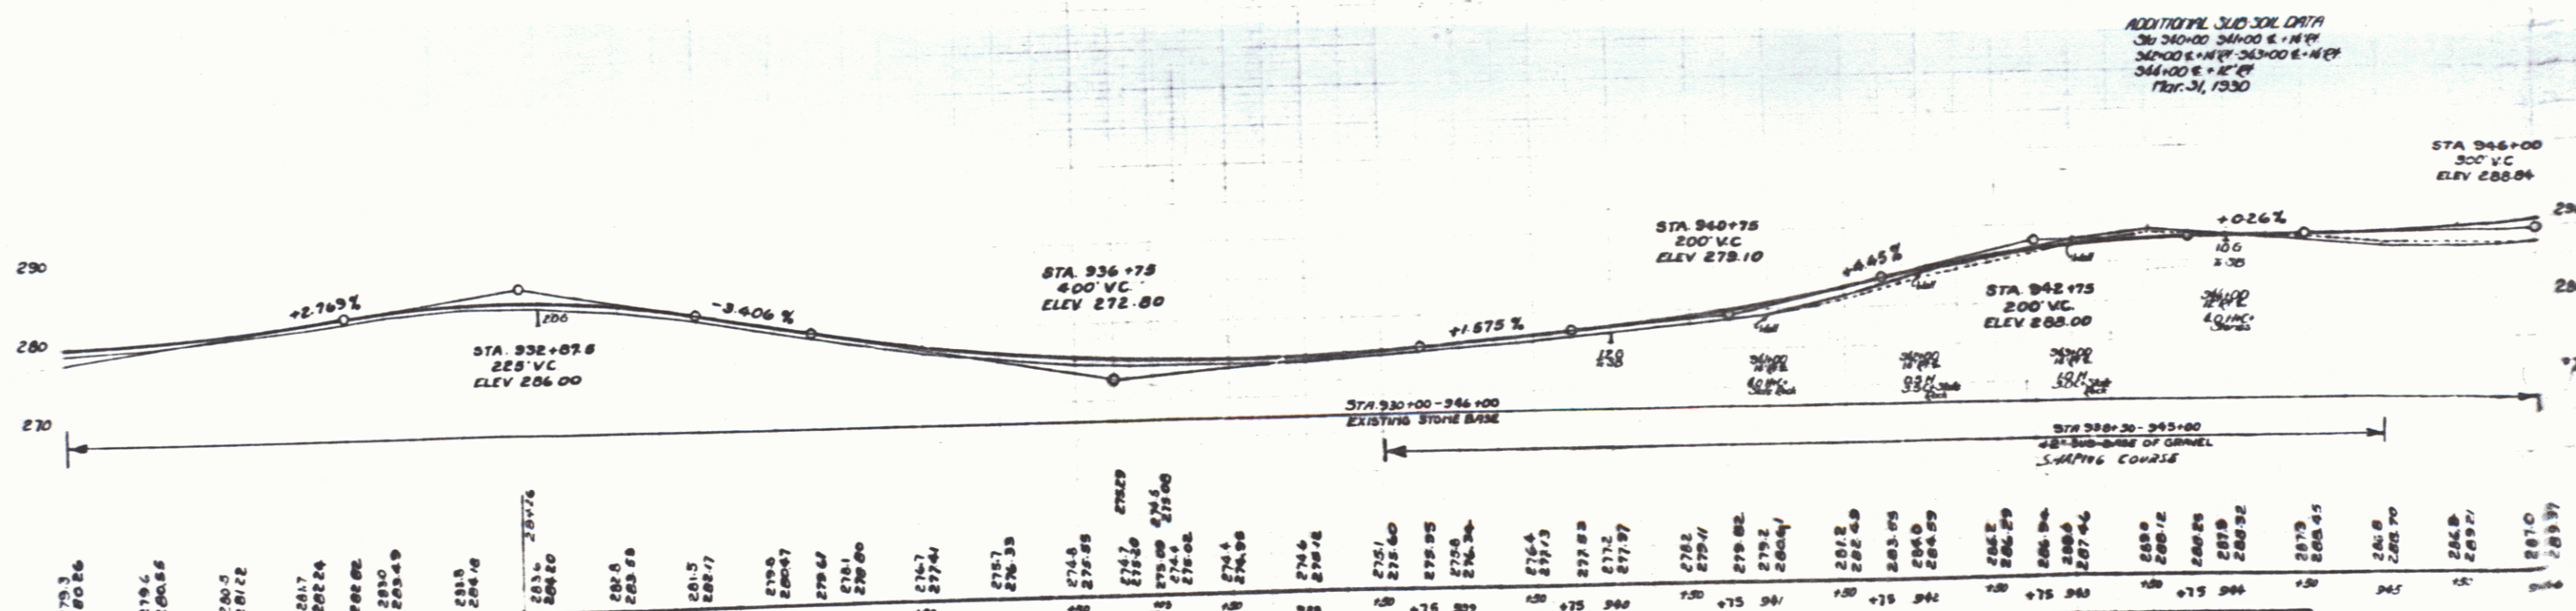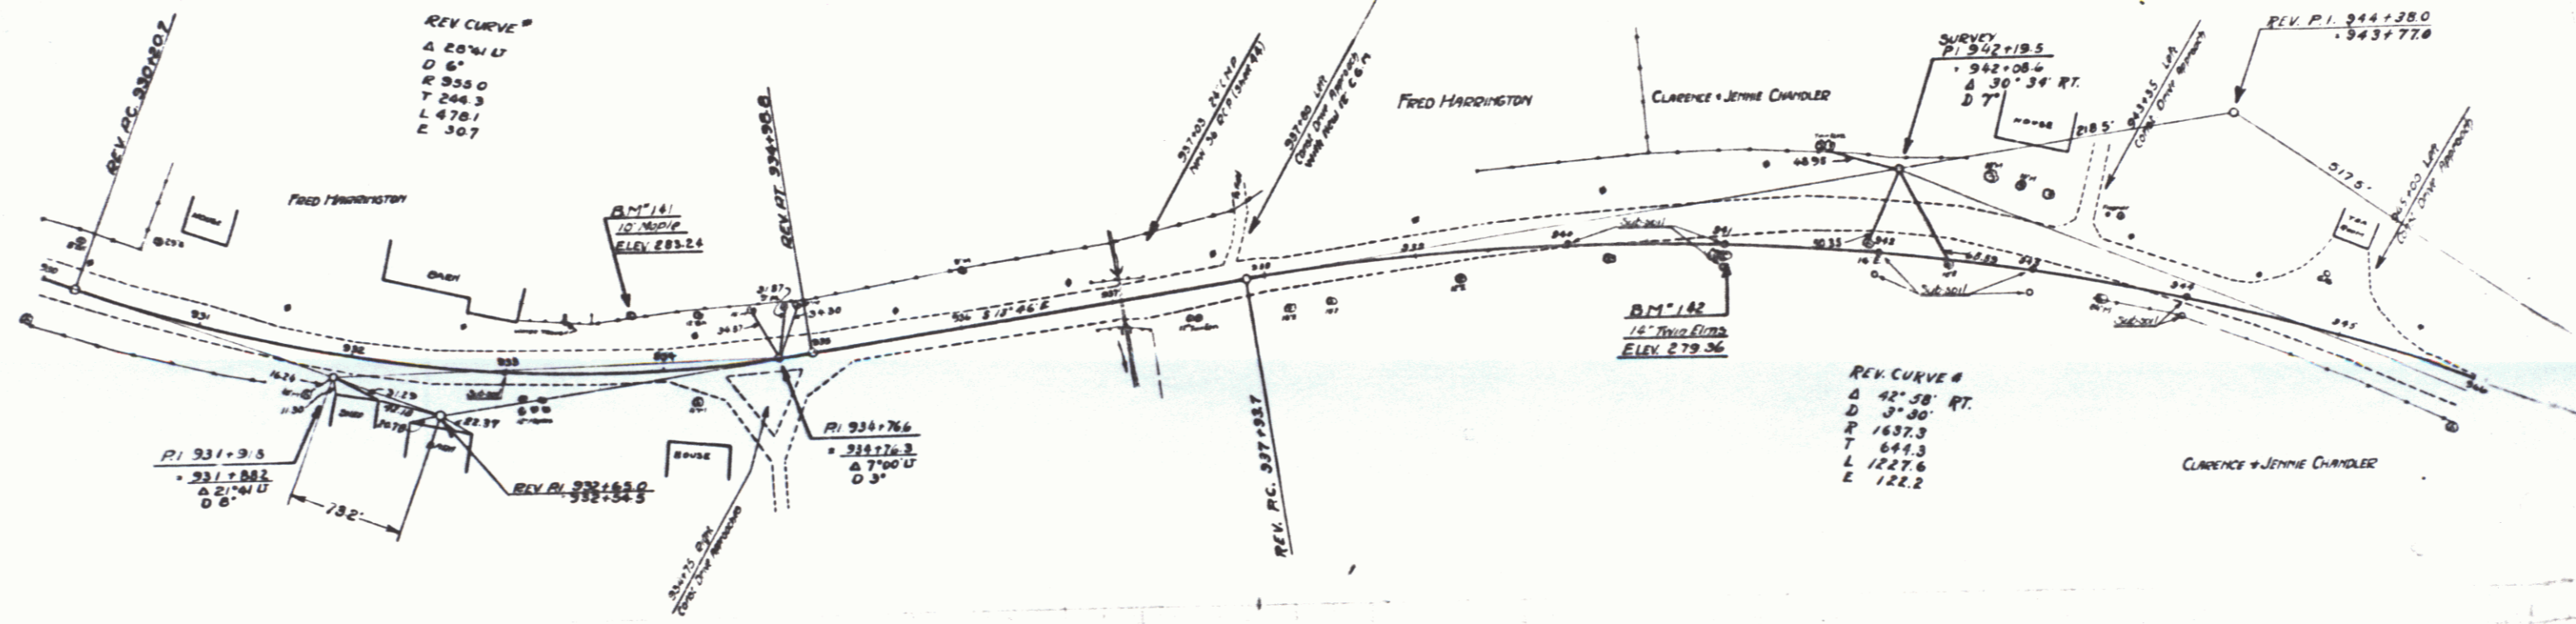

E.M. # 14 SPIKE IN ROOT OF BACKSIDE OF 10 MAPLE 387' LT OF STA 335+82 - ELEV 283.24  
 B.M. # 142 SPIKE IN ROOT OF 16" TWY ELMS 87' RT OF STA 340+36 - ELEV 279.36

PLANS COMPLETED	DATE
REVISIONS	
P.I. 335+65	7/10/30
	4-9-30

SERIES F 70 124-4  
 SHEET 20 OF 128