


ROAD GUIDE POSTS REQUIRED
 ULVERT STATION LEFT RIGHT
 1012+07

SHIMBOLD UNDERDRAIN WITH VARIATED LEAF PILE
 STATIONS FROM 1012+07 TO 1013+00 L 218'



SPOULED COBBLE GUTTER REQUIRED
 STATIONS FROM 1002+30 TO 1013+00 L 807'

DOWNWAY PIPE SUBVERTS REQUIRED
 STATION 1012+07

WOOD GUIDE POSTS REQUIRED
 STATIONS
 1002+11
 1012+03
 1014+35

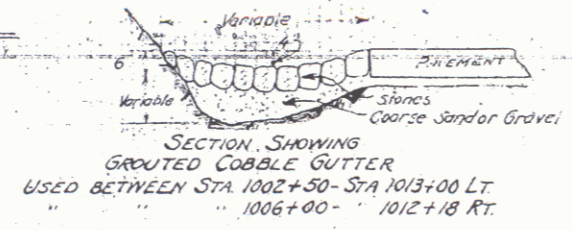

CURVE
 Δ 0°50' LT
 D 0°15'
 R 22920.0
 T 166.6
 L 333.2
 E 0.7

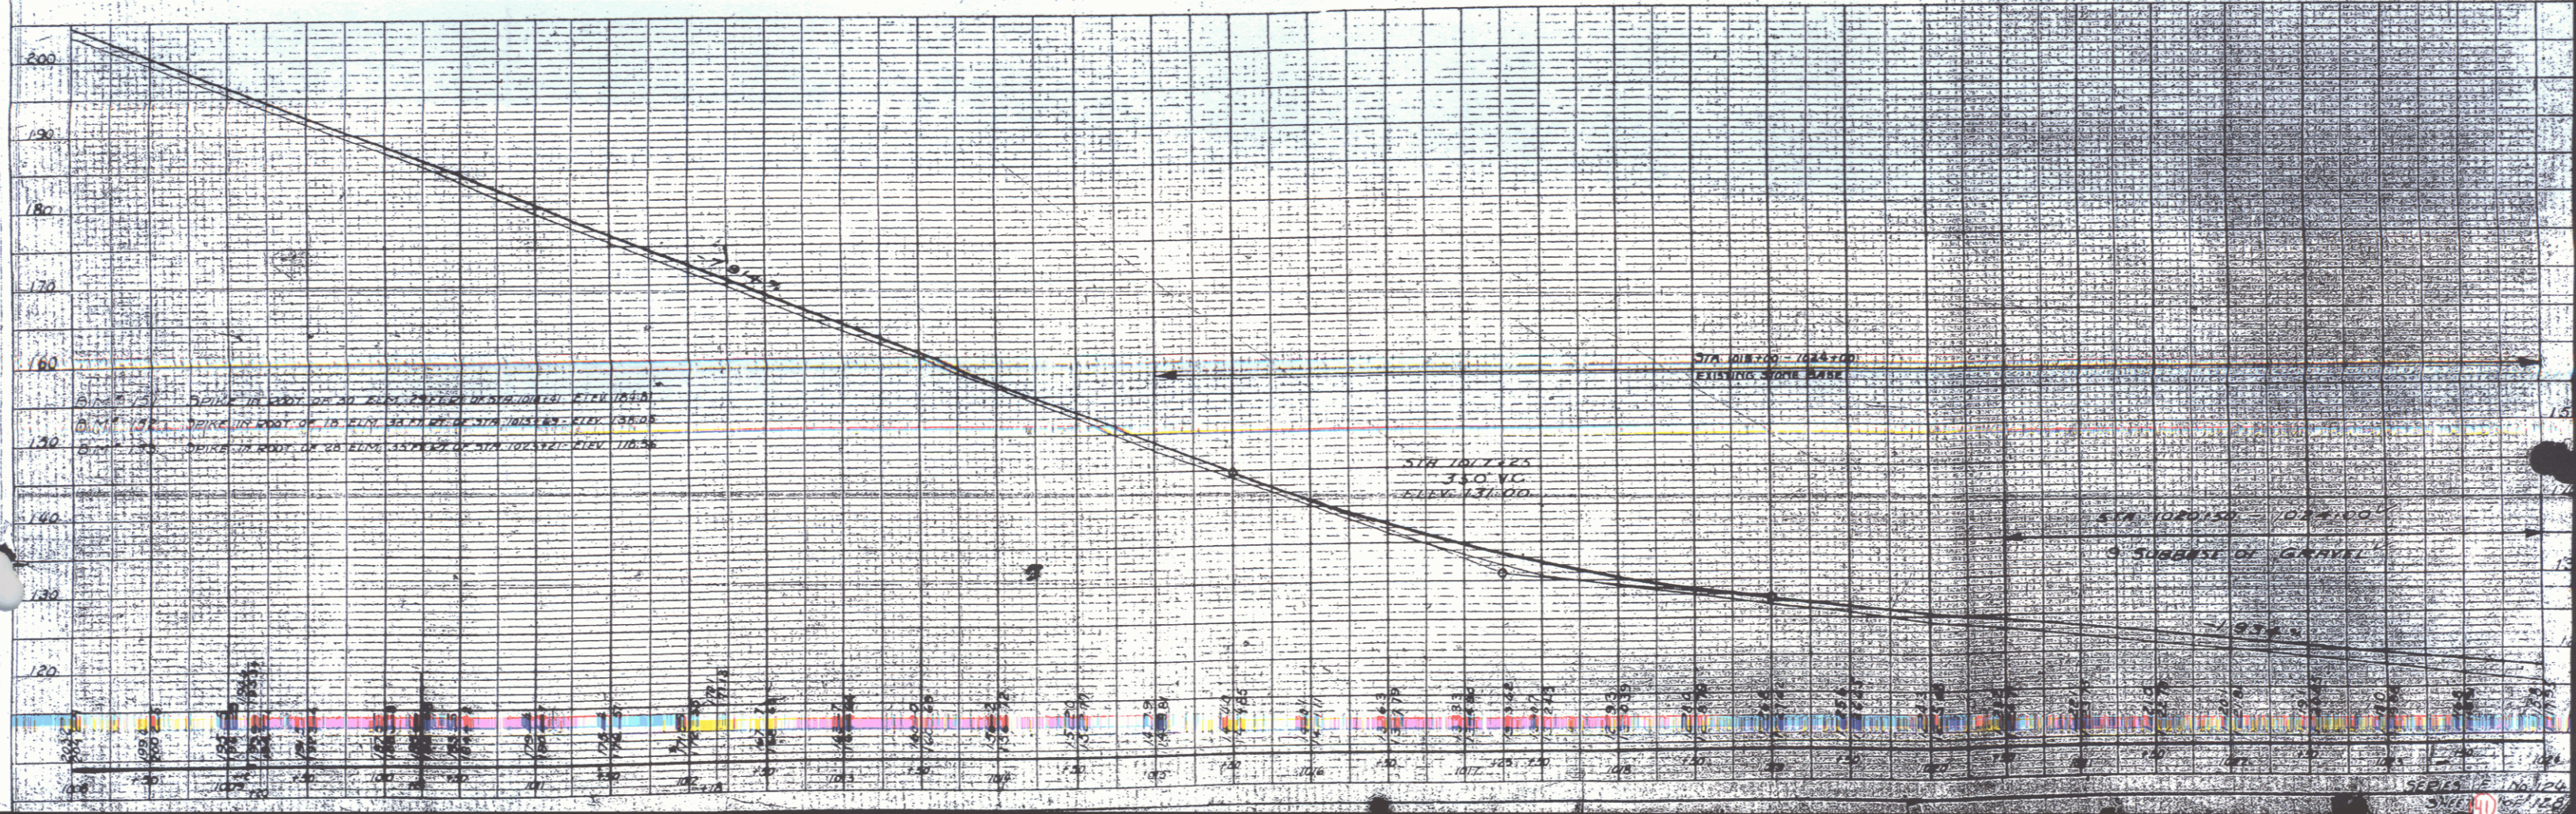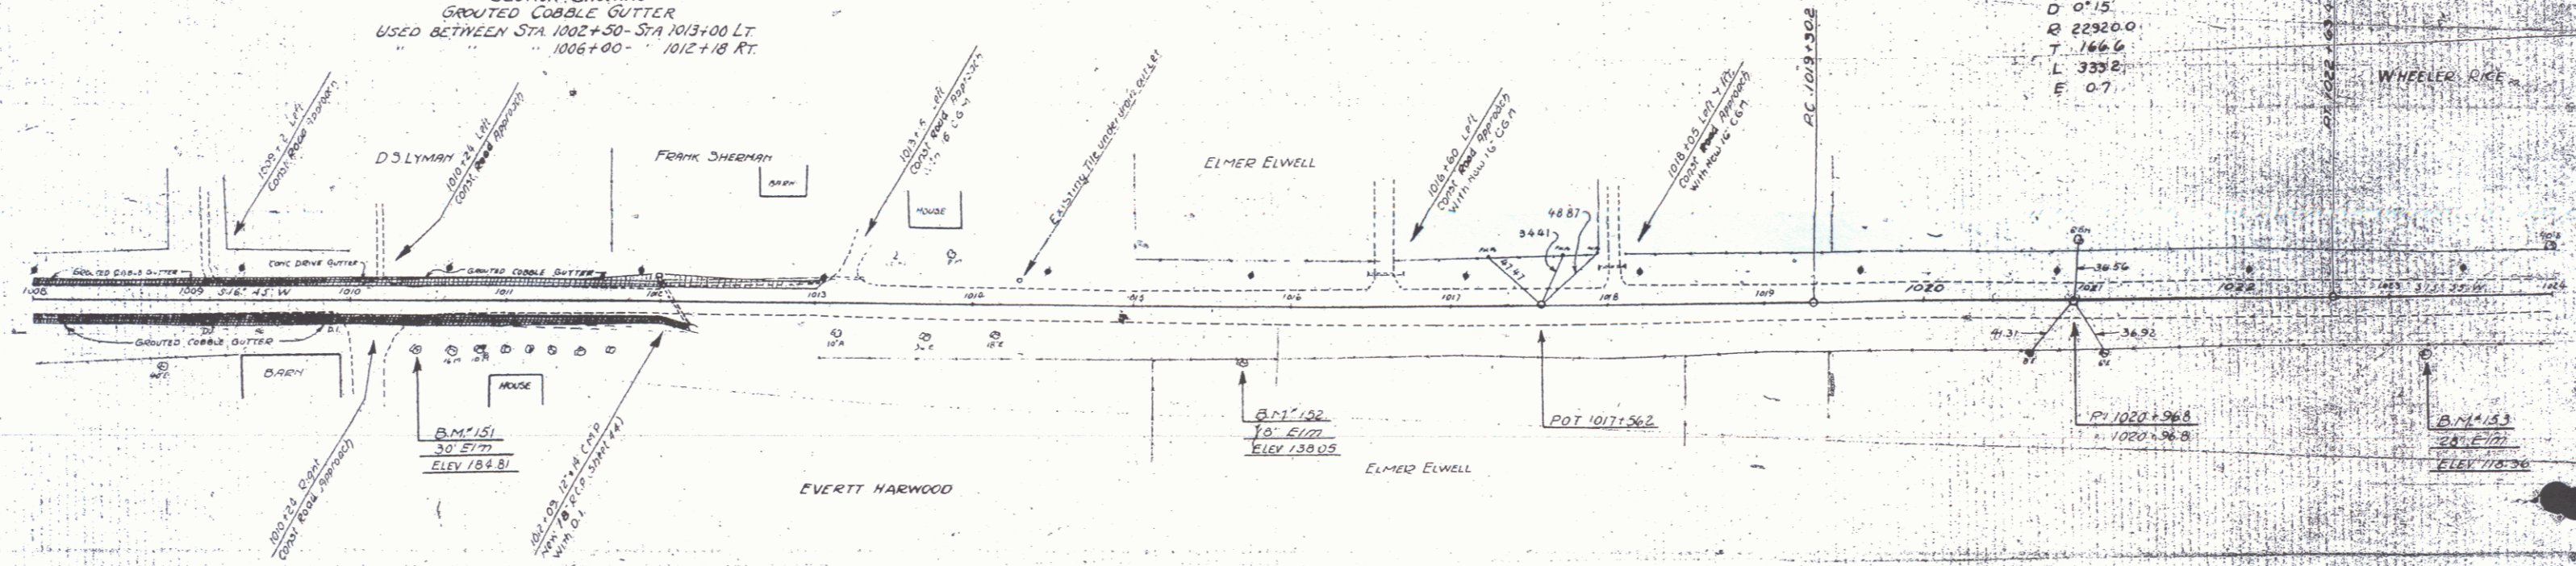

PLAN
 PROFILE
 SCALE
 1" = 40'