

WOOD GUTTER PITS REQUIRED  
 STATION LEFT RIGHT  
 1028+30 1 1  
 1034+50 1 1

CURVED GUTTER FINISHED  
 STATION LEFT RIGHT  
 1028+30 1 1  
 1034+50 1 1

CONCRETE CURB FOR LANDSCAPE  
 STATION LEFT RIGHT  
 1028+30 1 1  
 1034+50 1 1



CLAY PIPE REQUIRED  
 STATION LEFT RIGHT  
 1028+30 1 1  
 1034+50 1 1

GRADED CURB GUTTER  
 STATION WIDTH LENGTH AREA  
 1028+30 12' 2.3' 120.0  
 1034+50 12' 2.3' 120.0

WOOD GUTTER PITS REQUIRED  
 STATION LEFT RIGHT  
 1028+30 1 1  
 1034+50 1 1

REV. CURVE  
 Δ 1° 40' U  
 D 0° 30'  
 R 1146.0  
 T 166.7  
 L 333.3  
 E 1.3

CURVE  
 Δ 3° 19' RT  
 D 1'  
 R 673.0  
 T 16.53  
 L 331.7  
 E 2.3

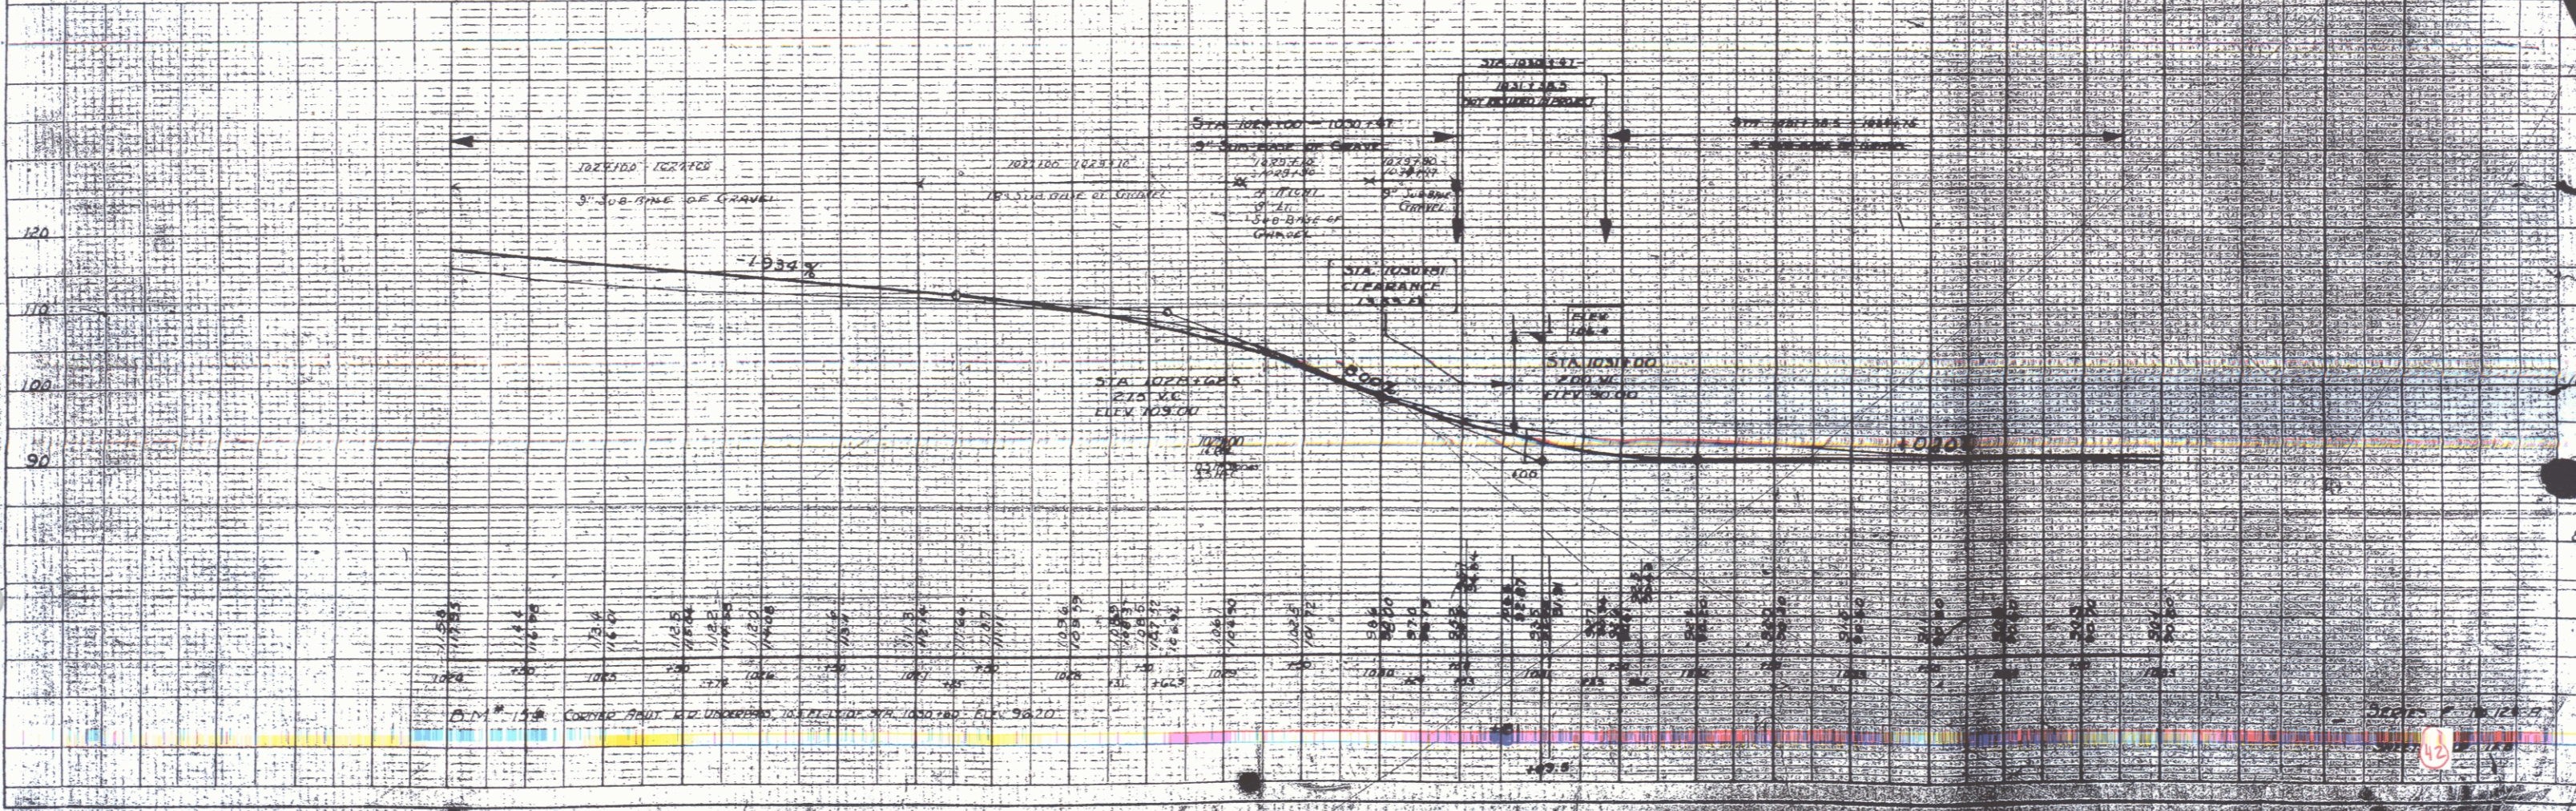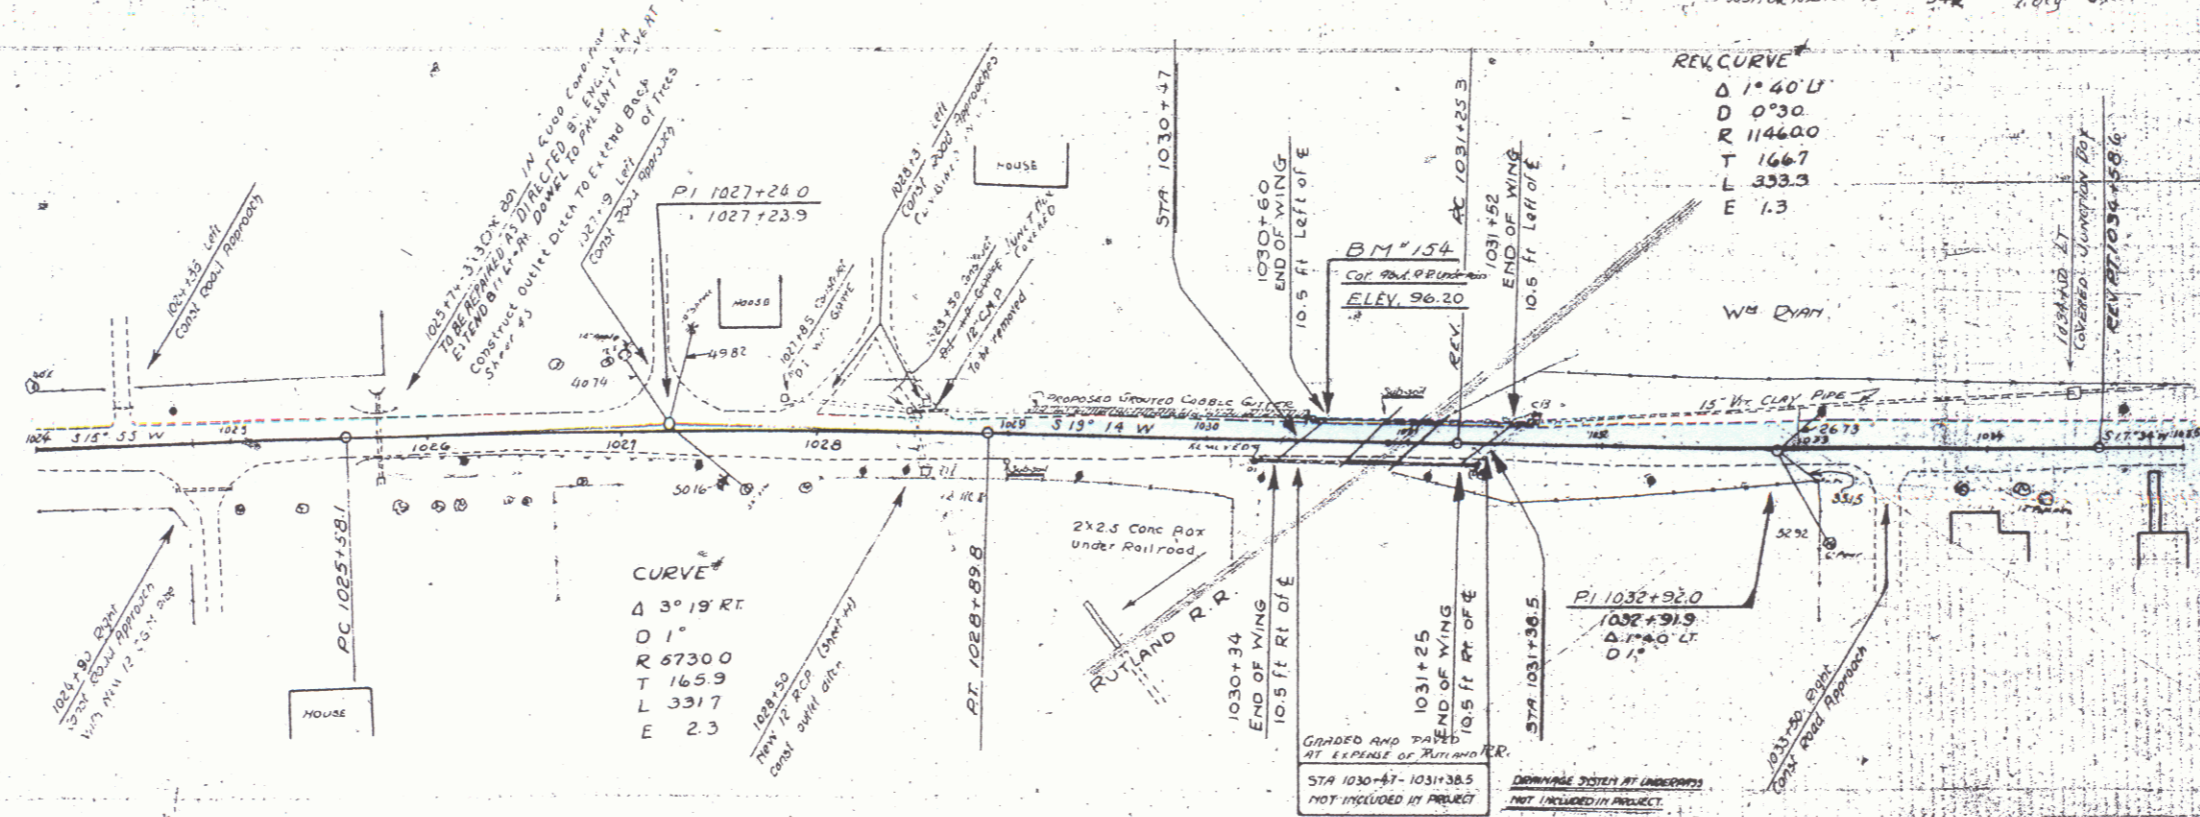

PLAN  
 1/4\"/>

PROF.  
 1/4\"/>

SCALE 1\"/>