


(To Be Returned To R.O.W. Division)

RIGHT-OF-WAY DIVISION
TOWN FILE
PERMIT
Town of US 7

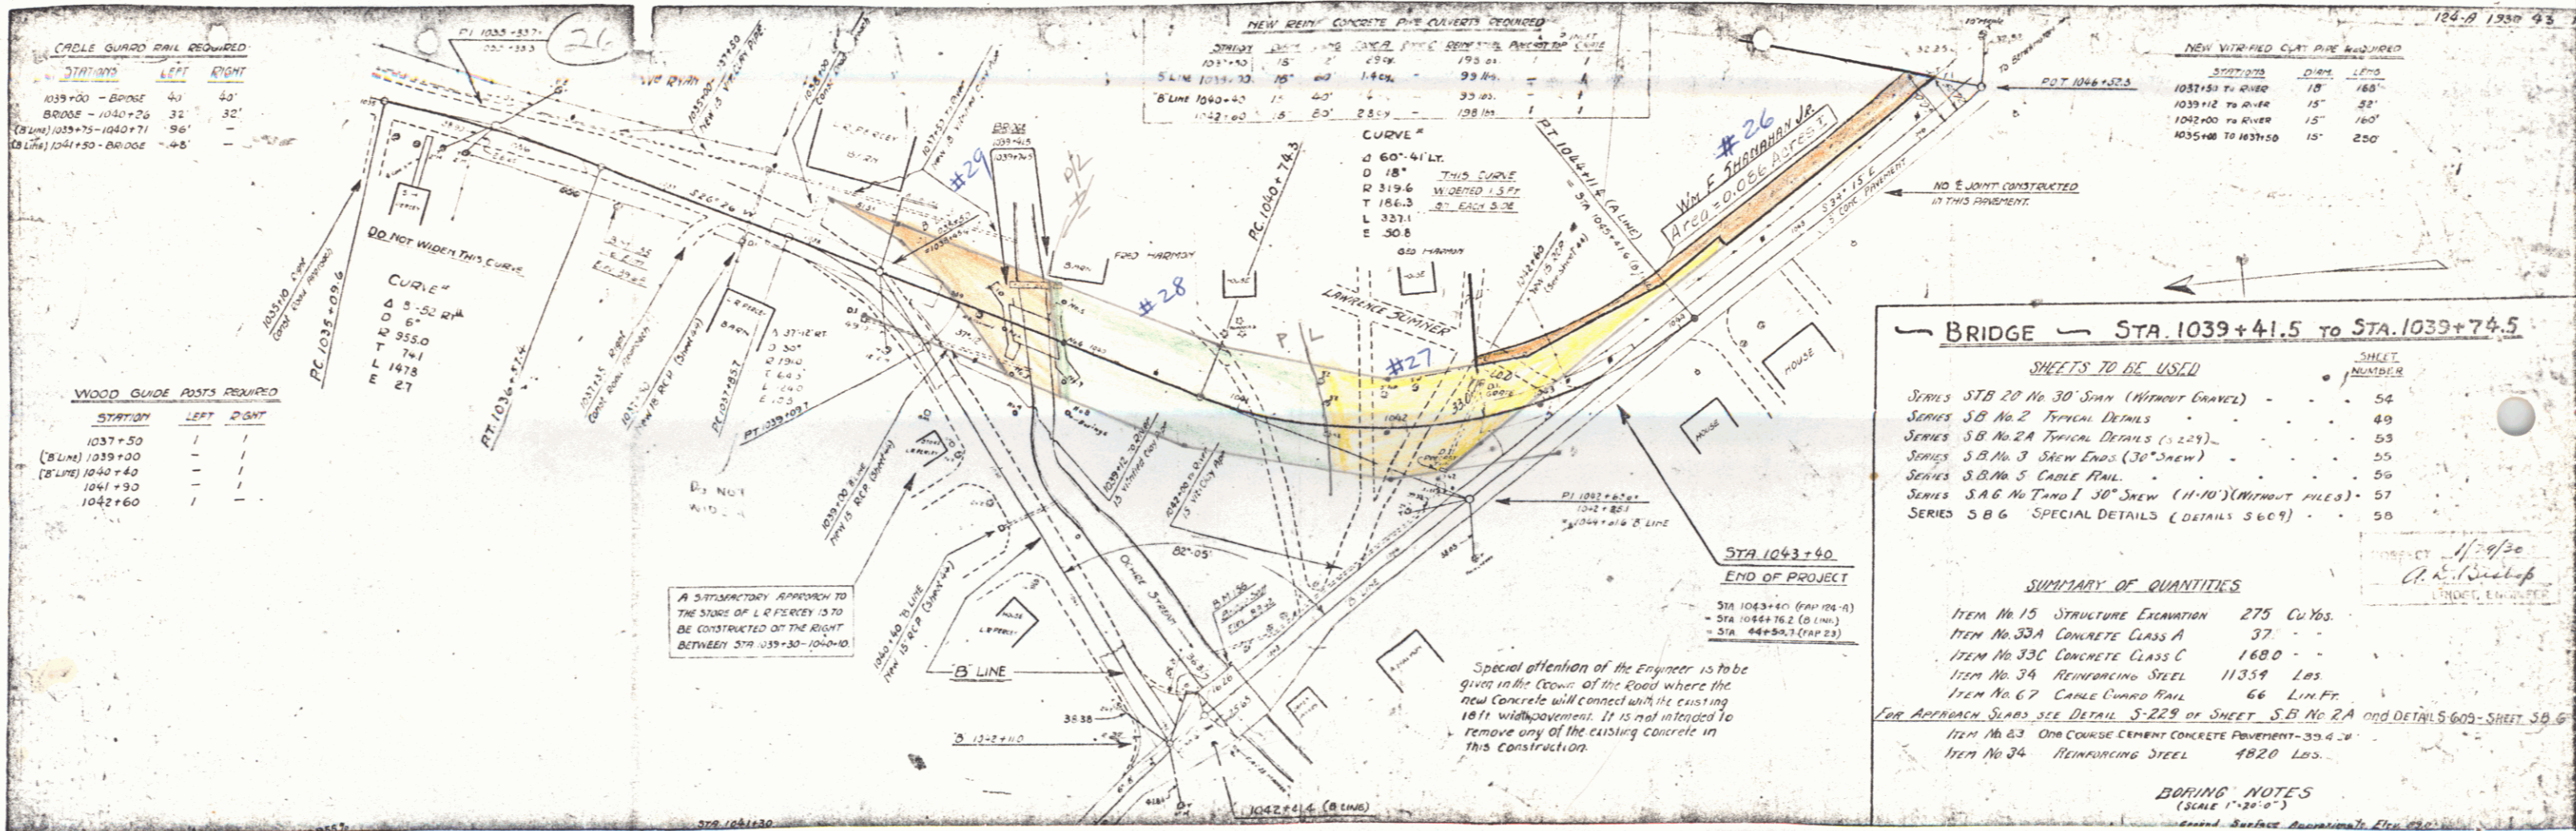

43

43