


PLAN
 DATE: 1/17/80
 DRAWN BY: J. W. GIBSON
 CHECKED BY: J. W. GIBSON
 IN CHARGE: J. W. GIBSON

PROFILE
 DATE: 1/17/80
 DRAWN BY: J. W. GIBSON
 CHECKED BY: J. W. GIBSON
 IN CHARGE: J. W. GIBSON

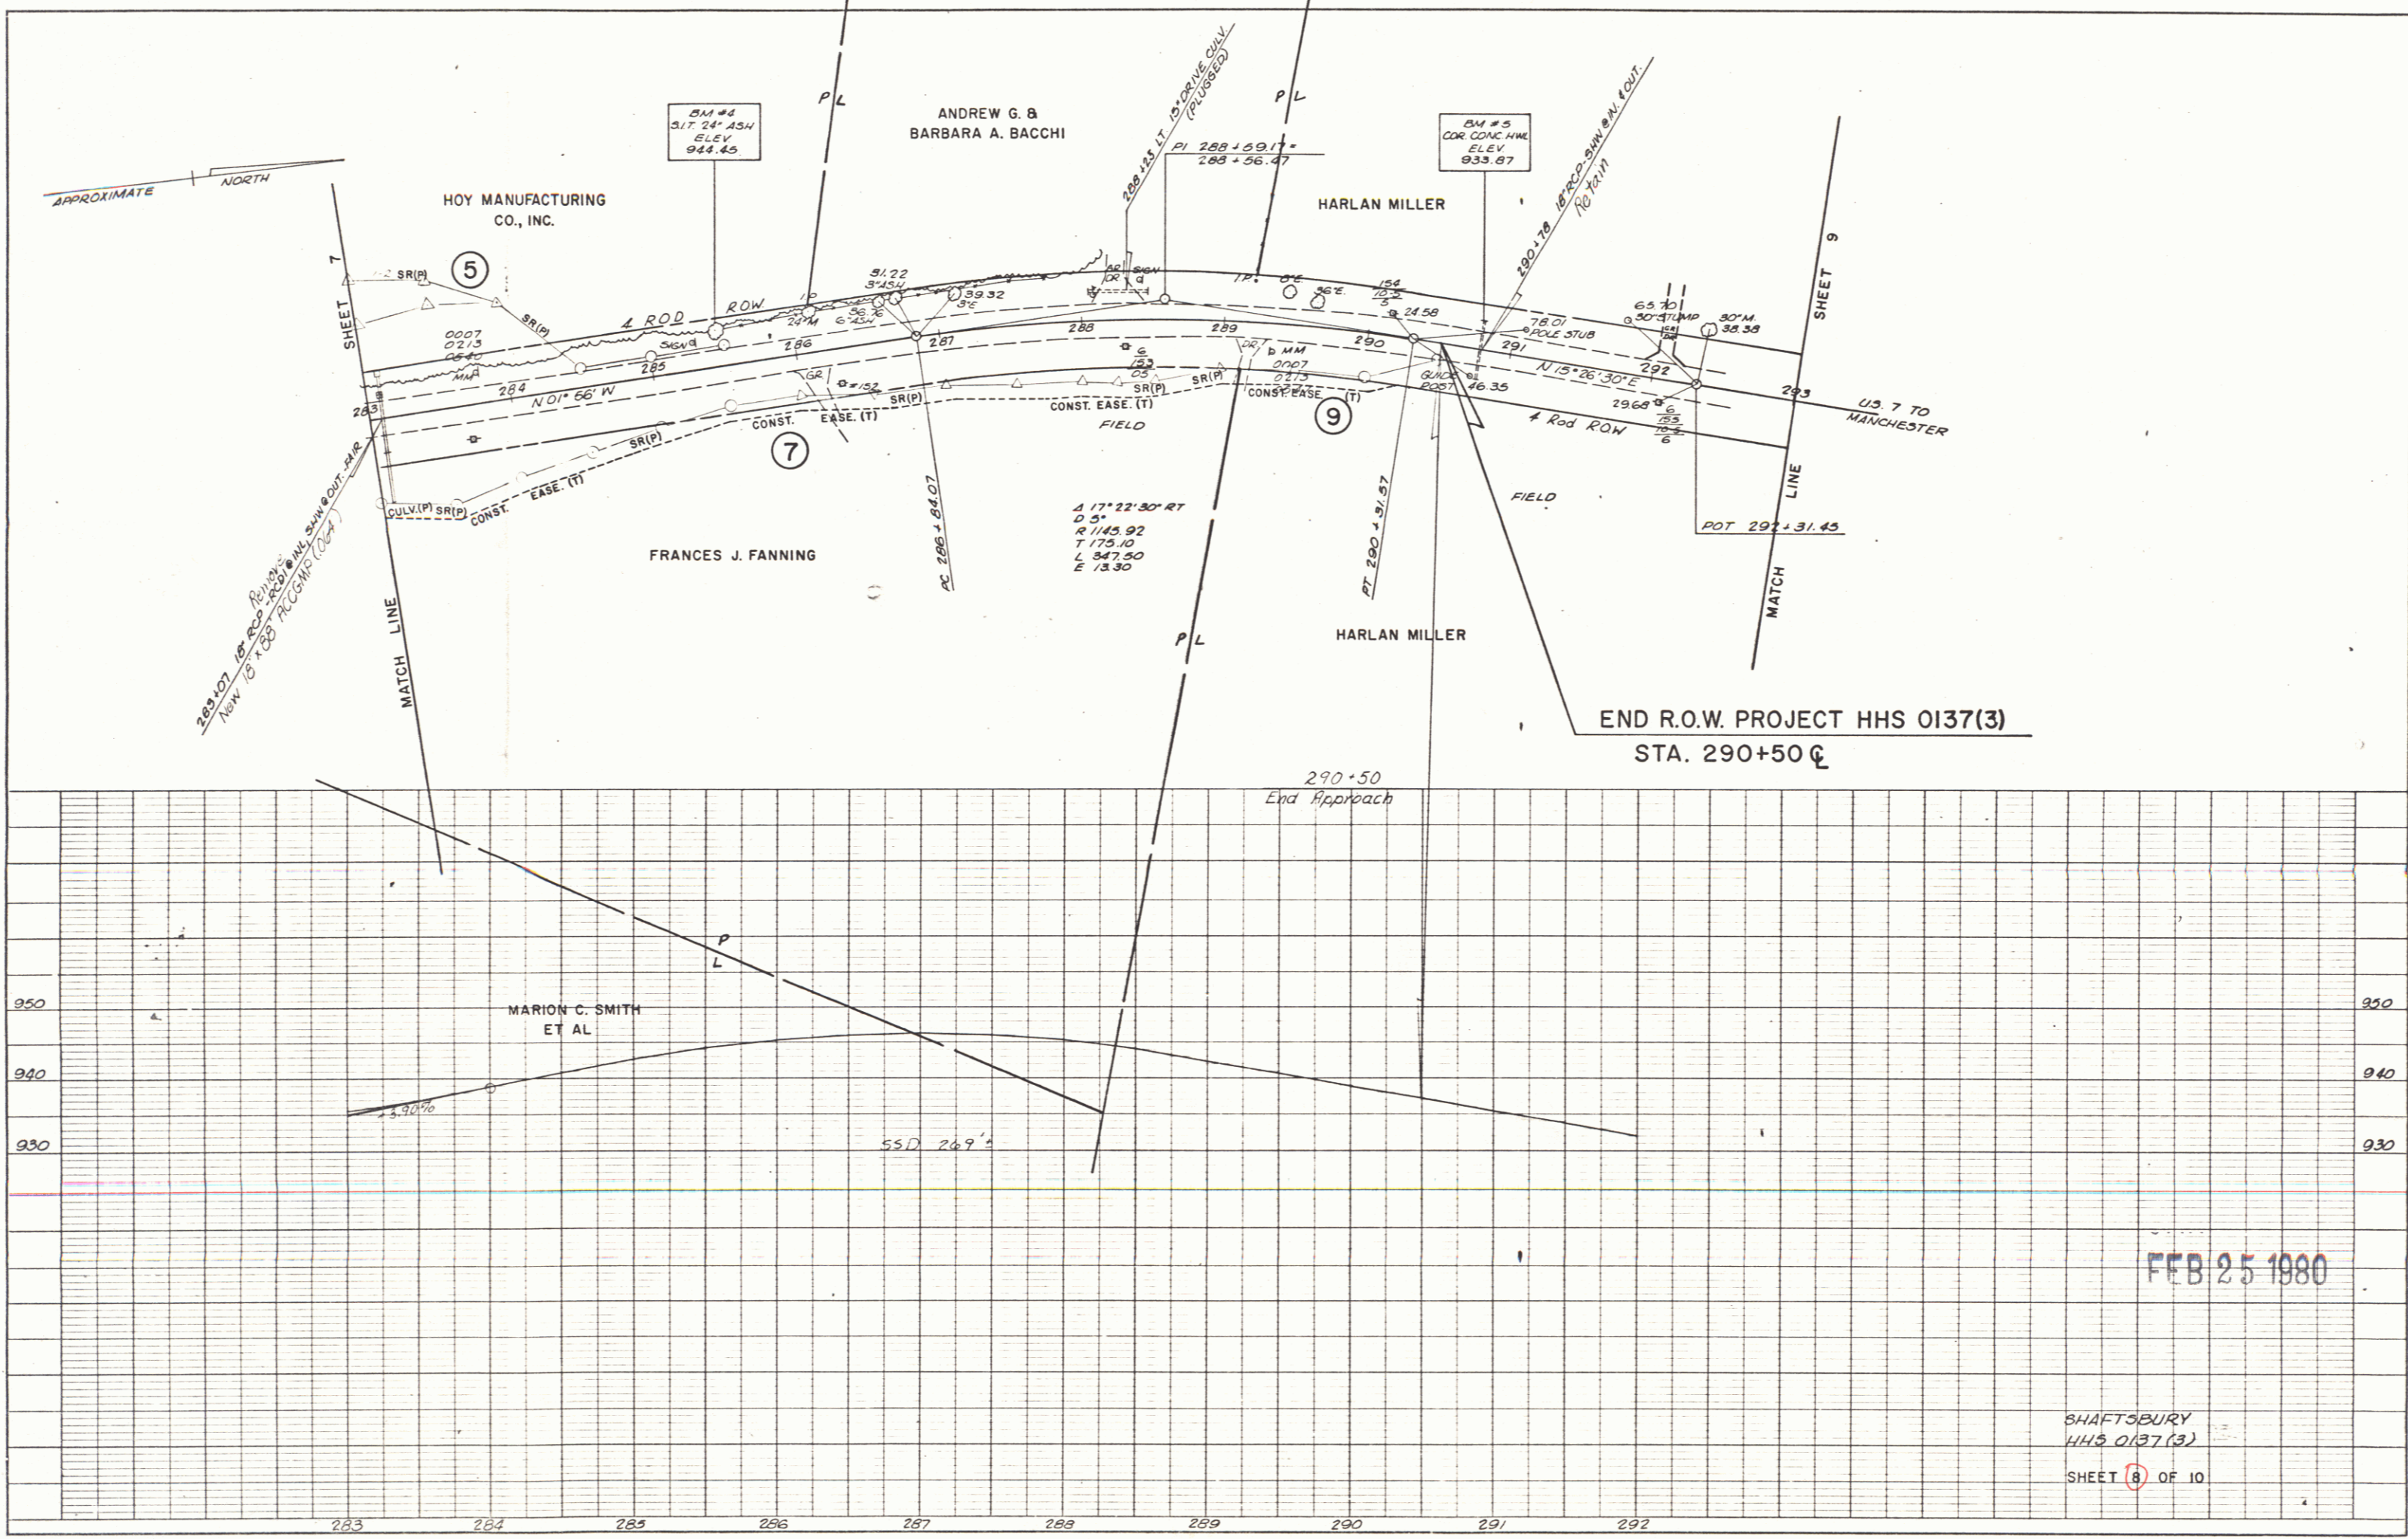

FEB 25 1980

SHAFTSBURY
 HHS 0137(3)
 SHEET 8 OF 10