


Vertical Curve Data

Station	Length	Grade
4101-4145	44 ft	4.4%
4108-4132	24 ft	-
4138-4142	4 ft	2.4%
4145-4149	4 ft	2.4%

Curve Data

Station	Dist.	Long. Cont. A	Cont. B	Dist.
7120	30'	34.6'	34.6'	50'
7120	09'	16'	31.4'	33.4'
7127	15'	32.6'	32.6'	33.4'

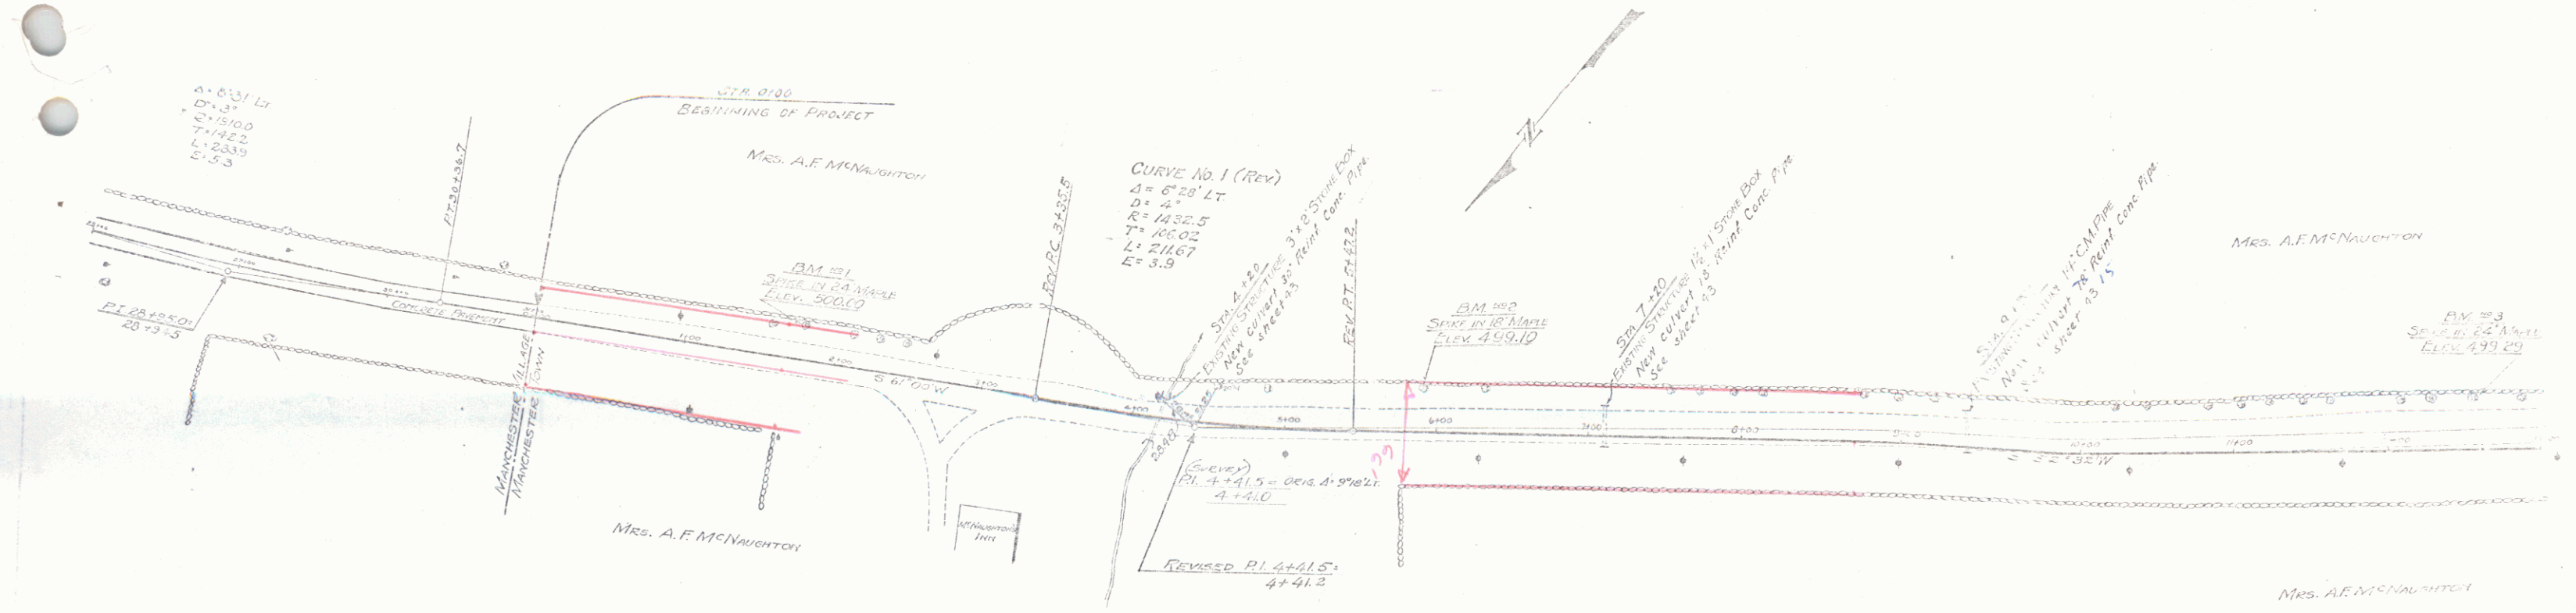

Subgrade and Gravel Specifications

Station	Subgrade	Gravel
4+00 - 9+50	12" sub base of gravel	8' wide on right
9+50 - 13+00	12" sub base of gravel	10' wide on RT.

SECTION No. 1004
SHEET 4 OF 24 SHEETS