



WIDE GUARD RAIL REVISION

Station	Left	Right
215+00-215+20	24.1	14.1
217+00-217+20	21.5	21.5
220+00-220+1	12.1	12.1

NEW REINFORCING PIPE CONCRETE REQUIRED

Station	Width	Conc. B.	Steel
211+37	16"	3.0 cy	33" 34
217+15	18"	3.0 cy	33" 34
221+00	15"	2.6 cy	33" 34

104A 1587 10 32

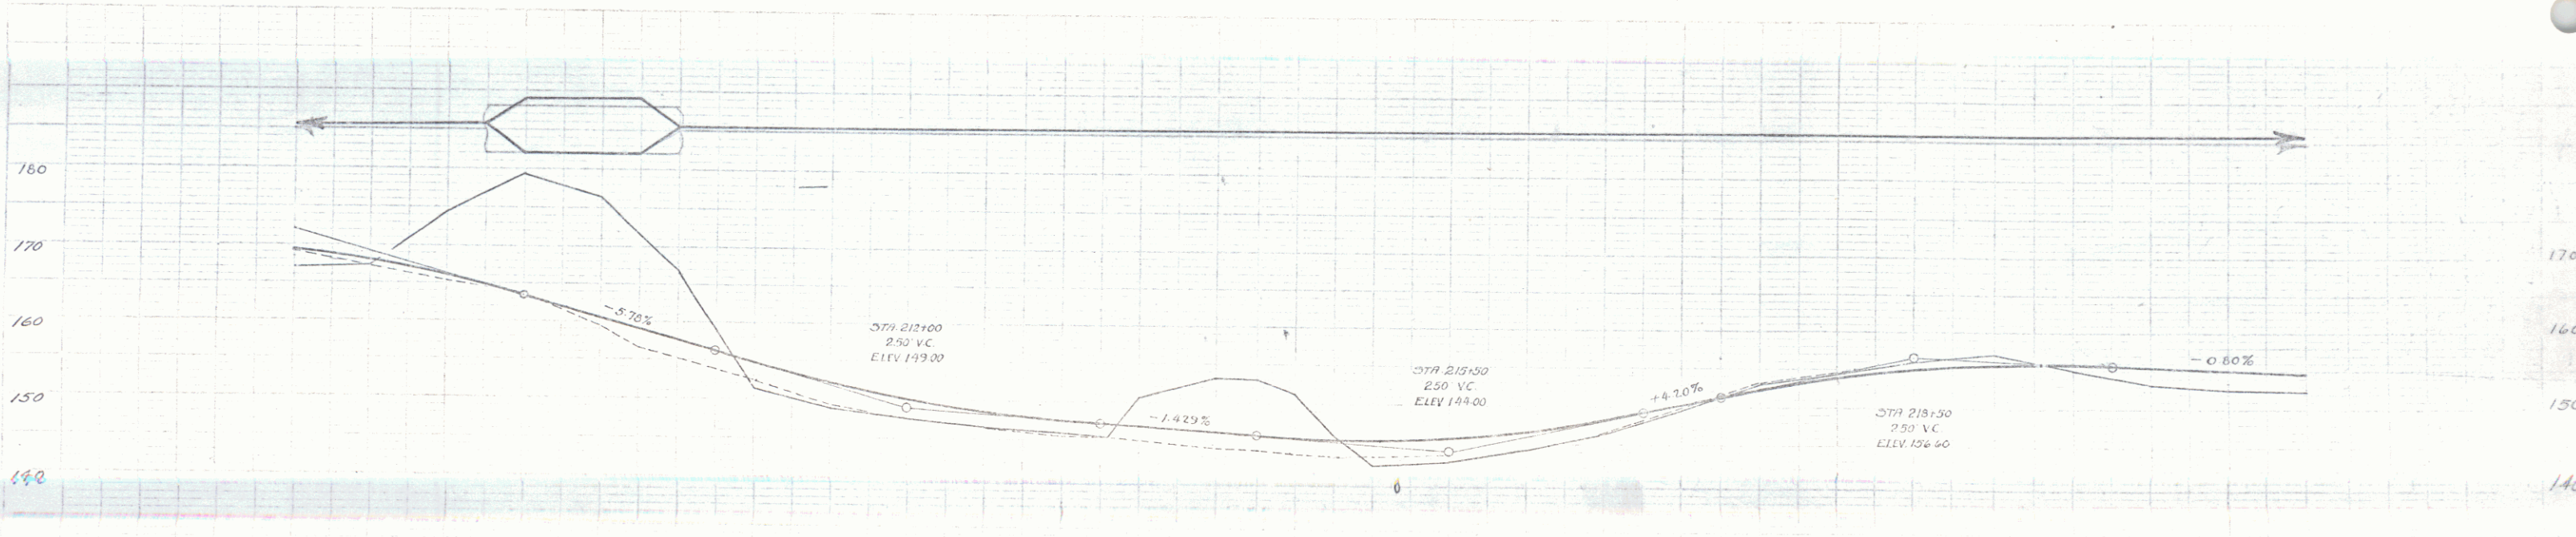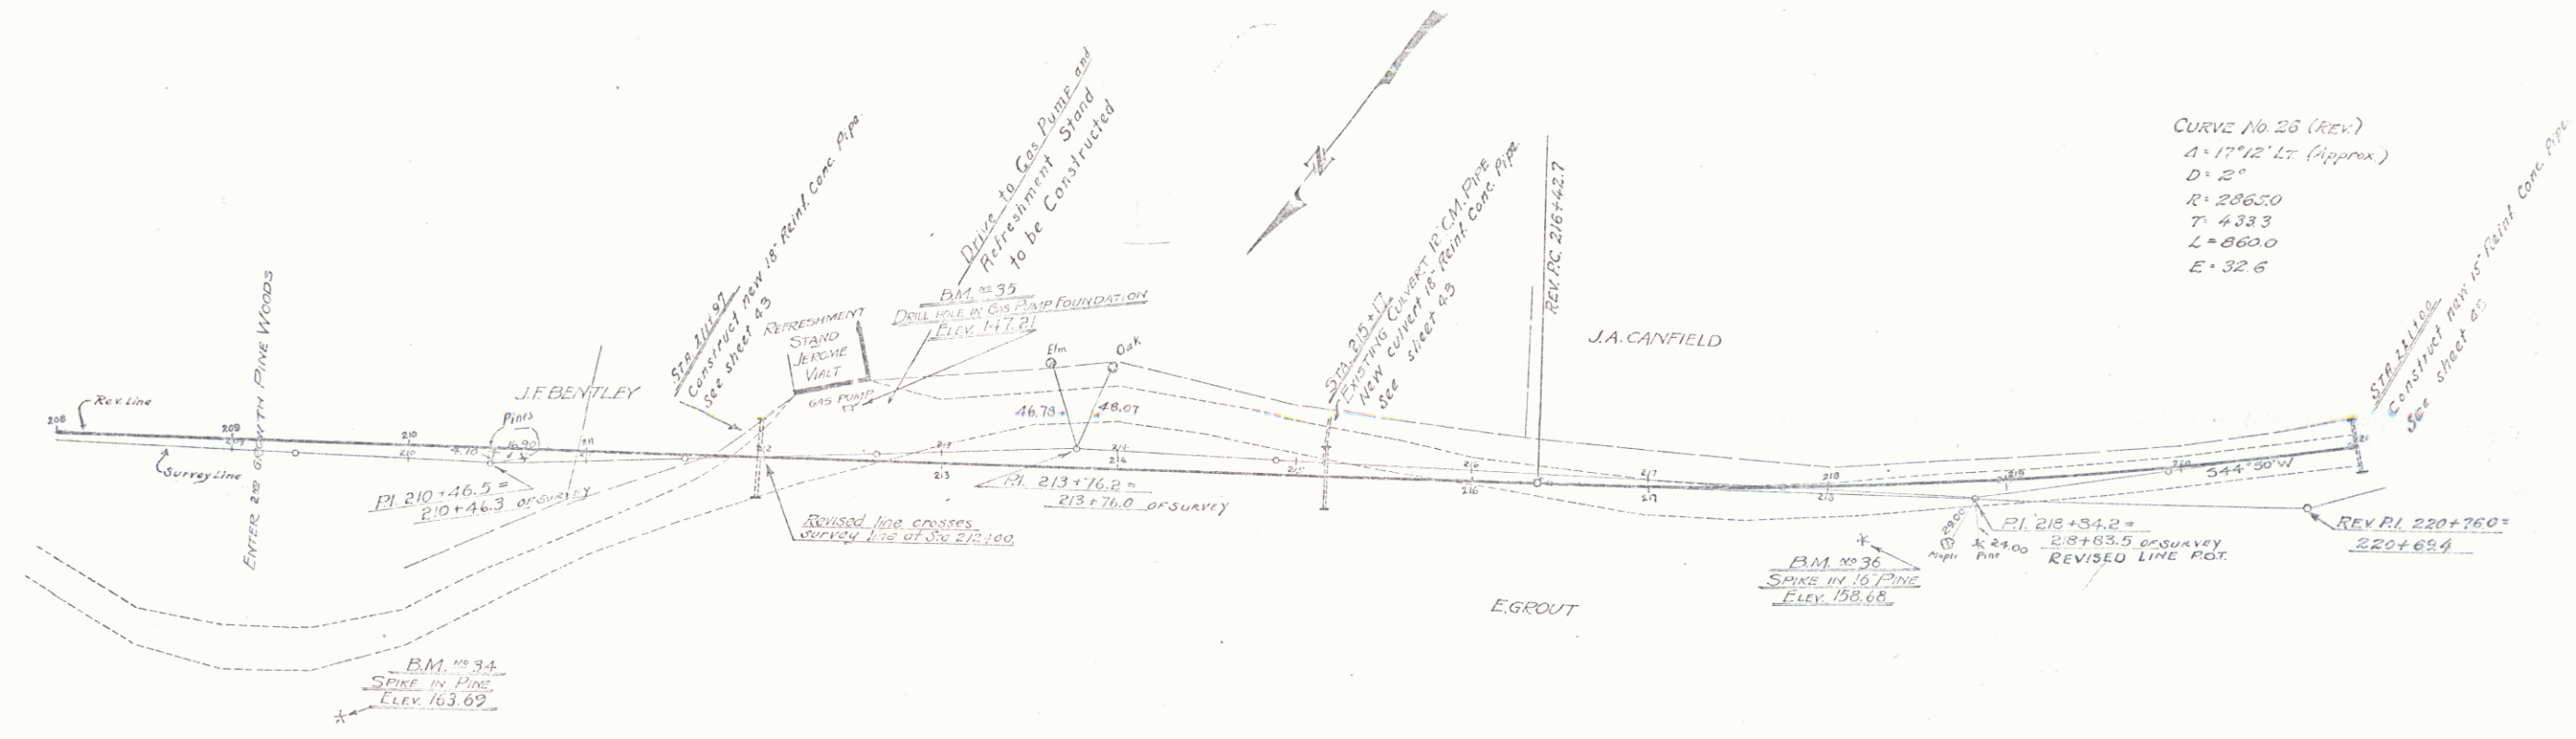

Station	Elevation
208+00	147.0
208+50	145.20
209+00	147.3
209+50	147.94
210+00	144.5
210+50	144.01
211+00	143.44
211+50	141.55
212+00	137.0
212+50	137.16
213+00	135.7
213+50	135.91
214+00	137.6
214+50	136.56
215+00	140.5
215+50	140.78
216+00	145.7
216+50	141.68
217+00	150.6
217+50	146.96
218+00	143.1
218+50	144.9
219+00	145.0
219+50	145.78
220+00	141.2
220+50	145.80
221+00	142.0
221+50	145.34
222+00	149.5
222+50	145.51
223+00	142.5
223+50	145.76
224+00	144.1
224+50	146.73
225+00	144.2
225+50	146.27
226+00	148.0
226+50	149.25
227+00	149.8
227+50	150.30
228+00	151.7
228+50	152.34
229+00	150.8
229+50	148.84
230+00	156.0
230+50	155.04
231+00	157.0
231+50	153.64
232+00	155.0
232+50	155.75
233+00	153.1
233+50	155.40
234+00	152.6
234+50	155.00
235+00	152.8
235+50	154.00

BM 34 - SPIKE IN ROOT OF PINE ON RT OF OLD HIGHWAY - ELEV. 143.69
 BM 35 - DRILLHOLE IN GAS PUMP FOUNDATION 24' LT. OF STA. 212+47 - ELEV. 147.21
 BM 36 - SPIKE IN ROOT OF 16" PINE 24' RT OF STA. 218+18 - ELEV. 158.68

38185 F. NO. 104A
 SHEET 18 OF 90 SHEETS