

Wood Guard Rail Required  
 Station Left Right  
 292+00-293+14 24R



NEW POINT CONC. PIPE CURVERTS REQUIRED

Station Ditch Left Right  
 289+00 15" 32" 18" 5'  
 293+00 15" 32" 18" 5'

CURVE No. 38 (REV)  
 Δ = 7°40' LT. Approx  
 D = 4"  
 R = 1432.5  
 T = 96.0  
 L = 191.7  
 E = 3.2  
 Do not bank

CURVE No. 40  
 Δ = 5°43' LT.  
 D = 3"  
 R = 1910.0  
 T = 95.4  
 L = 190.6  
 E = 2.4

CURVE No. 39  
 Δ = 15°58' RT.  
 D = 5"  
 R = 1146.0  
 T = 140.4  
 L = 279.3  
 E = 8.6

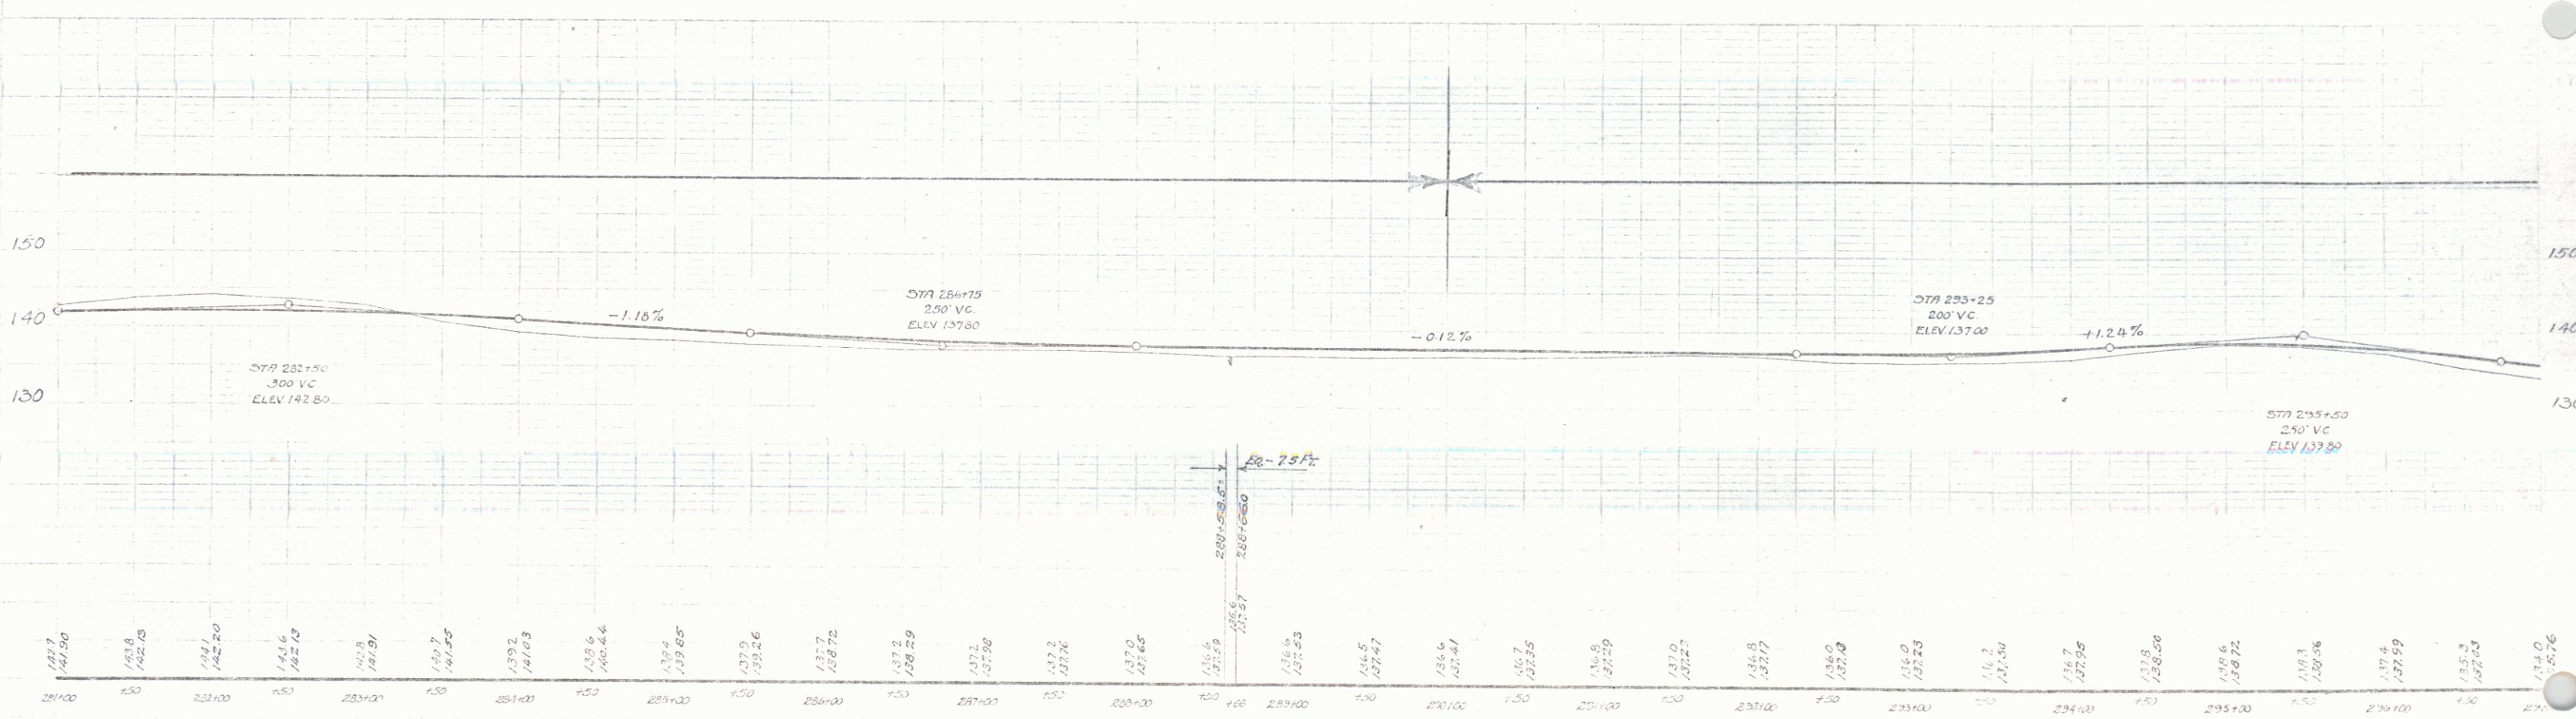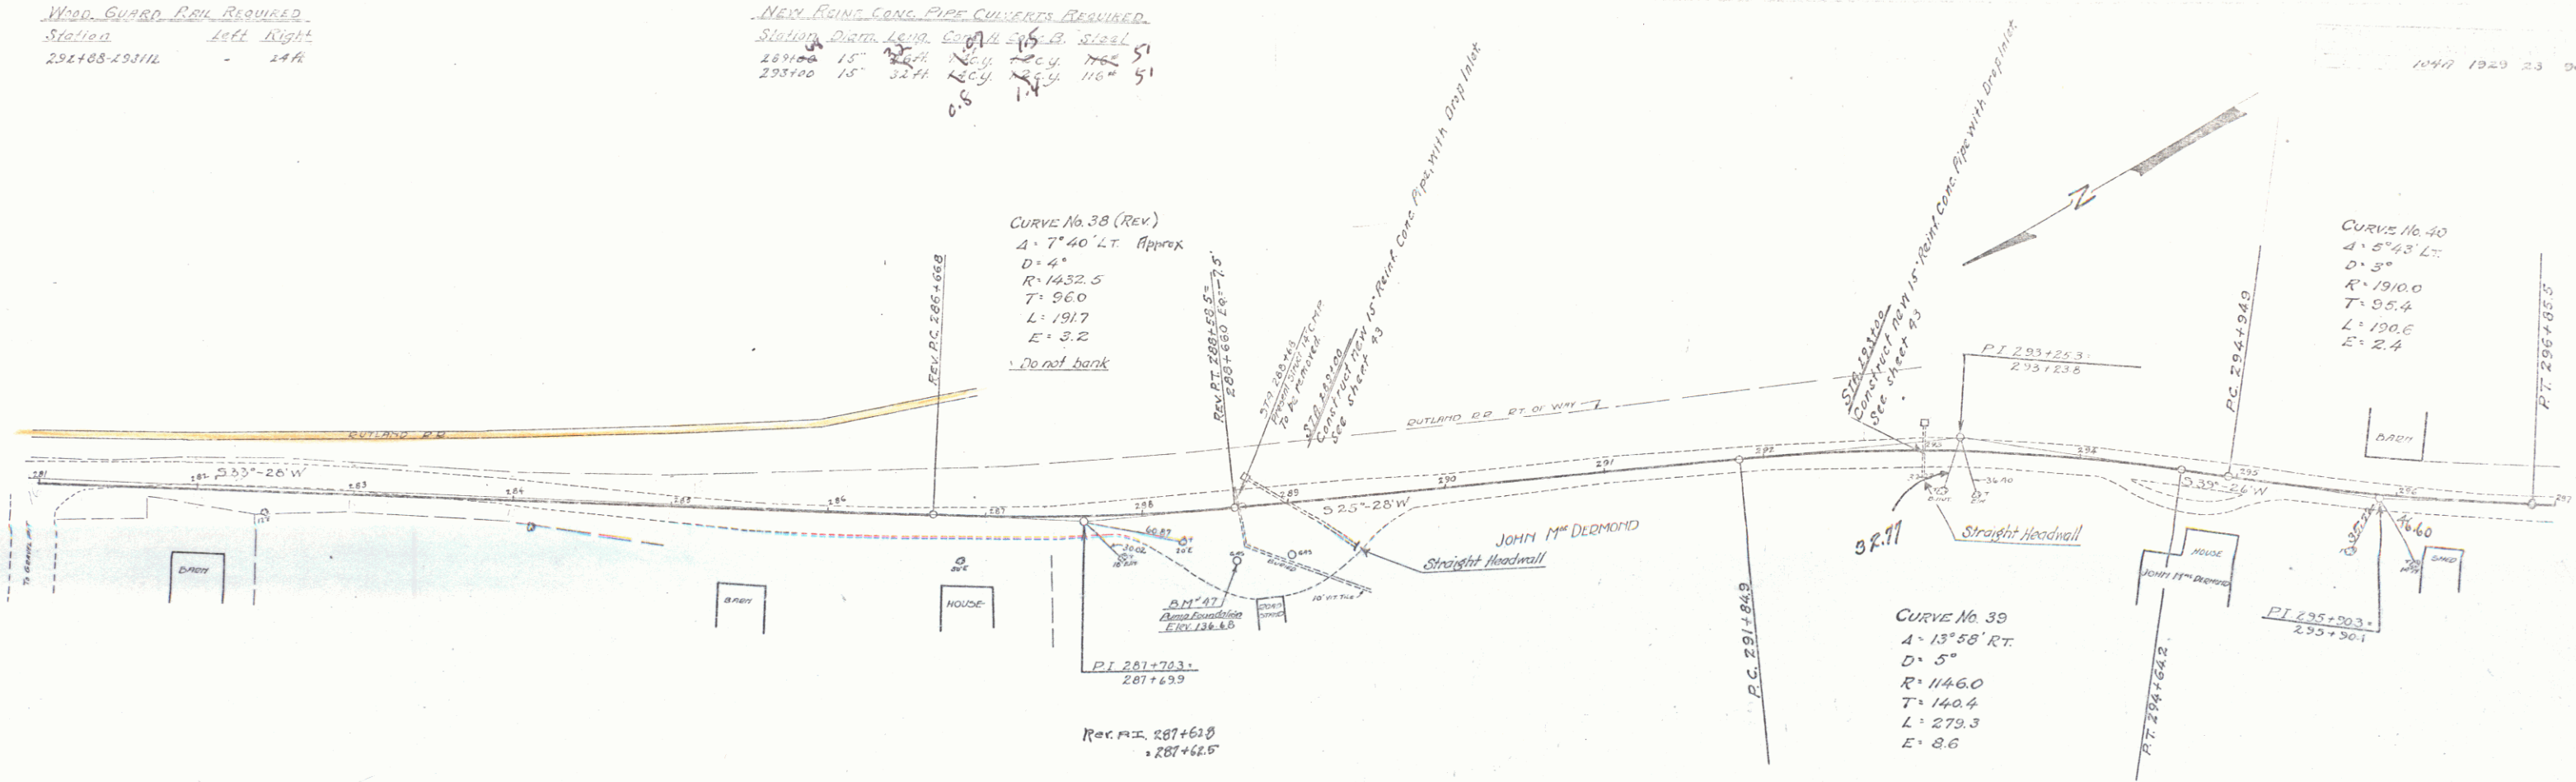

BM 47 GAS PUMP FOUNDATION, 30' E OF DIT 286+66 - ELEV 136.65

SHEET NO 102 P 23 1998

22