

**WOOD GUARD RAIL REQUIRED**  
 Stations: 361+00 TO 361+30  
 LEFT RIGHT: 14M

**NEW REINFORCED CONCRETE PIPE COLLECTOR REQUIRED**



Station	Length	Size	Notes
361+00	12'	36"	14
361+12	12'	36"	14
361+24	12'	36"	14
361+36	12'	36"	14
361+48	12'	36"	14
361+60	12'	36"	14
361+72	12'	36"	14
361+84	12'	36"	14
361+96	12'	36"	14
362+00	12'	36"	14

**NEW VIBRATED TIN DRAIN REQUIRED**

Station	Length	Size	Notes
361+00	12'	18"	15cy
361+12	12'	18"	15cy
361+24	12'	18"	15cy
361+36	12'	18"	15cy
361+48	12'	18"	15cy
361+60	12'	18"	15cy
361+72	12'	18"	15cy
361+84	12'	18"	15cy
361+96	12'	18"	15cy
362+00	12'	18"	15cy

**POUR CONCRETE BASINS REQUIRED**

Station	Notes
361+70	Basin
361+80	Basin
361+90	Basin
362+00	Basin

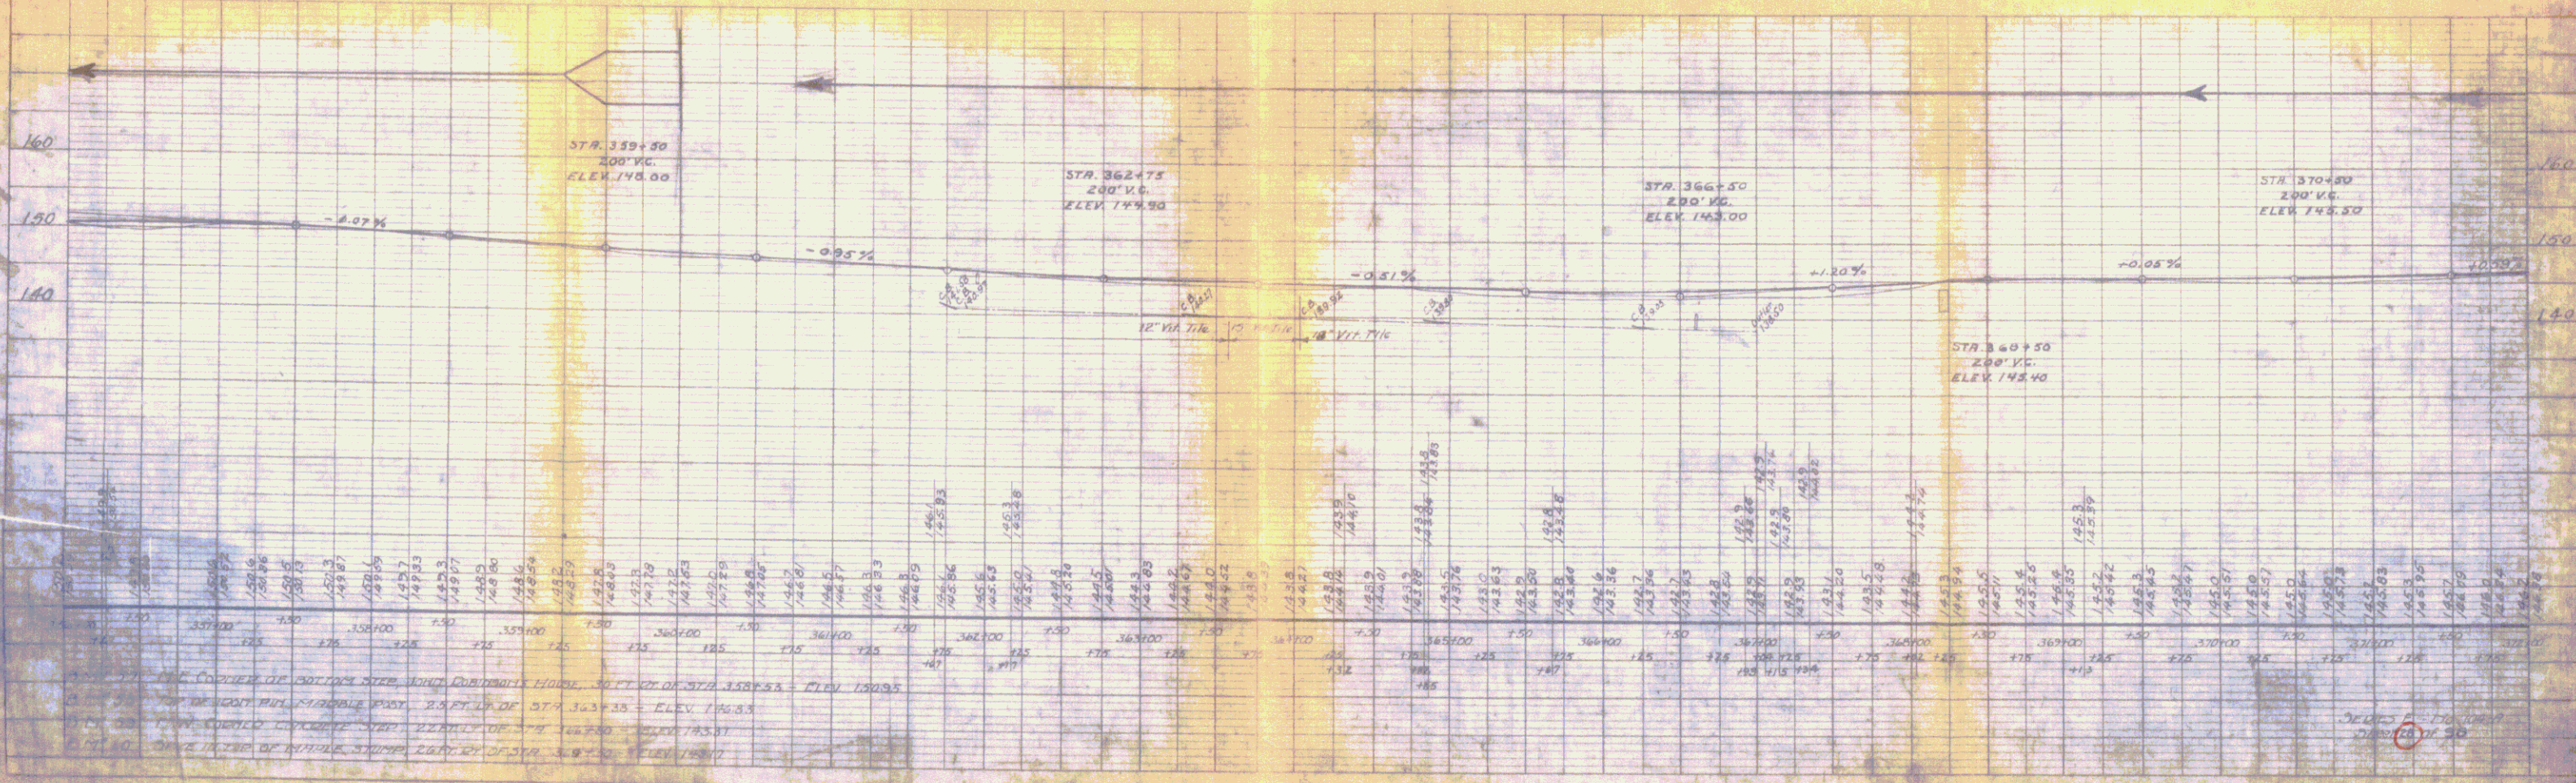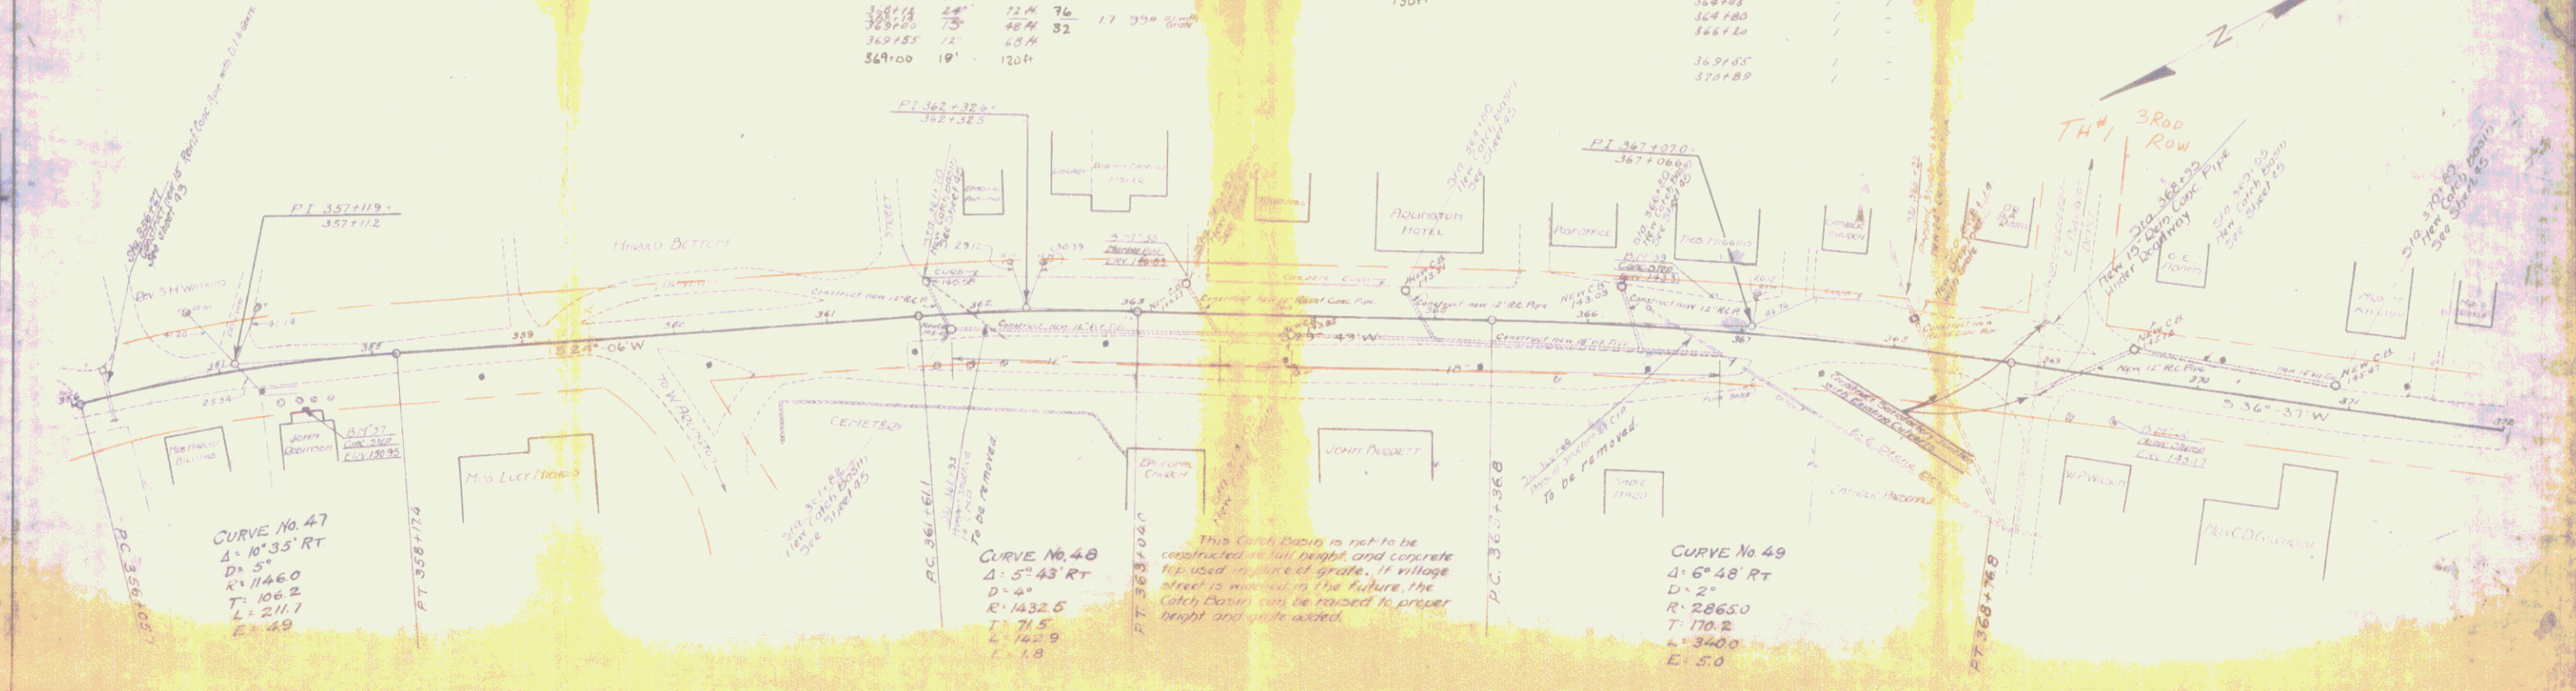

COVER OF DOTTED LINE AND CURVE DATA SET OUT OF STA. 361+00 TO 361+30  
 COVER OF DOTTED LINE AND CURVE DATA SET OUT OF STA. 361+30 TO 361+60  
 COVER OF DOTTED LINE AND CURVE DATA SET OUT OF STA. 361+60 TO 361+90  
 COVER OF DOTTED LINE AND CURVE DATA SET OUT OF STA. 361+90 TO 362+00