

Index of Sheets
 1 Title Page
 2-3 Typical Sections
 4-9 Detail Sheets
 10-19 Layouts
 20-23 Total Areas
 24-25 Profiles
 26-31 Cross Sections

STATE OF VERMONT
 DEPARTMENT OF HIGHWAYS

PROPOSED IMPROVEMENT

FEDERAL AID PROJECT


TOWN OF BARRE
 COUNTY OF WASHINGTON
VERMONT ROUTE 14
 BARRE-WHITE RIVER JCT. ROAD

BEGINNING AT A POINT 0.573 MILES SOUTHERLY OF THE BARRE TOWN-BARRE CITY LINE AND EXTENDING NORTHERLY 0.394 MILES


LENGTH OF ROADWAY 1,025 FEET = 0.324 MILES
 LENGTH OF PROJECT 1,025 FEET = 0.324 MILES

DOT 1965	2100-3730
DOT 1987	400-7300
LDV 1947	400-1050
0	60%-53%
1	7%-9%

Date 11/04/65
 Pin# 99R781

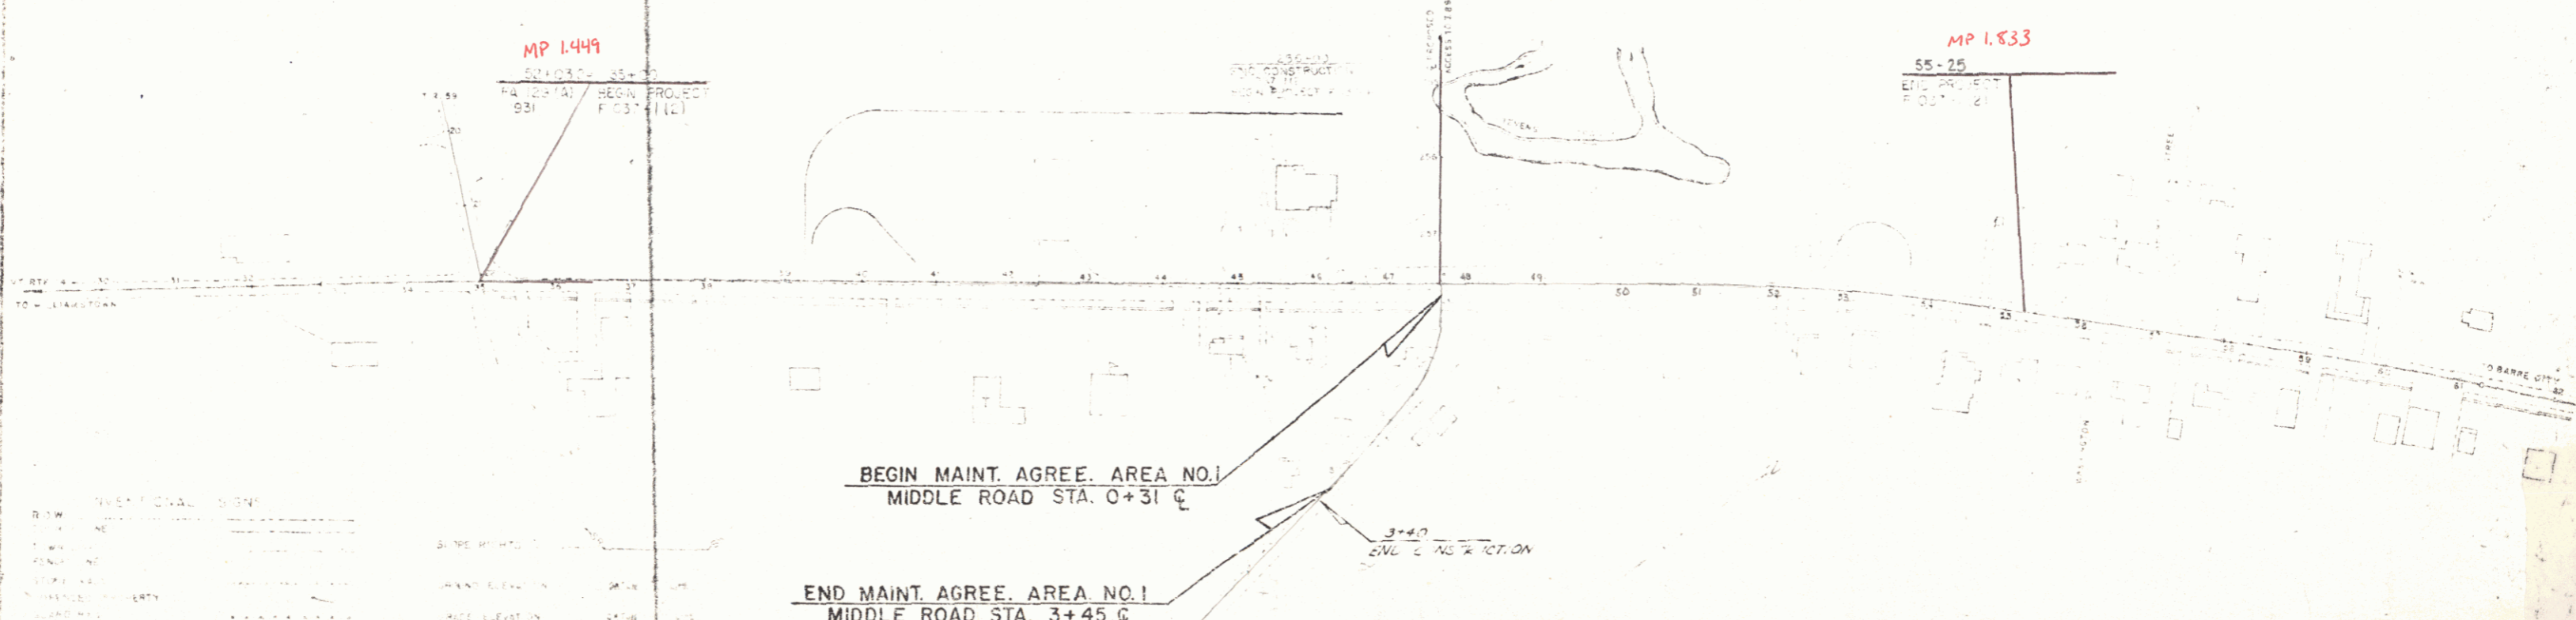

ITEM	QUANTITY	UNIT	PRICE	TOTAL
GRAVEL	1000	CU YD	1.50	1500.00
CONCRETE	500	CU YD	3.00	1500.00
PAVING	1000	SQ YD	0.50	500.00
LANDSCAPING	100	SQ YD	0.20	20.00
UTILITIES	100	LINEAL FT	0.10	10.00
CONCRETE	100	CU YD	3.00	300.00
PAVING	100	SQ YD	0.50	50.00
LANDSCAPING	100	SQ YD	0.20	20.00
UTILITIES	100	LINEAL FT	0.10	10.00
CONCRETE	100	CU YD	3.00	300.00
PAVING	100	SQ YD	0.50	50.00
LANDSCAPING	100	SQ YD	0.20	20.00
UTILITIES	100	LINEAL FT	0.10	10.00

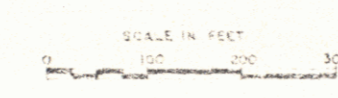

THESE PLANS AND THE SPECIFICATIONS FOR THE ROADWAY AND BRIDGE SHALL BE THE PROPERTY OF THE STATE OF VERMONT. THE BUREAU OF HIGHWAYS IS NOT RESPONSIBLE FOR THE ACCURACY OF ANY INFORMATION OBTAINED FROM THESE PLANS OR SPECIFICATIONS. SPECIAL PROVISIONS AS ARE INCORPORATED IN THESE PLANS.

Project F 037-1(2)
 1