


POOR ORIGINAL COPY

MATCH LINE AA (SEE SHEET )

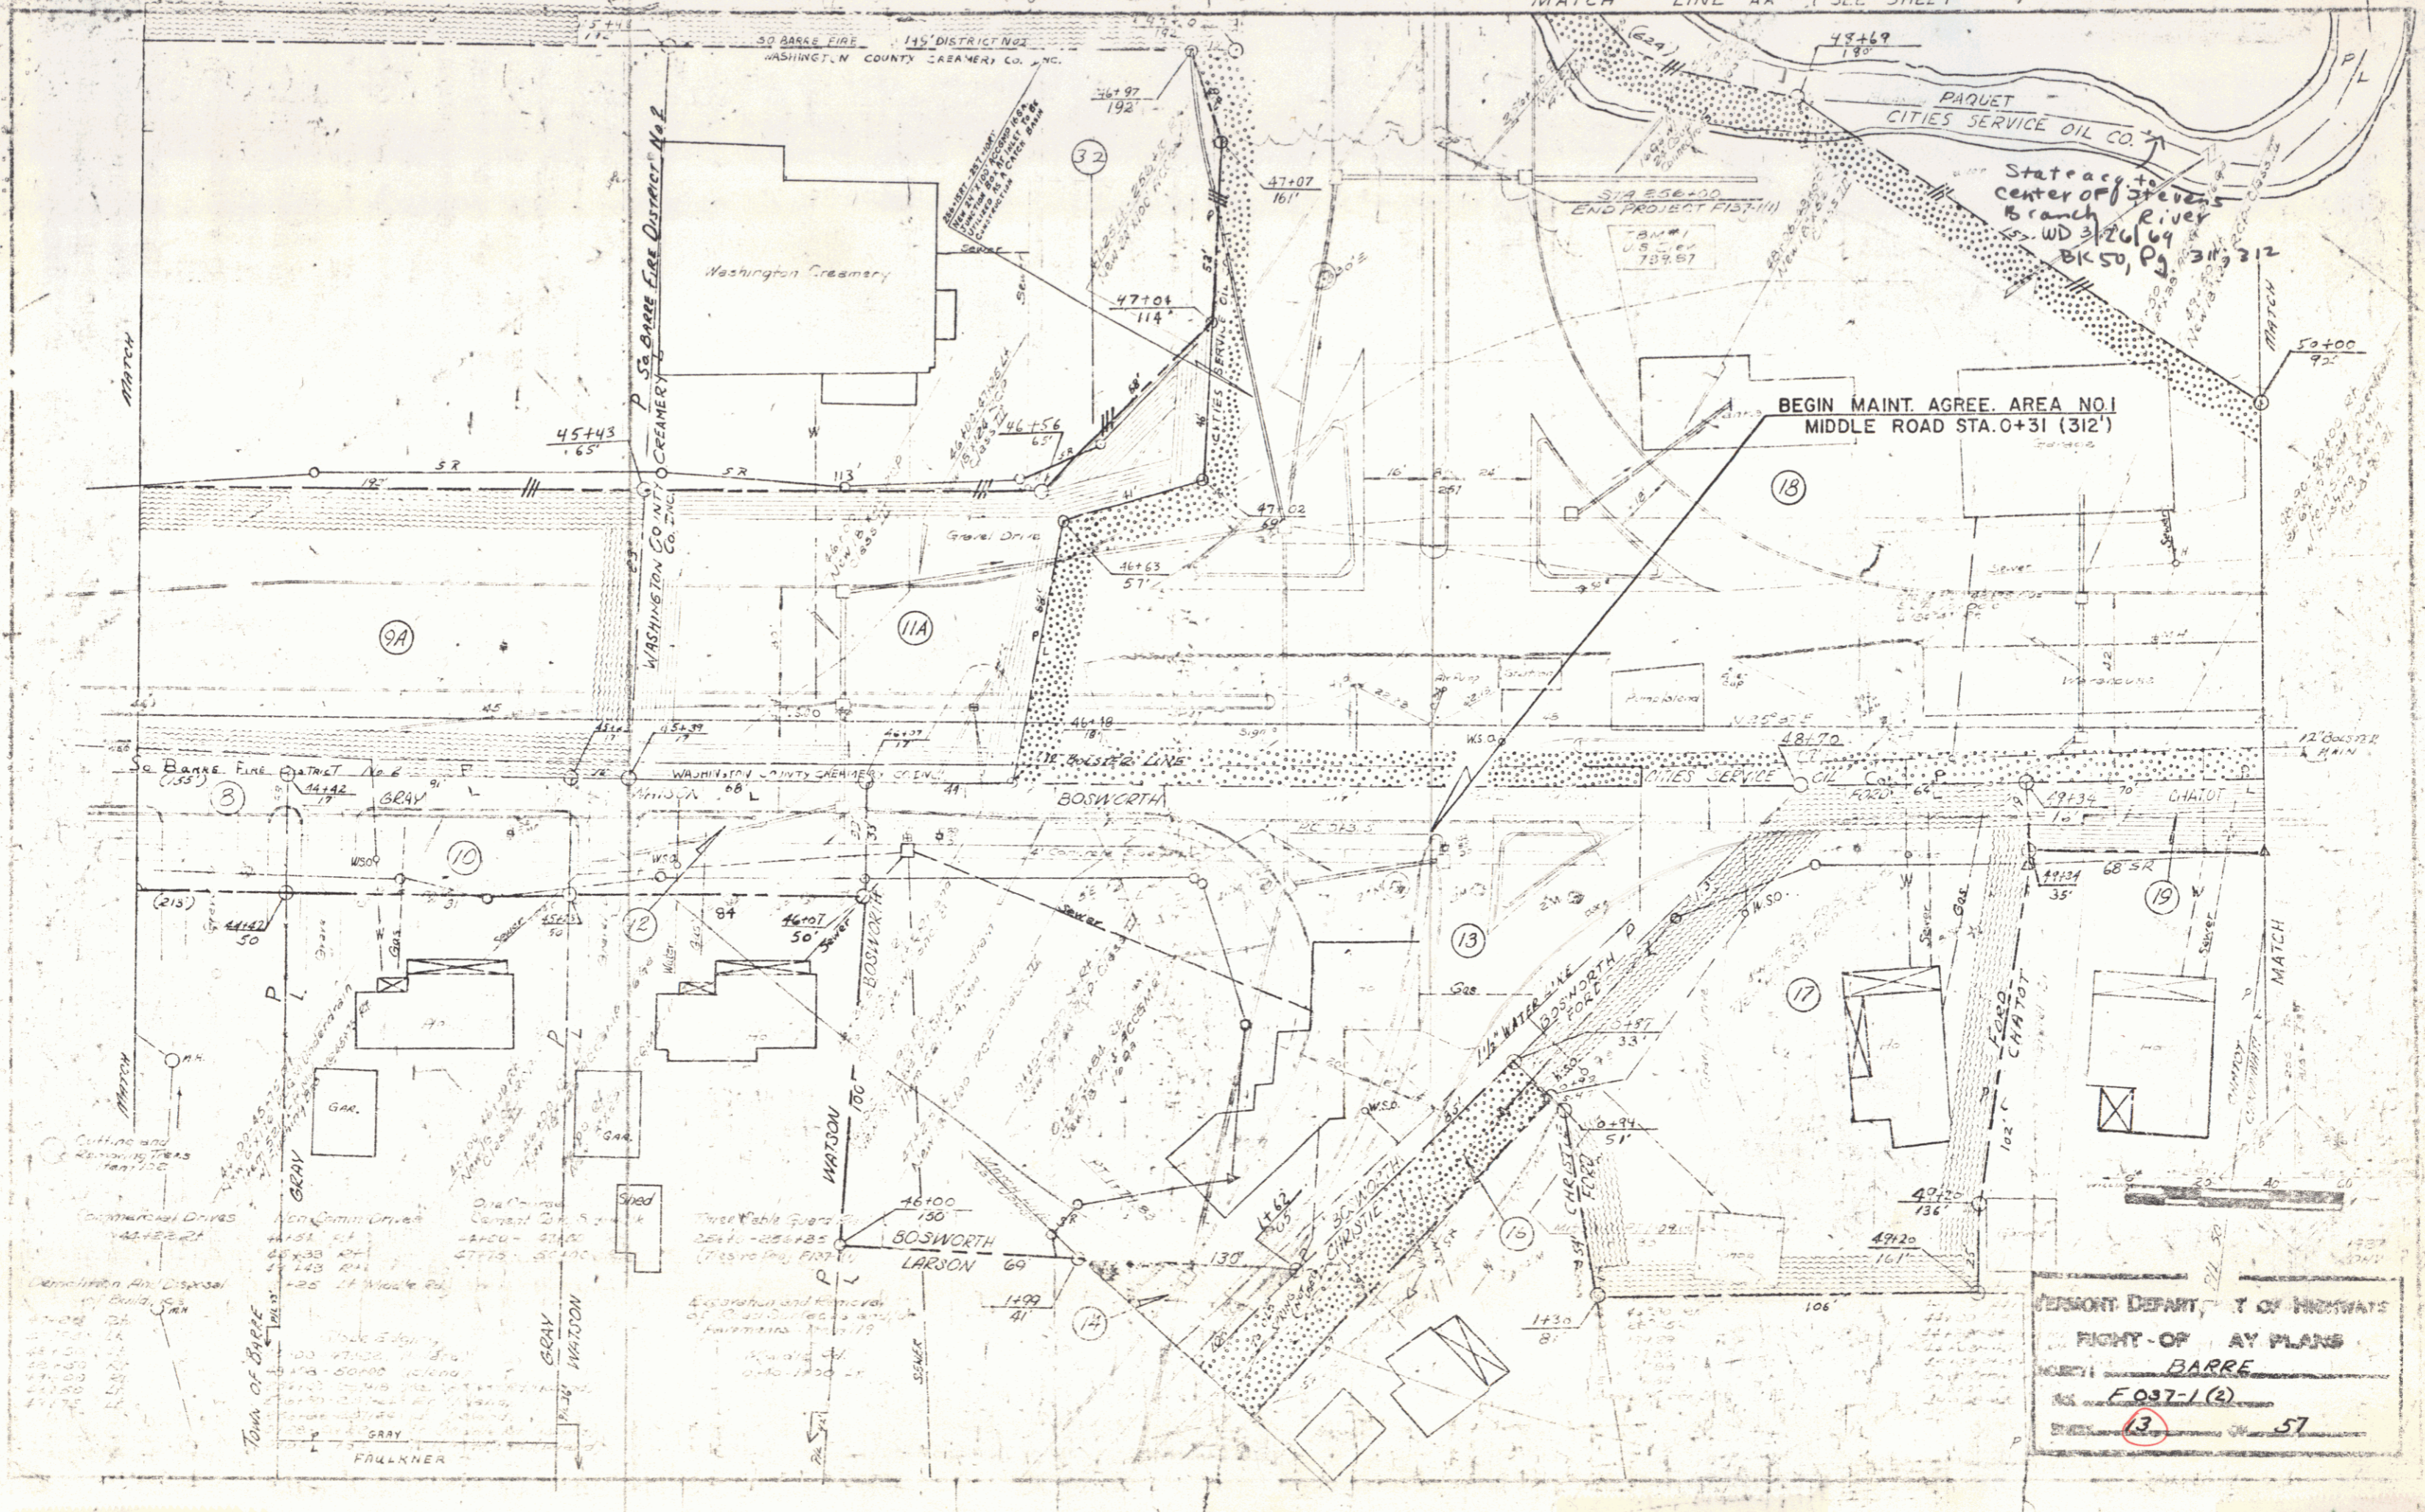

PERSONS DEPARTMENT OF HIGHWAYS  
 RIGHT-OF-WAY PLANS  
 COUNTY BARRE  
 No. F037-1(2)  
 SHEET 13 OF 57