


DISCONTINUOUS CONCRETE CURB
 RT. Lane 1217+74 - 1220+00 Lt.
 Lt. Lane 1205+00 - 1205+00 Lt.
 Lt. Lane 1217+74 - 1220+00 Lt.
 Treated Timber Curb
 26+80 - 28+58 Lt.
 36+95 - 43+46 Lt.

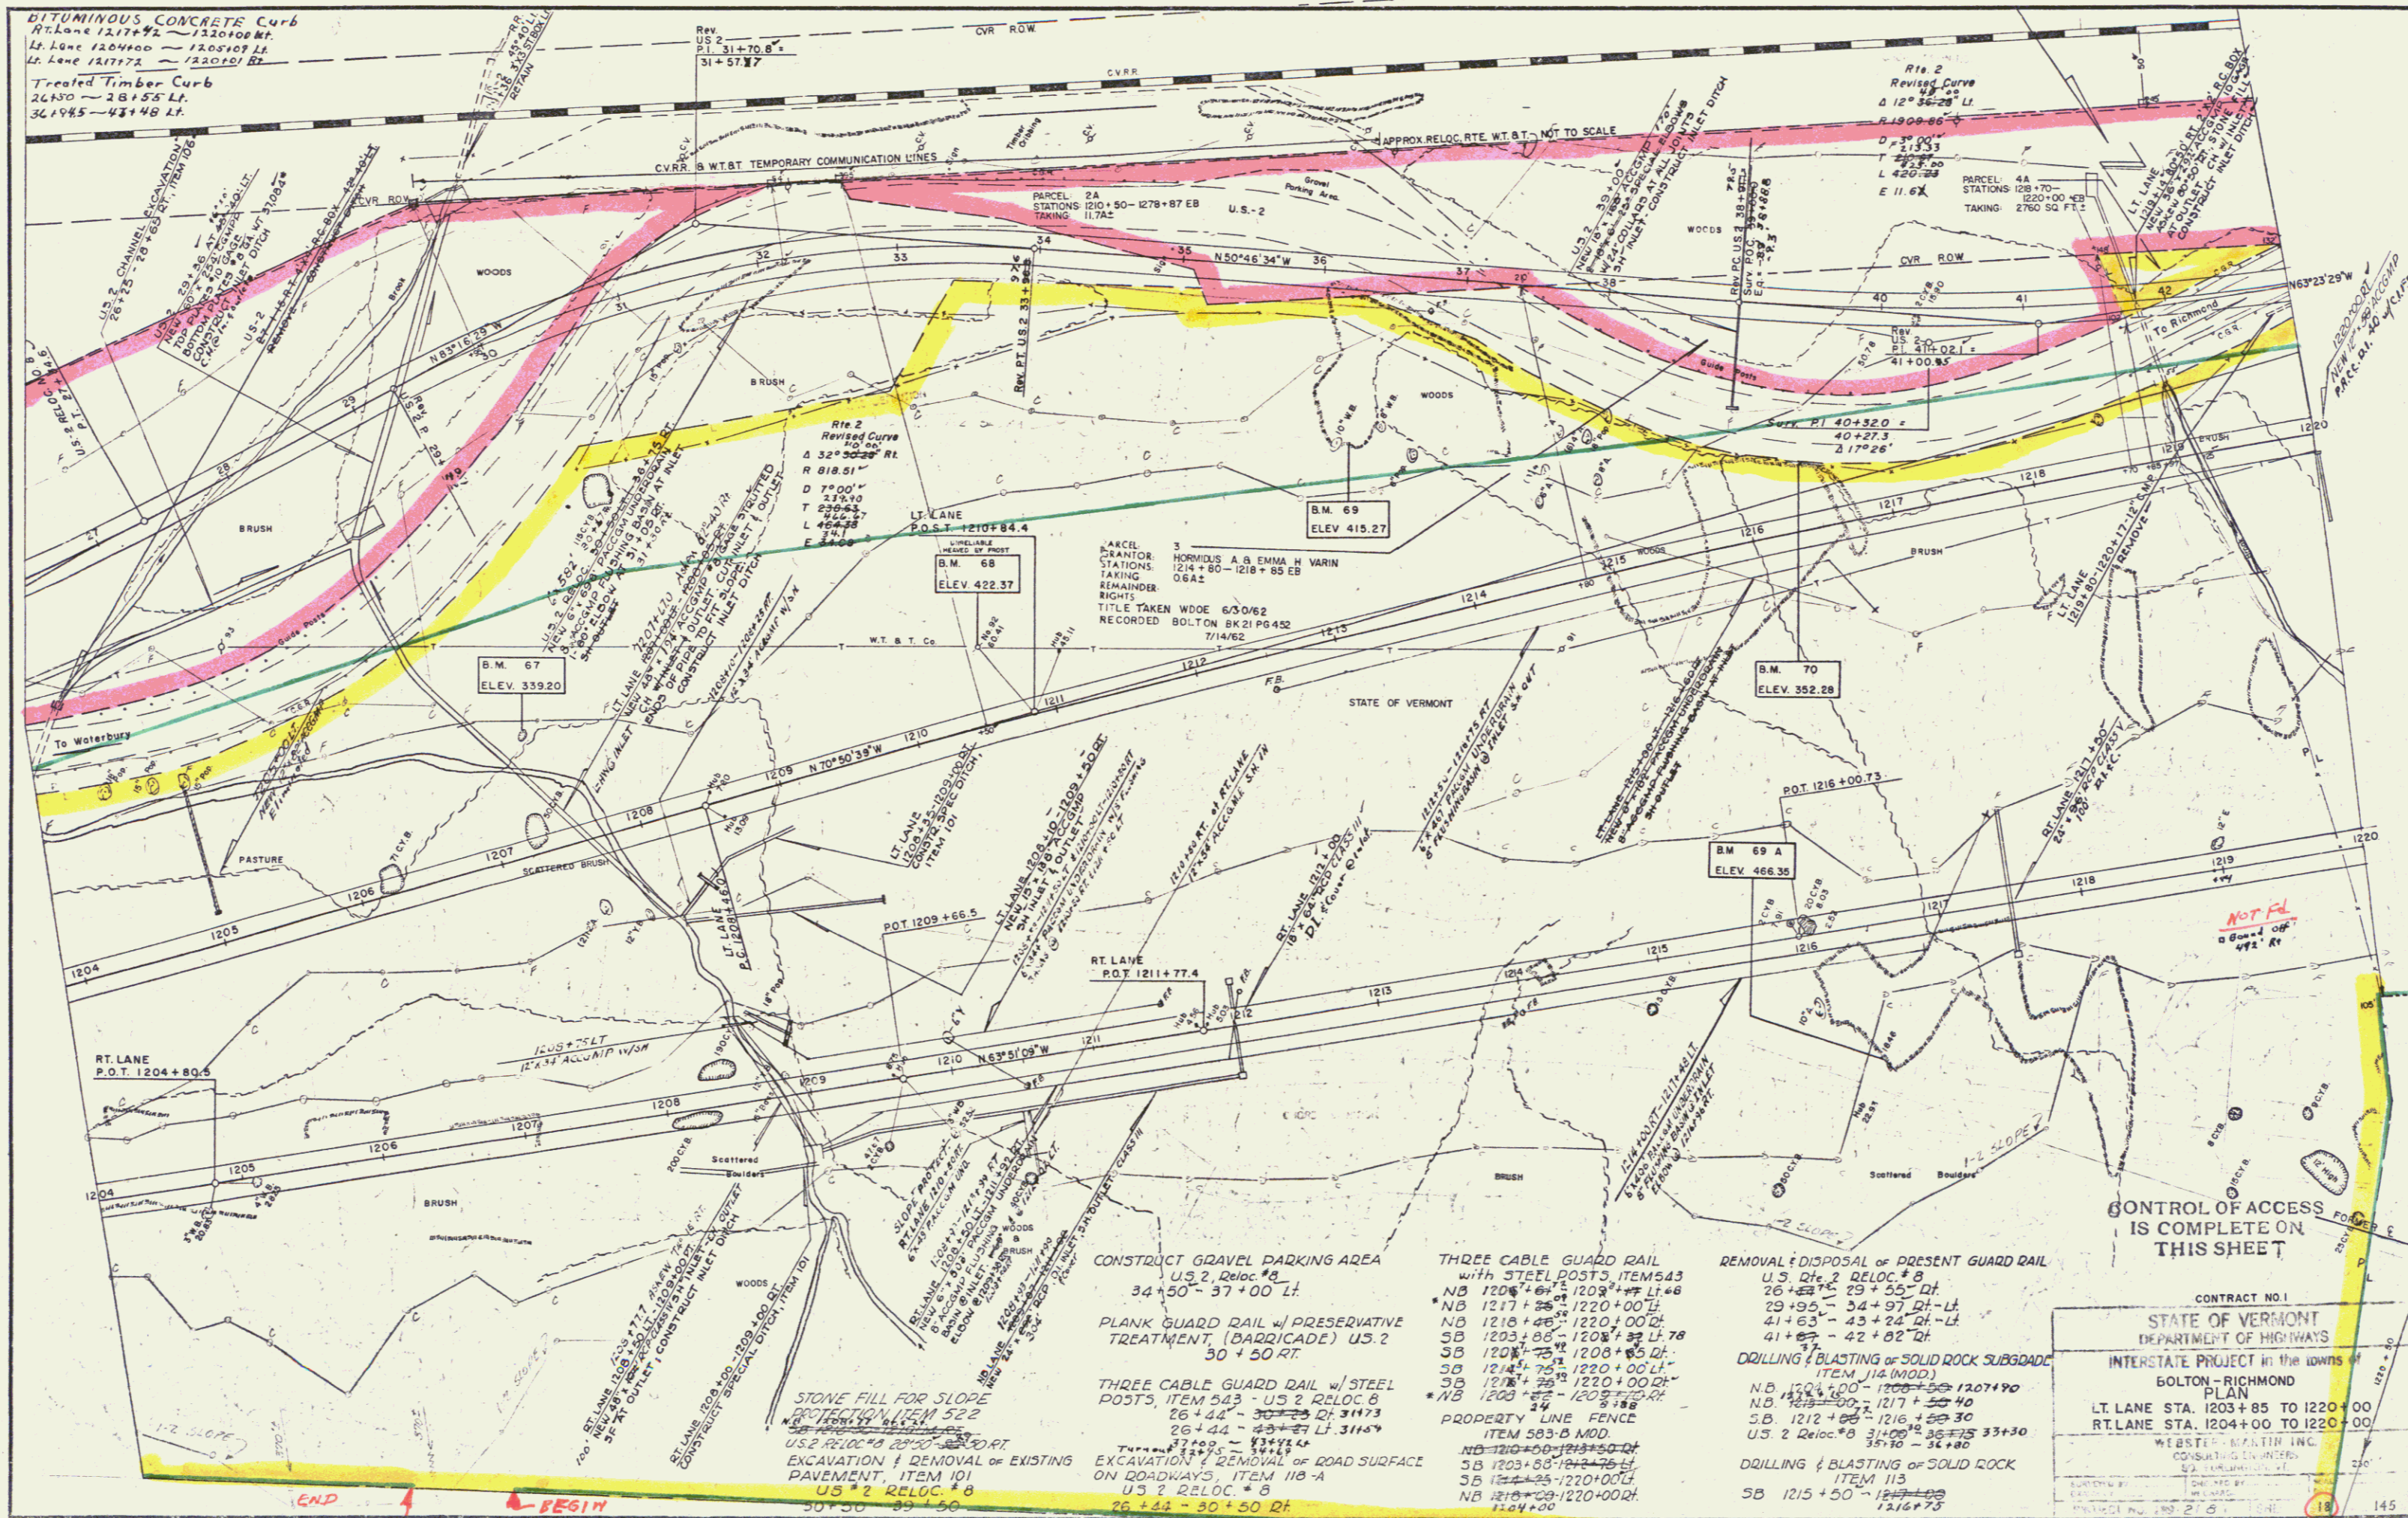

CONSTRUCT GRAVEL PARKING AREA
 U.S. 2, Reloc. #8
 34+50 - 37+00 Lt.

PLANK GUARD RAIL w/ PRESERVATIVE
 TREATMENT, (BARRICADE) U.S. 2
 30+50 RT.

THREE CABLE GUARD RAIL w/ STEEL
 POSTS, ITEM 543 - U.S. 2 RELOC. #8
 26+44 - 30+50 Lt. 31173

EXCAVATION & REMOVAL OF ROAD SURFACE
 ON ROADWAYS, ITEM 116-A
 U.S. 2 RELOC. #8
 26+44 - 30+50 Rt.

THREE CABLE GUARD RAIL
 WITH STEEL POSTS, ITEM 543
 NB 1206+61 - 1208+77 Lt. #8
 NB 1217+26 - 1220+00 Lt.
 NB 1218+86 - 1220+00 Rt.
 SB 1203+80 - 1208+77 Lt. #8
 SB 1208+77 - 1208+85 Rt.
 SB 1214+75 - 1220+00 Lt.
 SB 1218+75 - 1220+00 Rt.
 NB 1203+80 - 1203+77 Rt. #8

PROPERTY LINE FENCE
 ITEM 583-B MOD.
 NB 1210+00 - 1213+50 Rt.
 SB 1203+80 - 1214+75 Lt.
 SB 1214+75 - 1220+00 Lt.

DRILLING & BLASTING OF SOLID ROCK
 ITEM 113
 NB 1204+00 - 1208+77 1207+90
 NB 1208+77 - 1217+50 40
 SB 1212+00 - 1216+30
 U.S. 2 Reloc. #8 31+00 - 36+75 33+30
 35+10 - 36+80

DRILLING & BLASTING OF SOLID ROCK
 ITEM 113
 SB 1215+50 - 1216+75

REMOVAL & DISPOSAL OF PRESENT GUARD RAIL
 U.S. 2, RELOC. #8
 26+80 - 29+55 Lt.
 29+95 - 34+97 Rt. - Lt.
 41+63 - 43+24 Rt. - Lt.
 41+63 - 42+02 Rt.

DRILLING & BLASTING OF SOLID ROCK
 ITEM 114 (MOD.)
 NB 1204+00 - 1208+77 1207+90
 NB 1208+77 - 1217+50 40
 SB 1212+00 - 1216+30
 U.S. 2 Reloc. #8 31+00 - 36+75 33+30
 35+10 - 36+80

DRILLING & BLASTING OF SOLID ROCK
 ITEM 113
 SB 1215+50 - 1216+75

CONTROL OF ACCESS
 IS COMPLETE ON
 THIS SHEET

CONTRACT NO. 1
 STATE OF VERMONT
 DEPARTMENT OF HIGHWAYS
 INTERSTATE PROJECT in the towns of
 BOLTON-RICHMOND
 PLAN
 LT. LANE STA. 1203+85 TO 1220+00
 RT. LANE STA. 1204+00 TO 1220+00
 WESTFIELD CONSULTING ENGINEERS
 CONSULTING ENGINEERS
 145

Sheet 3 cont. + Box
 3