

- NO 1 TITLE PAGE
- 2 TYPICAL CROSS-SECTION OF IMPROVEMENT BITUMINOUS CONCRETE PAVEMENT,
- 3 QUANTITY SHEET (ITEMS) ITEM 351-B, MOD.
- 4 QUANTITY SHEET (WDM/MS)
- 5-7 EARTHWORK SHEETS
- 8-17 PLAN AND PROFILE SHEETS
- 18 BRIDGE SHEET (408+09.9) TYPICAL AND DETAILS
- 19 BRIDGE SHEET (408+65.9) REINFORCING STEEL SCHEDULE
- 20 BRIDGE SHEET (471+00.0) TYPICAL
- 21 BRIDGE SHEET (471+50.2) DETAILS OF ABUTMENTS NOS. 1 & 2
- 22 BRIDGE SHEET (471+50.2) SUPERSTRUCTURE DETAILS
- 23 EARTHWORK SHEET (BRIDGE) 471+50.2
- 24 BRIDGE SHEET (471+50.2) REINFORCING STEEL SCHEDULE
- 25 BRIDGE SHEET (496+25.2) TYPICAL AND DETAILS
- 26 BRIDGE SHEET (496+25.2) DETAILS OF ABUTMENTS NOS. 1 & 2
- 27 BRIDGE SHEET (496+25.2) SUPERSTRUCTURE DETAILS
- 28 EARTHWORK SHEET (BRIDGE) 496+25.2
- 29 BRIDGE SHEET (496+25.2) REINFORCING STEEL SCHEDULE
- 30 BRIDGE SHEET (523+30.2) LOCATION AND BARREL DETAILS
- 31 BRIDGE SHEET (523+30.2) APRON AND WING DETAILS
- 32 BRIDGE SHEET (523+30.2) REINFORCING STEEL SCHEDULE
- 33 STANDARD BRIDGE SHEET 59-20-56
- 34-35 STANDARD BRIDGE SHEETS 59-42-56'
- 36-37 STANDARD BRIDGE SHEETS 59-50-57
- 38 STANDARD BRIDGE SHEET 59-AS 15° SKEW-57
- 39 STANDARD BRIDGE SHEET 59-AS 30-57
- 40 STANDARD BRIDGE SHEET 59-21
- 41 A-GI (SLOPES IN SOLID ROCK)
- 42 B-1 (BANKING TABLES)
- 43 G-4 (STEEL MARKER POSTS)
- 44 J-1 (PROJECT MARKERS)
- 45 RS-56-4 (DRAINAGE)
- 46 RS-56-6 (TYPICAL SLOPE GRADING)
- 47 RS-56-11 (TYPICAL CABLE GUARD RAIL WITH STEEL POSTS)
- 48 RS-56-12 (GUARDRAILS, SIGNS AND LIGHTS)
- 49 RS-57-9 (UNDERDRAIN FLUSHING BASIN)
- 50-125 CROSS-SECTIONS
- 130-138 CHANNEL SECTIONS

STATE OF VERMONT
DEPARTMENT OF HIGHWAYS

Proposed Improvement

TOWNS OF MANCHESTER-DORSET

COUNTY OF BENNINGTON



U.S. ROUTE 7 VT 7A

MANCHESTER - DANBY ROAD

PROJECT NAME & NUMBER TYPE PAVEMENT AREA
MANCHESTER-DORSET F-019-2(5) 3" BIT. CONC. PAVE. 39,360 sq
RECORD PLANS
MATERIALS
REINFC. CONC. PIPE - VERMONT CONCRETE PIPE CO. - WINDSOR, VT.
ACCG. METAL PIPE - N.E. MET. CULV. CO. - WHITE RIVER JCT., VT.
CEMENT - IRON CLAD CEMENT CO. - GLENS FALLS, N.Y.
AGGREGATES & BIT. CONC. PAVE. - WEDDALEY, INC. - SOUTH FTSBURY, VT.
REINFC. STEEL S. GUARD RAIL CABLE - BETHLEHEM STEEL CO. - BETHLEHEM, PA.
STRUCT. STEEL - VT. STRUCTURAL STEEL CO. - BURLINGTON, VT.
TAR & ASPHALT - BARRETT CO. - EVERETT, MASS.
GRAVEL - STREBE, RT & GUNTHER PIT - DORSET, VERMONT.
PEA STONE - W.E. DAILEY, INC. - MANCHESTER, VERMONT.
CONTRACTOR - S.V. ROSSI CONST. CO. INC.
RESIDENT ENGINEER - T. KAMBOUR.
INSPECTOR - F. REED.
RECORD PLANS - T. KAMBOUR.
CONTRACT DATED - DECEMBER 18, 1958.
CONTRACT STARTED - MARCH 24, 1959.
CONTRACT COMPLETED - NOVEMBER 3, 1959.
CONTRACT ACCEPTED - NOVEMBER 3, 1959.

LENGTH OF ROADWAY 12,110.5 FEET = 2.294 MILES
LENGTH OF BRIDGES 138.0 FEET = 0.026 MILE
LENGTH OF PROJECT 12,248.5 FEET = 2.320 MILES

ADT 1955 2000
ADT 1960 3300
DHW 455
D 60%
T 8%

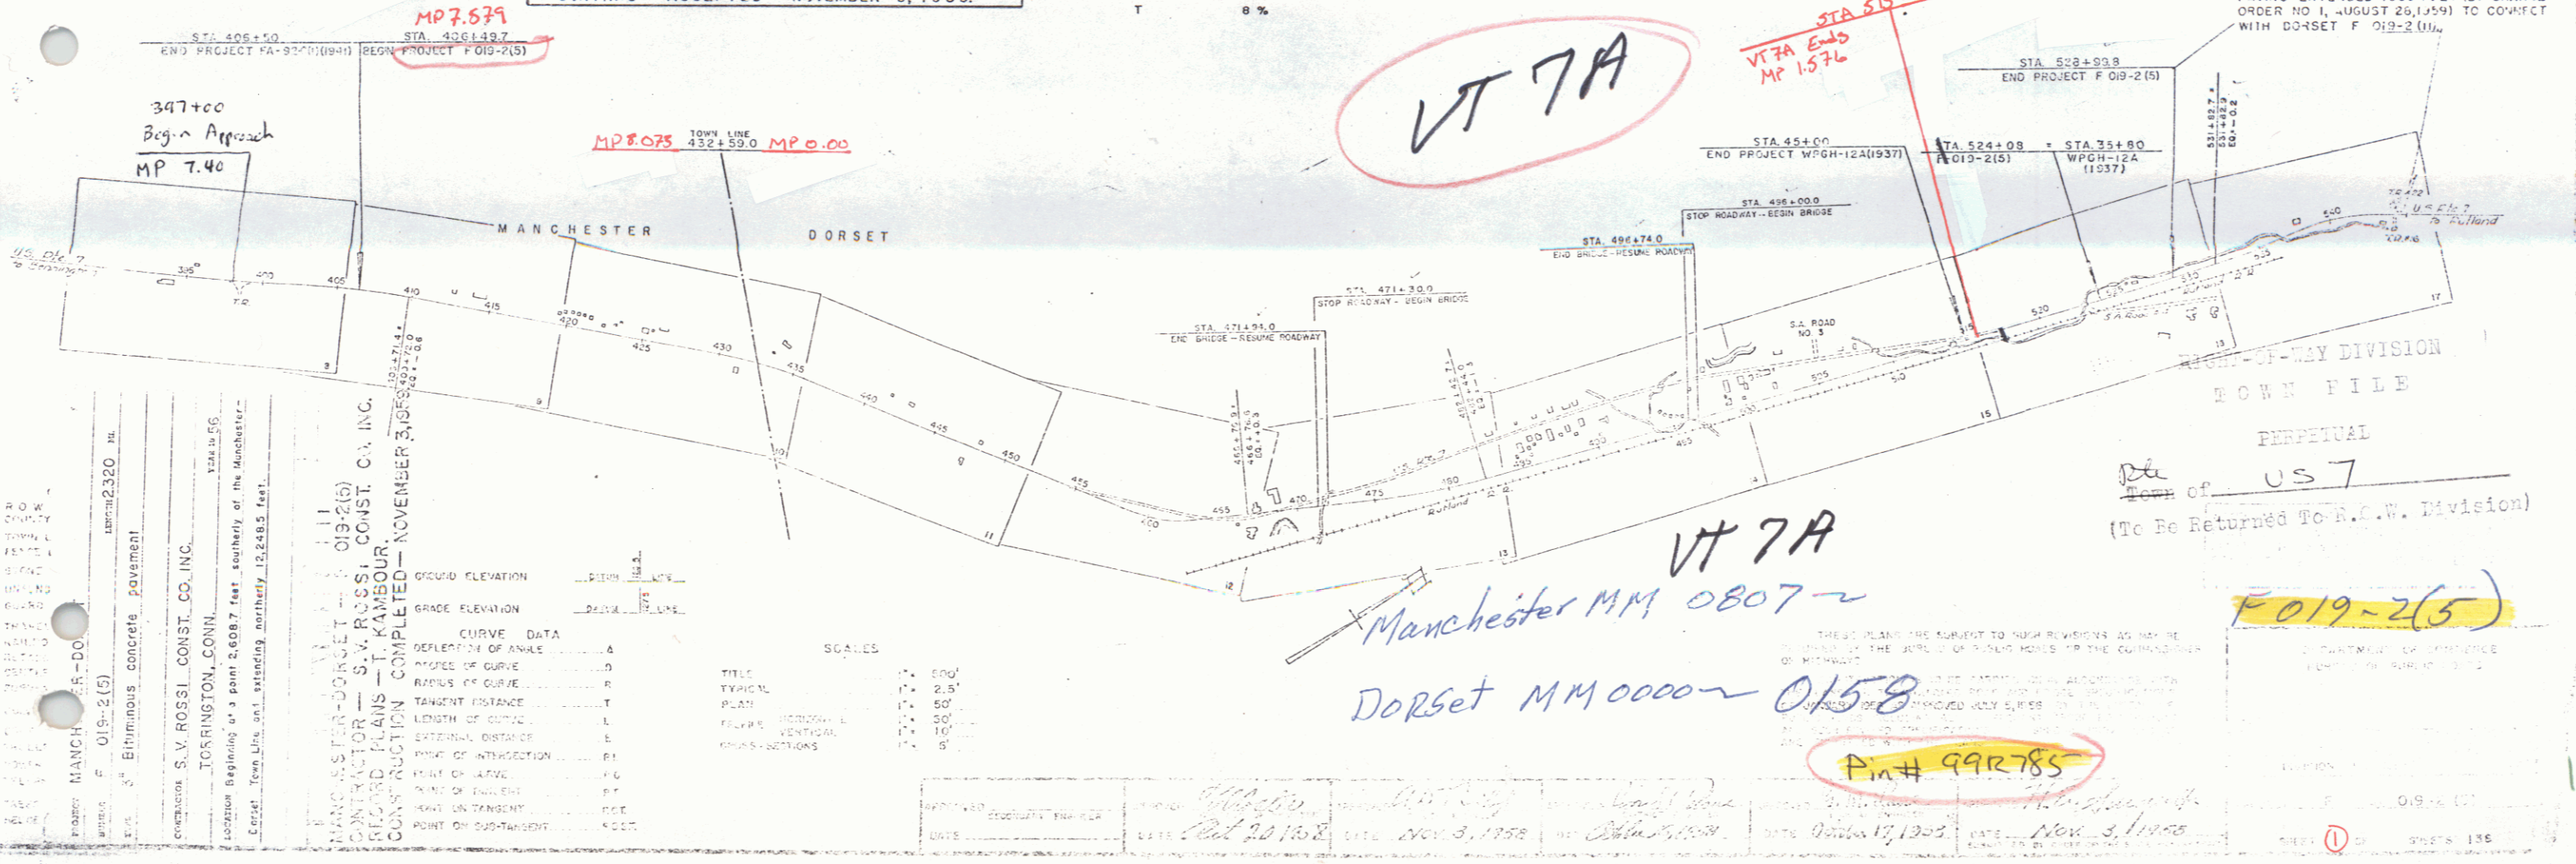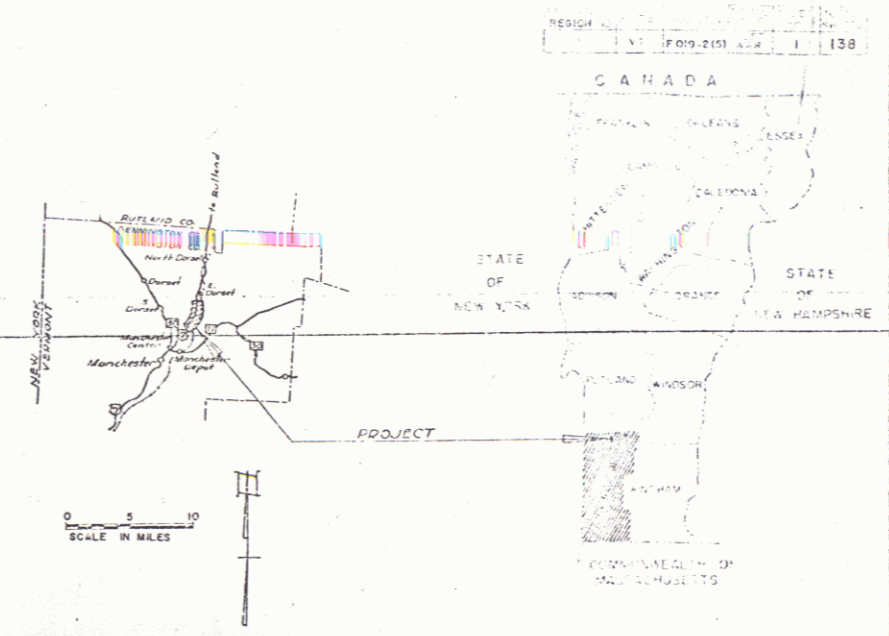

MANCHESTER-DORSET
CONTRACTOR - S.V. ROSSI CONST. CO. INC.
RESIDENT ENGINEER - T. KAMBOUR
INSPECTOR - F. REED
RECORD PLANS - T. KAMBOUR
CONSTRUCTION COMPLETED - NOVEMBER 3, 1959

DEFLECTION OF ANGLE	4
ANGLE OF CURVE	10
RADIUS OF CURVE	100
TANGENT DISTANCE	100
LENGTH OF CURVE	100
EXTERNAL DISTANCE	100
POINT OF INTERSECTION	PI
POINT OF CURVE	PC
POINT OF TANGENCY	PT
POINT OF SUPER-TANGENCY	PST

TITLE	SCALE
TYPICAL	1" = 20'
PLAN	1" = 50'
PROFILE	1" = 10'
CROSS-SECTIONS	1" = 5'

APPROVED: _____ DATE: Oct 20, 1958
 DATE: Oct 20, 1958
 DATE: Oct 20, 1958
RIGHT-OF-WAY DIVISION
TOWN FILE
PERPETUAL
Date of _____
(To Be Returned To R.O.W. Division)

F-019-2(5)

Pin# 99R785