
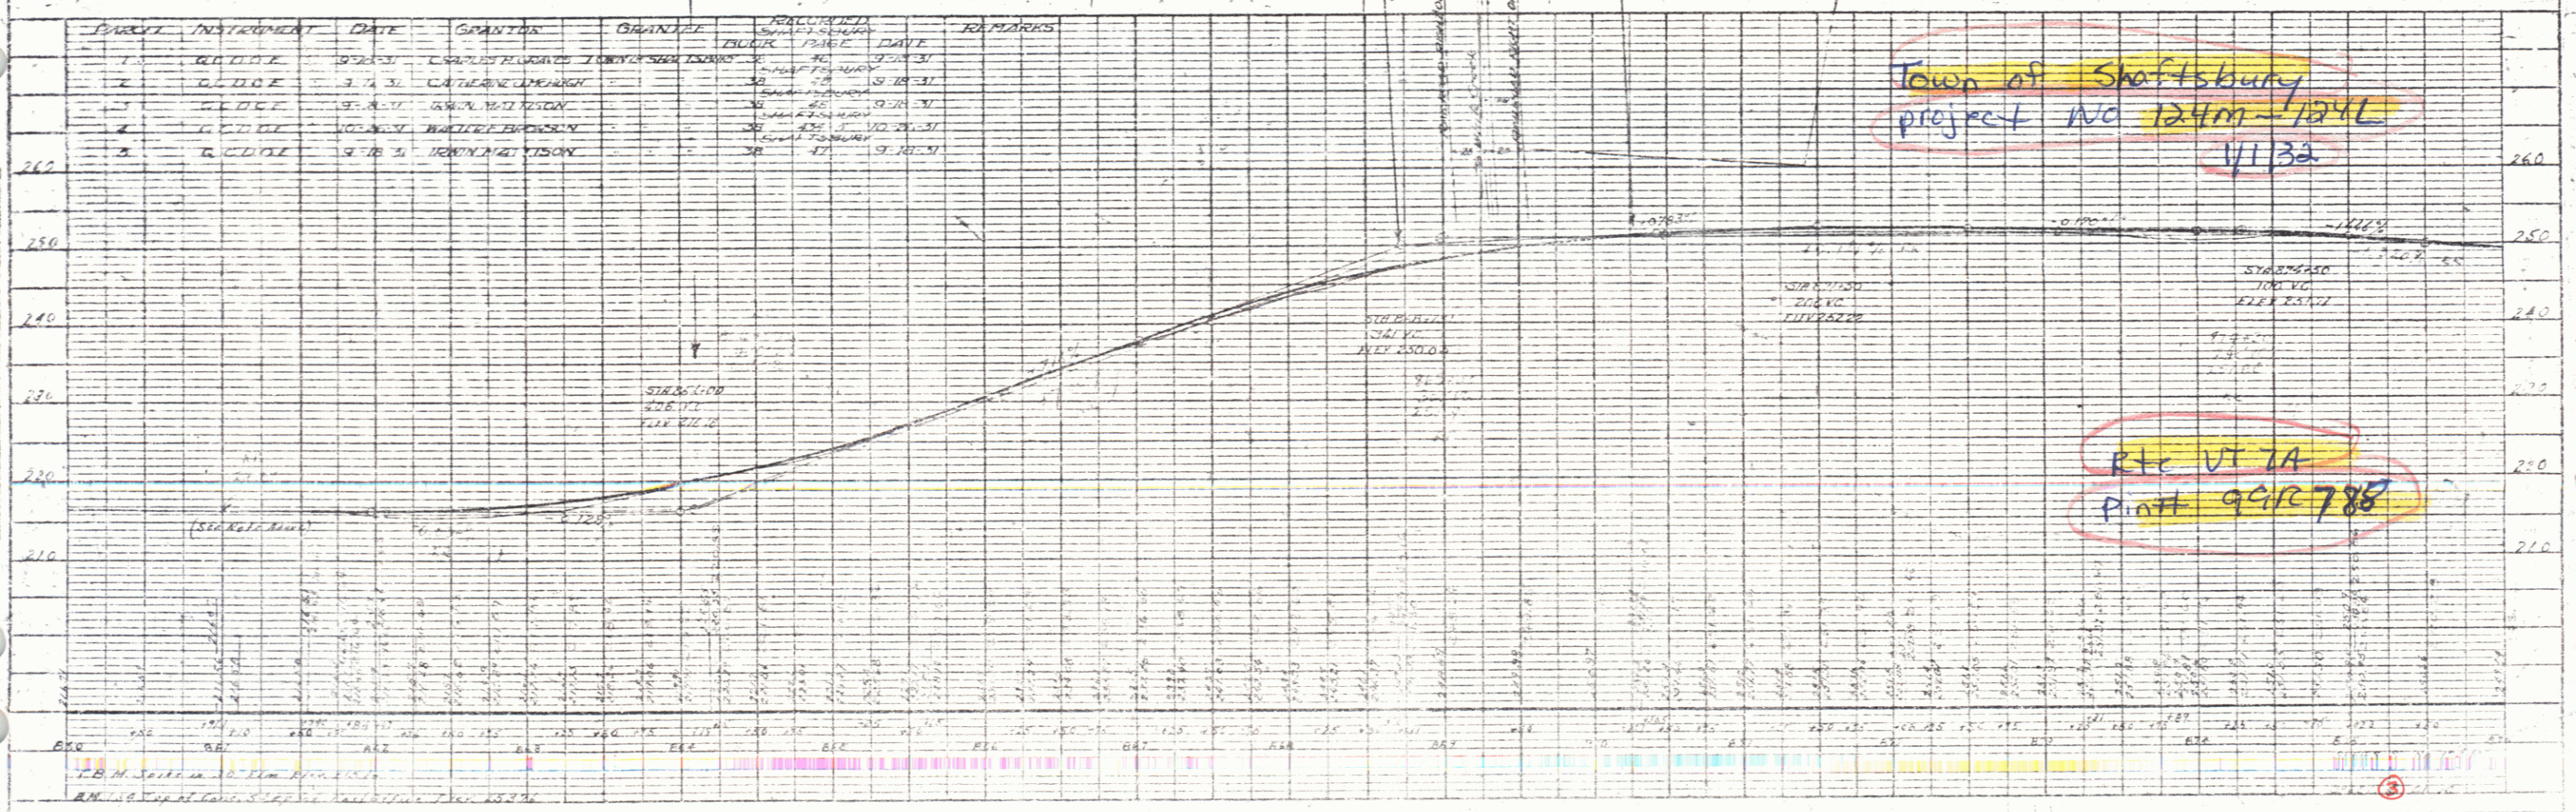


REINFORCED CONCRETE PIPE CULVERTS				CONCRETE CURB DOWNED TO 11" H ₂ O				GROUTED CORBLE GUTTER			
STATIONS	SIZE	LENG.	CONCR. PIPE	STA.	LENG.	CONC. H	REIN. SHAL.	STA.	LENG.	INCHES	INCHES
873+00-873+12	18"	12.00	46"	865+70-865+70	1.00	3.00	2.0"	864+00-864+00	10'	3.6"	4.5"
873+12-873+23 1/2	18"	11.50	25"	870+30-870+30	1.00	3.00	2.0"	864+30-864+30	10'	3.6"	4.5"
872+25-872+23 1/2	18"	1.75	33"	870+30-870+30	1.00	2.80	1.64"	865+60-865+60	10'	3.6"	4.5"

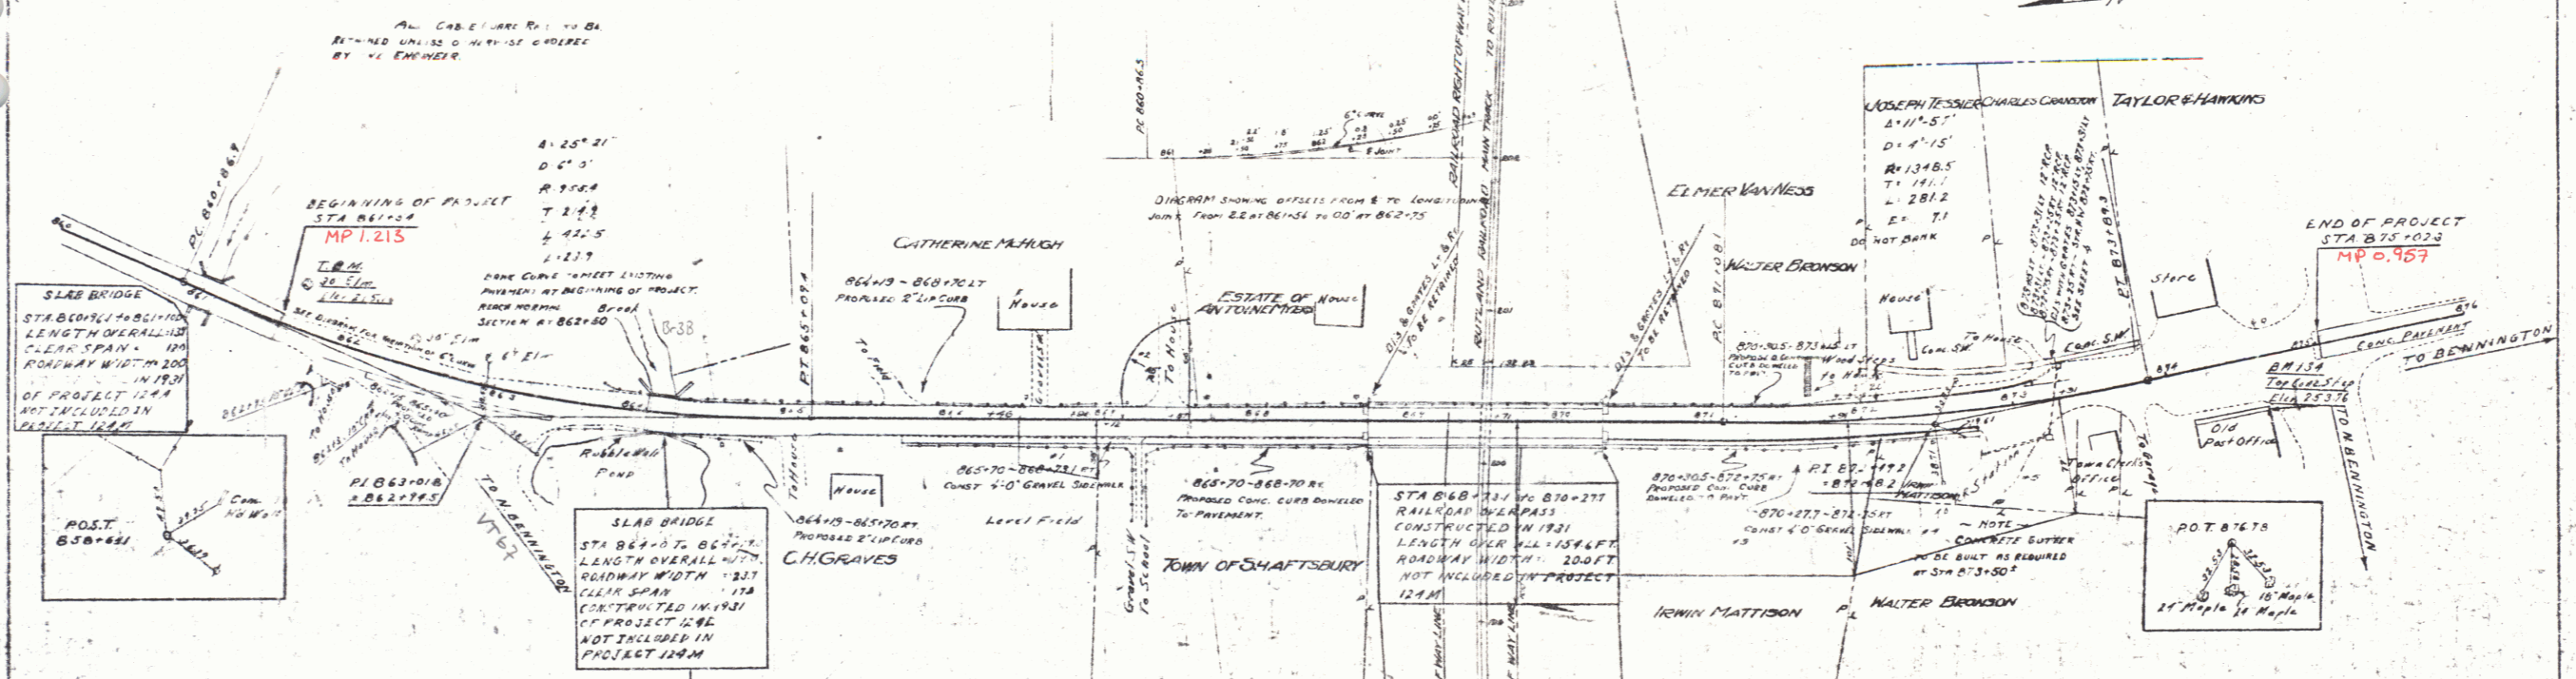

PARCEL	INSTRUMENT	DATE	GRANTOR	GRANTEE	RECORDED	REMARKS
1	60112	10-23-31	CATHERINE MARSH	WALTER BRONSON	30	
2	60112	3-7-31	CATHERINE MARSH	WALTER BRONSON	30	
3	60112	9-8-31	WALTER BRONSON	IRWIN MATTISON	30	
4	60112	9-10-31	IRWIN MATTISON	WALTER BRONSON	30	

Town of Shaftsbury
 project no 124m-124L
 4/1/32

PLC VT 7A
 PLAT 9CH 788

PLAN
 DATE
 BY
 CHECKED
 APPROVED

PROFILE
 DATE
 BY
 CHECKED
 APPROVED