

INDEX OF SHEETS

Searsburg BP 010-1-7506

Sheet #	Description	Date	Revisions
1.	Title Sheet		
2.	Typical Sections		
3.	Summary of Quantities & Item Detail Sheet		
4.	Item Detail & Drainage Sheet		
5.	Earthworks		
10.	E.O.W. Plan Sheets		
11-13.	Plan Profile Sheets		
14-15.	Blank		
16.	A-61 Typical For Slopes in Solid Rock Excavation and Drilling and Blasting of Solid Rock Subgrade	4/23/75	R
17.	B-1 Banking Tables	12/08/71	
18.	B-5 Slope Rounding	12/06/71	
19.	D-2 Headwalls and Underdrain	3/04/75	R
20.	D-4 Flushing Basins & Extension Service Box and Curb Stop	7/17/72	R
21.	D-6 RCDI (Use in Ditches)	4/04/75	
22.	Blank		
23.	D-11 Cast Iron Grate w/Frame Type A	4/25/72	R
24.	E-2 Construction Approach Signs	5/14/74	R
25.	E-5 Betterment Project Signs	9/11/73	R
26.	E-7 Delineation and Barricades for Construction Areas	9/19/73	R
27.	G-3 Guard Rail, Three Cable w/Steel Posts and Anchors for Three Cable Guard Rail w/Steel Posts	5/23/74	R
28.	T-2 Temporary Erosion Control Details	7/05/72	
29.	Blank		
30-42.	Cross Sections		

STATE OF VERMONT  
DEPARTMENT OF HIGHWAYS




PROPOSED IMPROVEMENT

TOWN OF SEARSBURG  
COUNTY OF BENNINGTON  
VERMONT ROUTE 9 - BENNINGTON - BRATTLEBORO ROAD

Plan # 99R 789


BEGINNING AT A POINT APPROXIMATELY 1.085 MILES EASTERLY OF THE WOODFORD - SEARSBURG TOWN LINE AND EXTENDING IN AN EASTERLY DIRECTION 0.615 MILES.

LENGTH OF ROADWAY 3246.8 FEET = 0.615 MILES  
LENGTH OF PROJECT 3246.8 FEET = 0.615 MILES

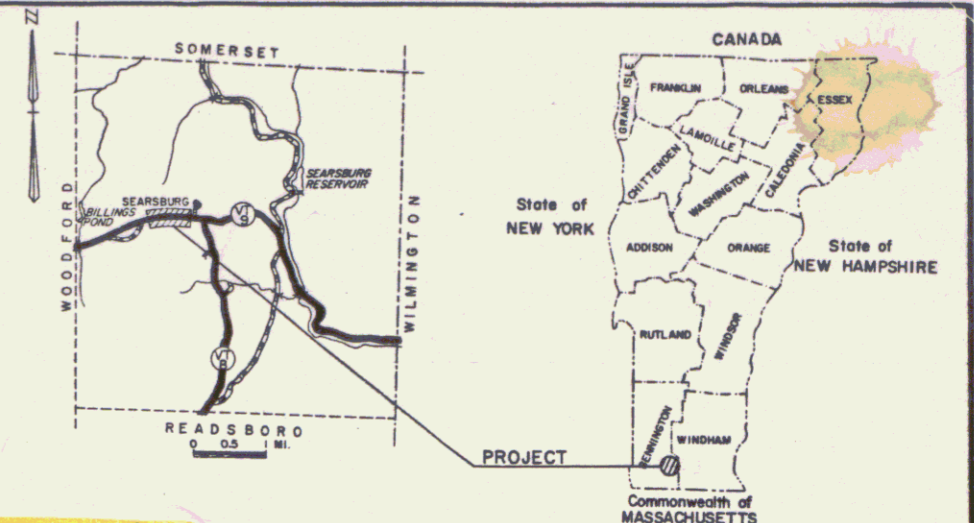

RECORD PLANS-MATERIALS

SEARSBURG BP 010-1-7506  
CONTRACTOR - W.H. MORSE - BENNINGTON, VT.  
CONTRACT DATED 1 JULY 1975  
CONSTRUCTION BEGAN - 9 JULY 1976  
CONSTRUCTION SUSPENDED 7 NOVEMBER 1975  
CONSTRUCTION RESUMED 17 MAY 1976  
CONSTRUCTION COMPLETED AND ACCEPTED 30 JUNE 1976  
RES. ENGR. NELSON E. BLANCHARD  
RECORD PLANS - PAUL E. SINGLETON

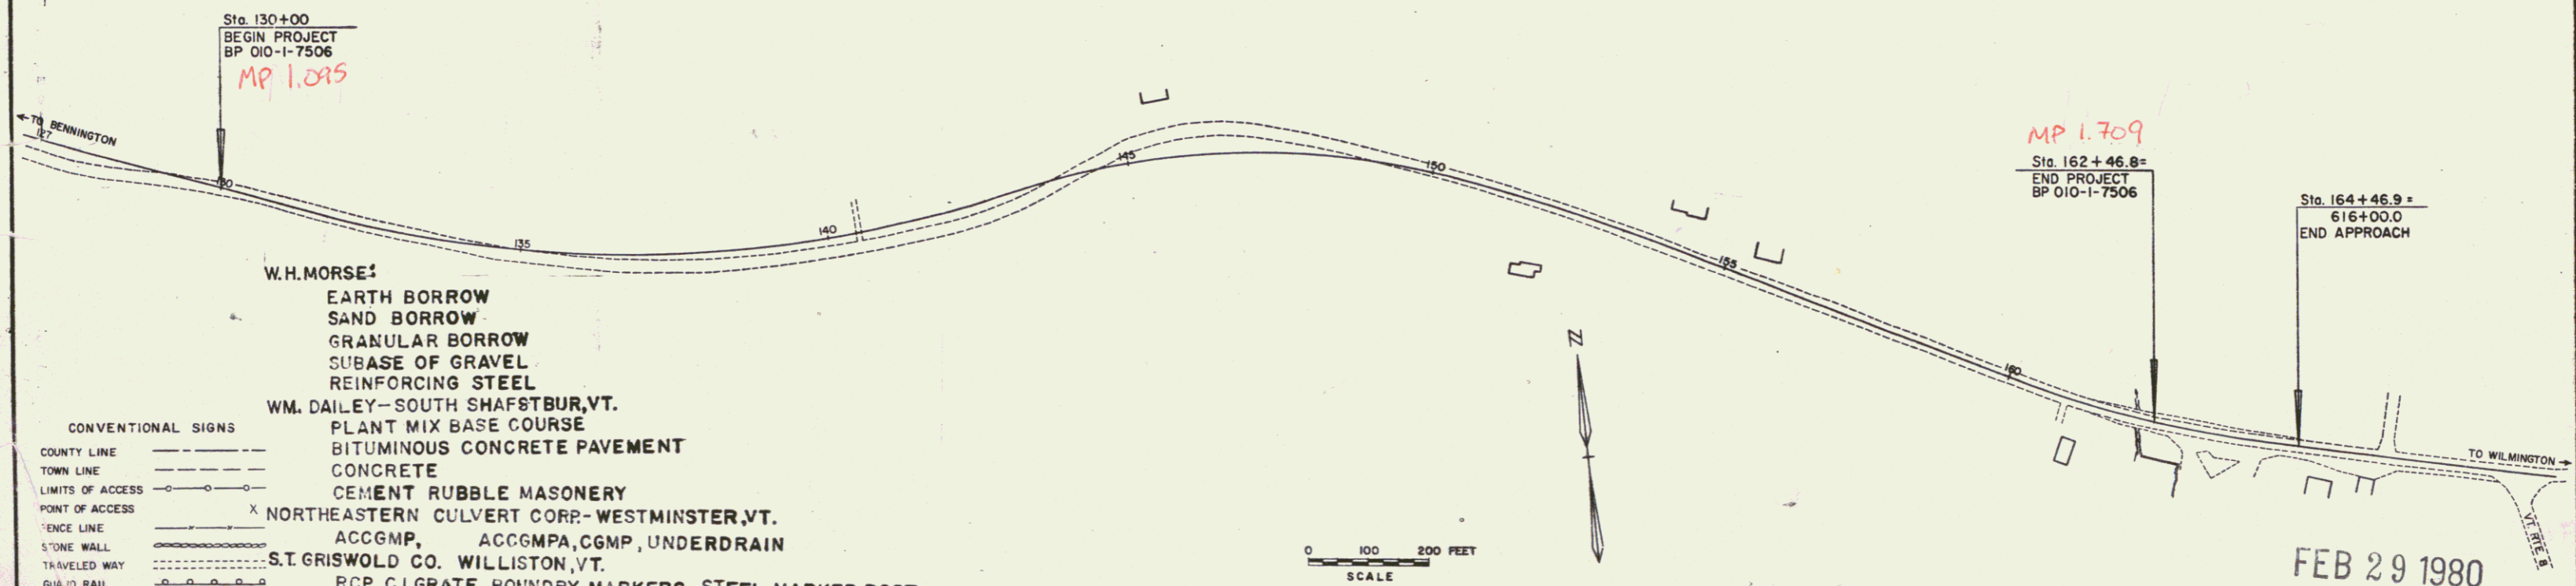

- CONVENTIONAL SIGNS
- COUNTY LINE
  - TOWN LINE
  - LIMITS OF ACCESS
  - POINT OF ACCESS
  - FENCE LINE
  - STONE WALL
  - TRAVELLED WAY
  - GUARD RAIL
  - RAILROAD
  - SURVEY LINE
  - CULVERT
  - POWER POLE
  - TELEPHONE POLE
  - TREES
  - PROPERTY LINE
  - STAKE
  - SLOPE RIGHTS
  - TOP OF CUT
  - TOE OF SLOPE

- W.H. MORSE:
- EARTH BORROW
  - SAND BORROW
  - GRANULAR BORROW
  - SUBBASE OF GRAVEL
  - REINFORCING STEEL
- WM. DAILEY - SOUTH SHAFSTBUR, VT.
- PLANT MIX BASE COURSE
  - BITUMINOUS CONCRETE PAVEMENT
  - CONCRETE
  - CEMENT RUBBLE MASONRY
- NORTHEASTERN CULVERT CORP. - WESTMINSTER, VT.
- ACCGMP, ACCGMPA, CGMP, UNDERDRAIN
- S.T. GRISWOLD CO. - WILLISTON, VT.
- RCP, C.I. GRATE, BOUNDARY MARKERS, STEEL MARKER POST
  - THREE CABLE GUARD RAIL W/ STEEL POSTS
- ALBANY ASPHALT AND AGG. CORP. - ALBANY, N.Y.
- BITUMINOUS SURFACE TREATMENT

These plans are subject to such engineering changes as may be required by the Federal Highway Administration or the Chief Engineer.

Construction is to be carried on in accordance with these plans and the Standard Specifications for Highway and Bridge Construction dated January 3, 1972 as approved by the Federal Highway Administration on December 28, 1971 for use on this project, including all subsequent revisions and such revised specification and special provisions as are incorporated in these plans.

APPROVED: *R. Munn* DATE 2-21-75  
CHIEF ENGINEER

DEPARTMENT OF TRANSPORTATION  
FEDERAL HIGHWAY ADMINISTRATION

APPROVED: *R. Senkins* DATE 2-21-75  
R.O.W. DIRECTOR

PROJECT BP NR 010-1-7506  
SHEET 1 OF 42 SHEETS  
SRS 12/17/70

FEB 29 1980