
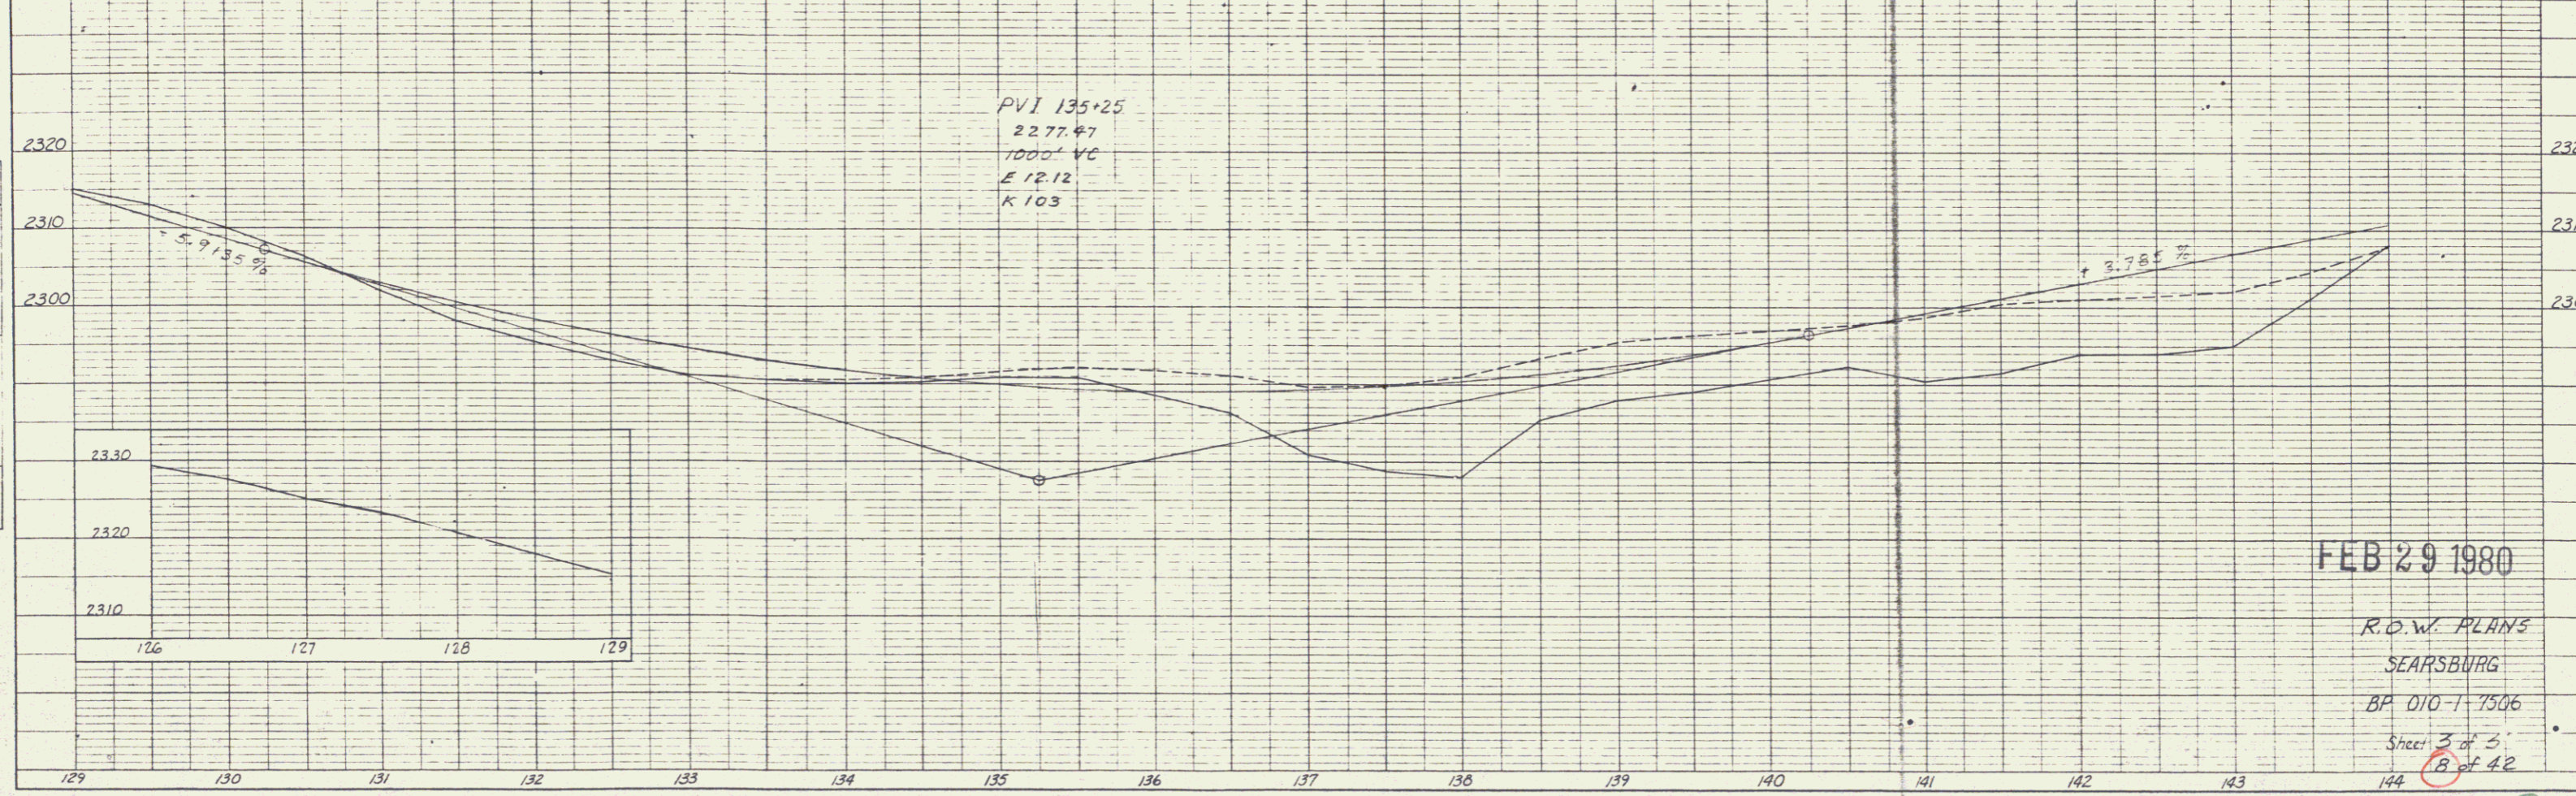


DATE	12/78
BY	G. SWANSON
DESIGNED BY	
CHECKED BY	
IN CHARGE	
NO.	

DATE	12/78
BY	G. SWANSON
DESIGNED BY	
CHECKED BY	
IN CHARGE	
NO.	

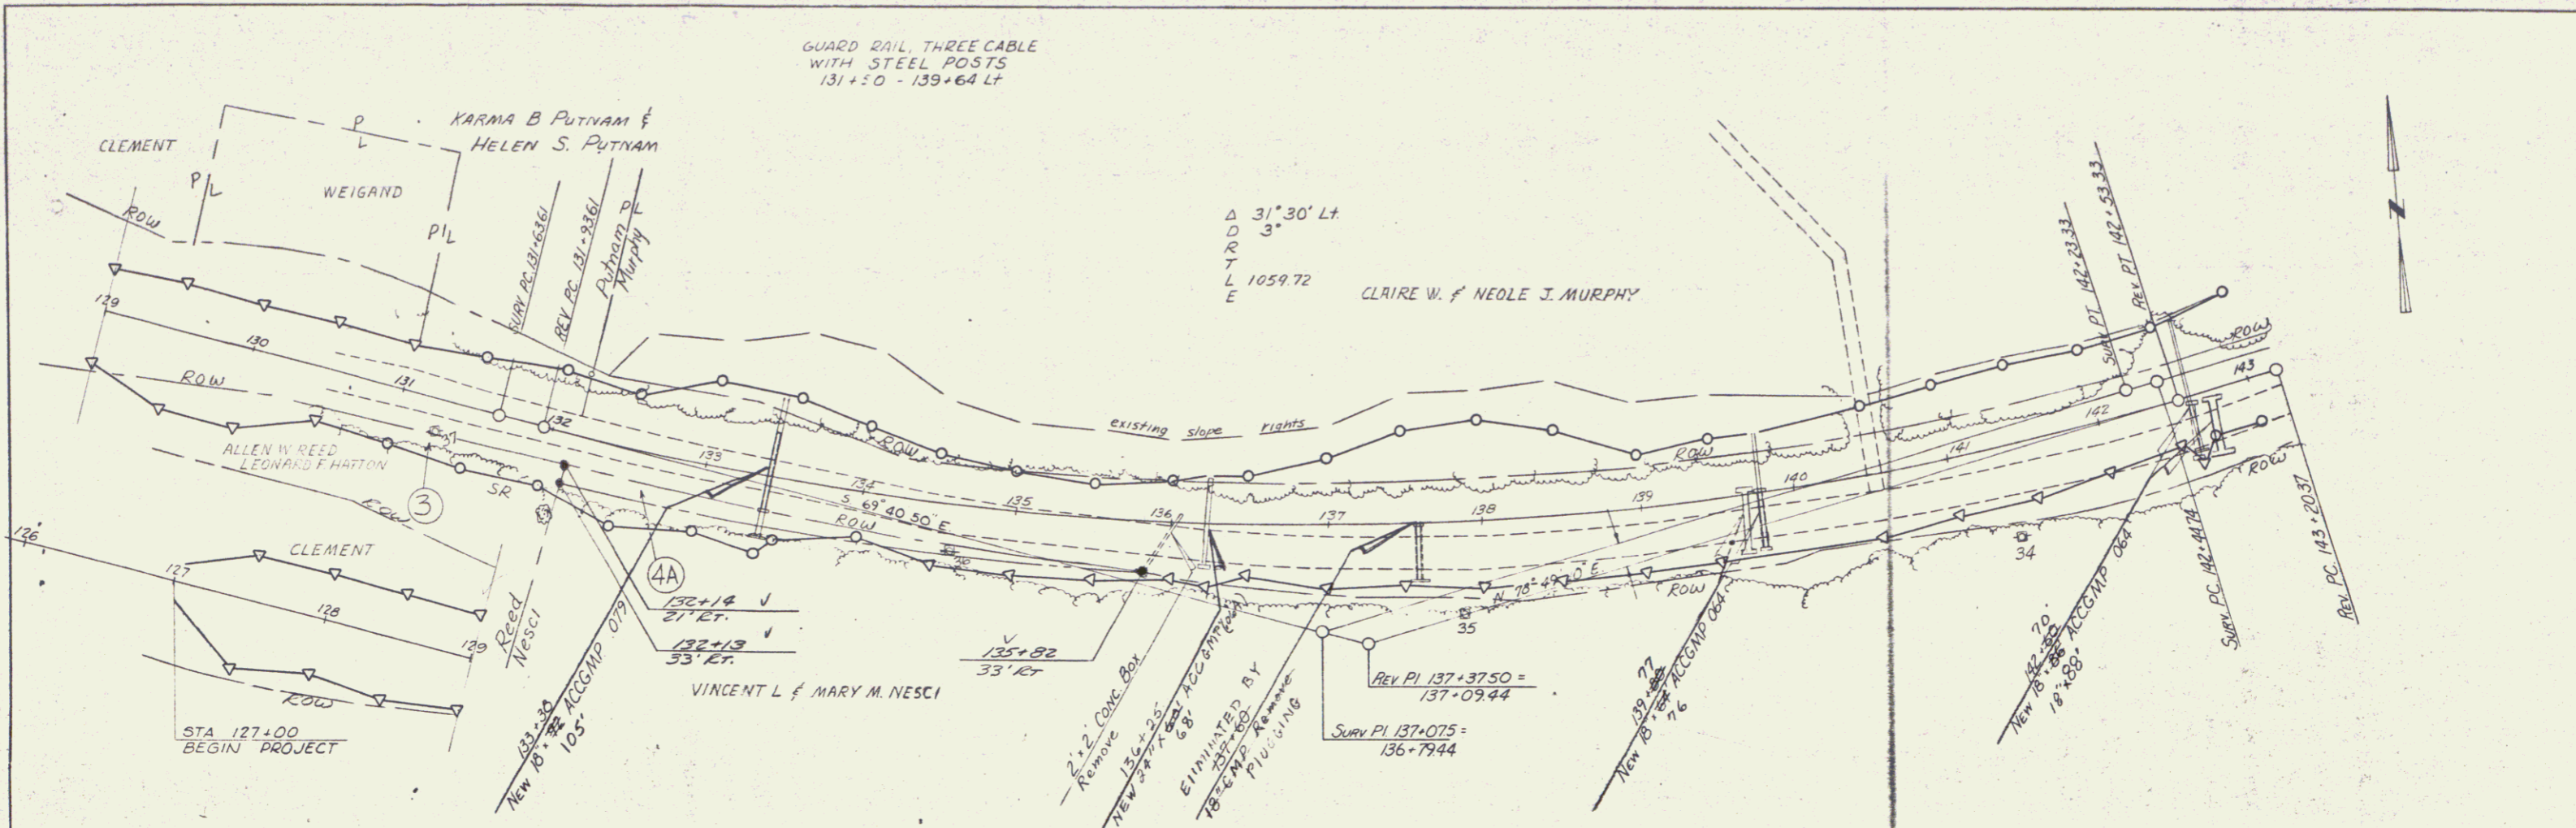

FEB 29 1980

R.O.W. PLANS
SEARSBURG
BP 010-1-1506
Sheet 3 of 5
8 of 42