
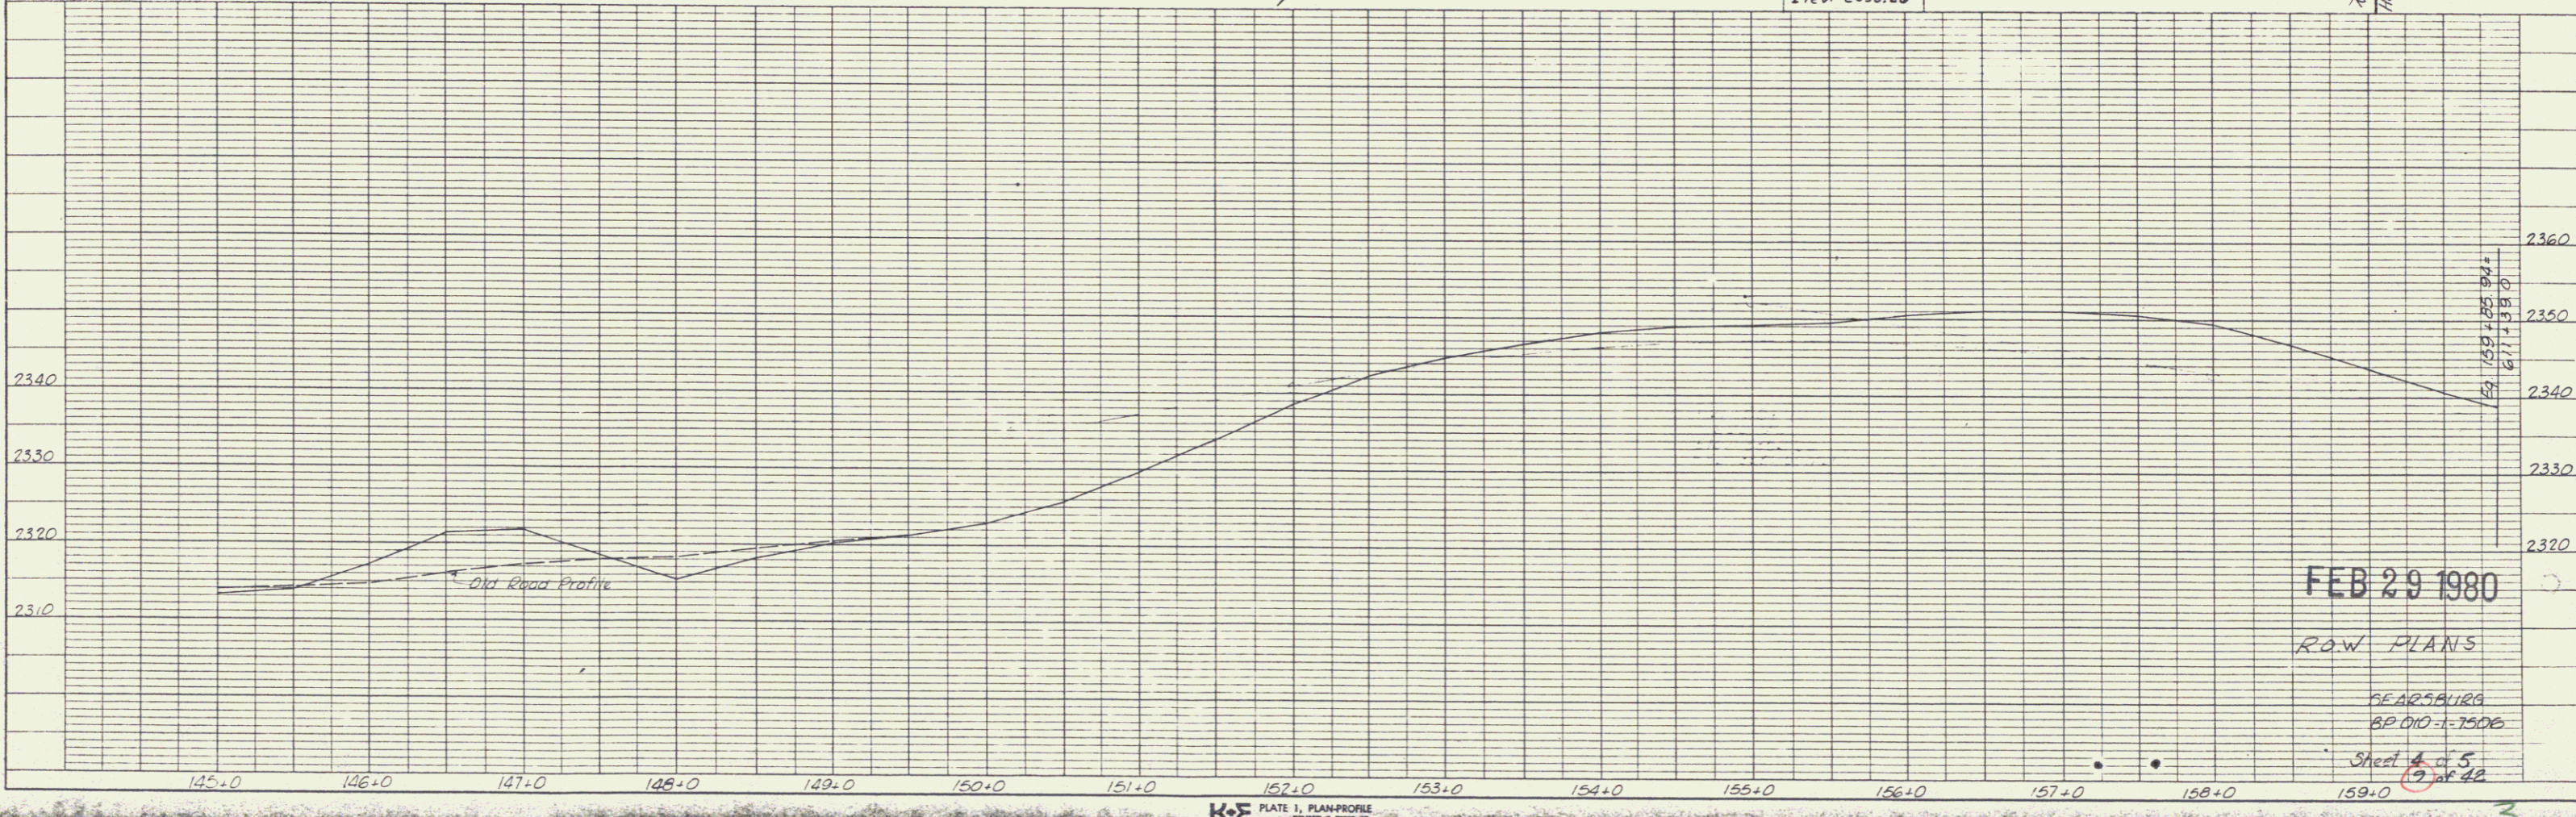


DATE: _____
 BY: _____
 CHECKED: _____
 PLANNING: _____
 NO. _____

DATE: _____
 BY: _____
 CHECKED: _____
 PROFILE: _____
 NO. _____

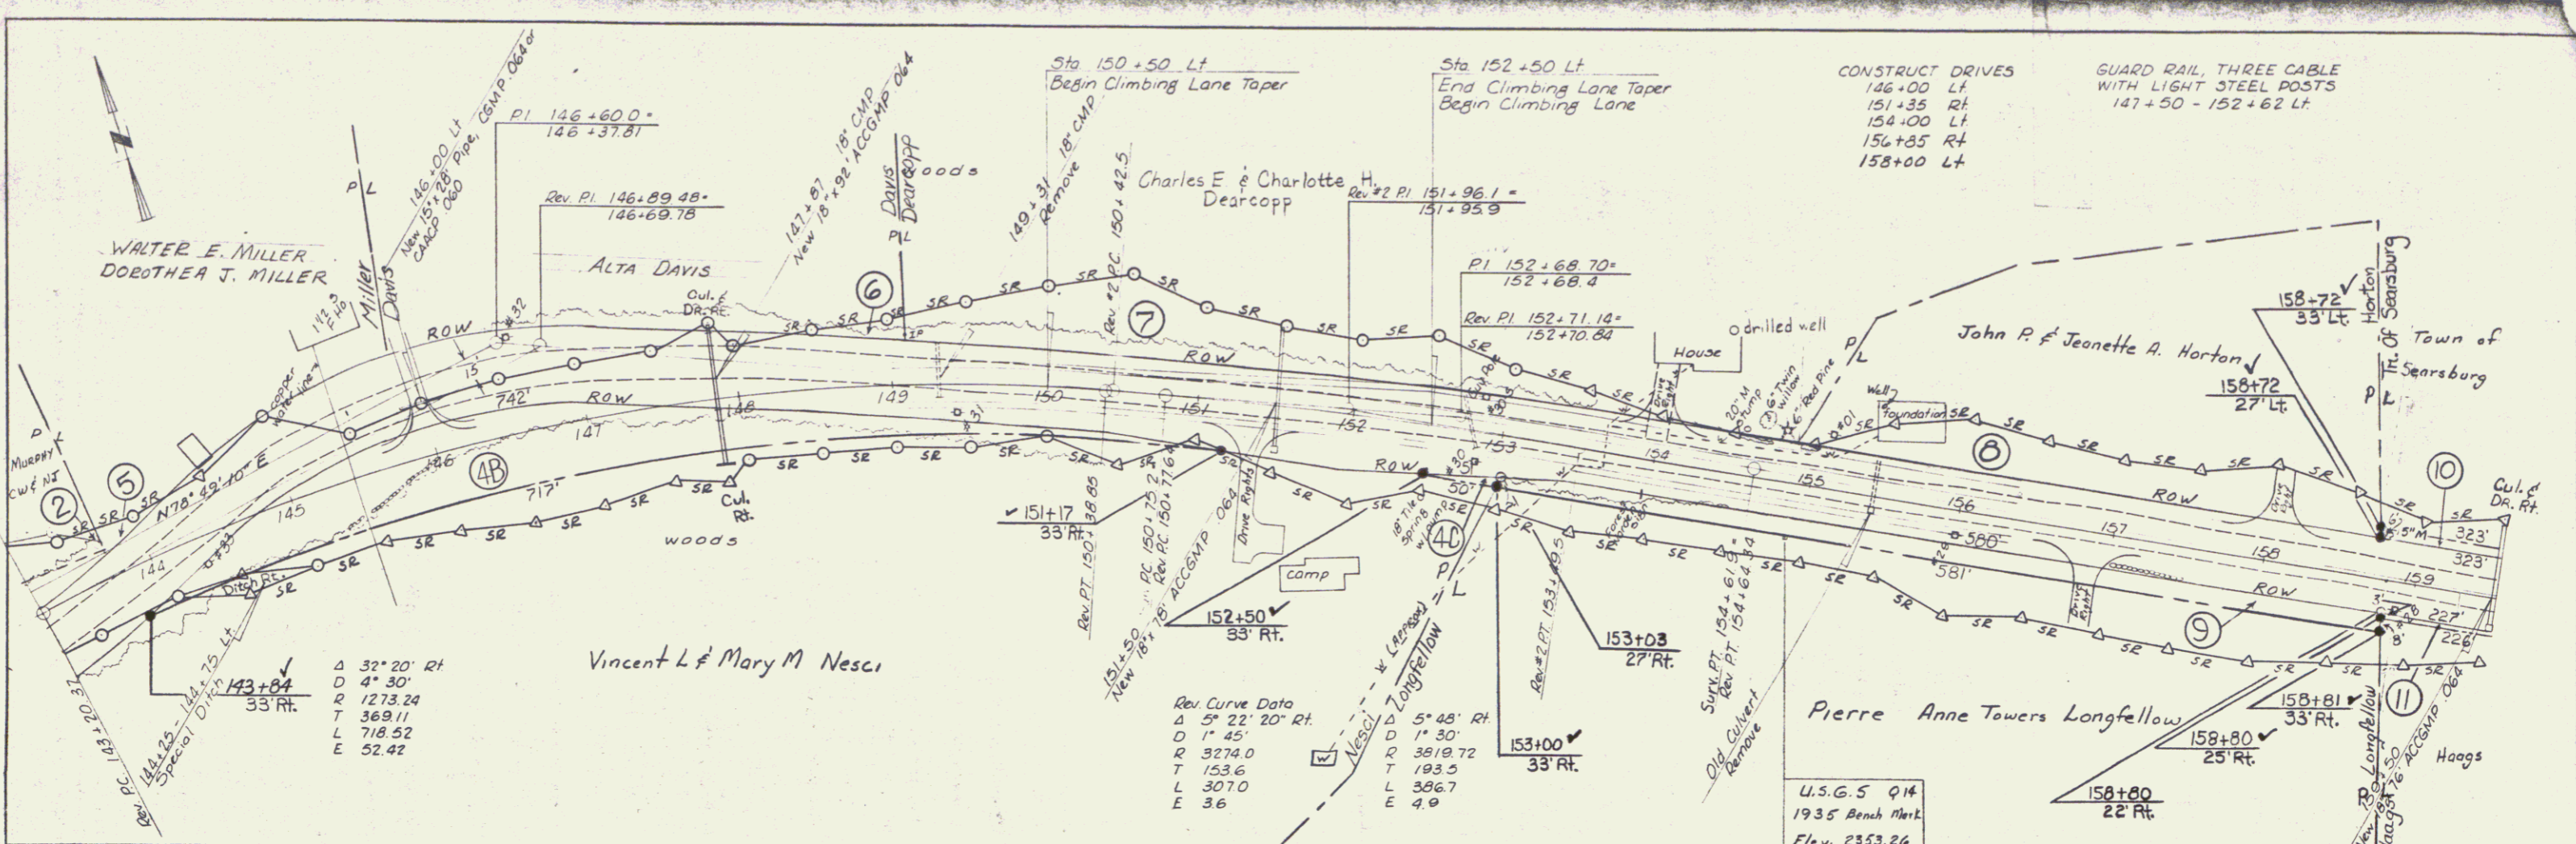

K&E PLATE 1, PLAN-PROFILE
 BEARSBURG, VA. ROAD CO.

FEB 29 1980

ROW PLANS

BEARSBURG
 BP 110-1-75.06

Sheet 4 of 5
 19 of 42