
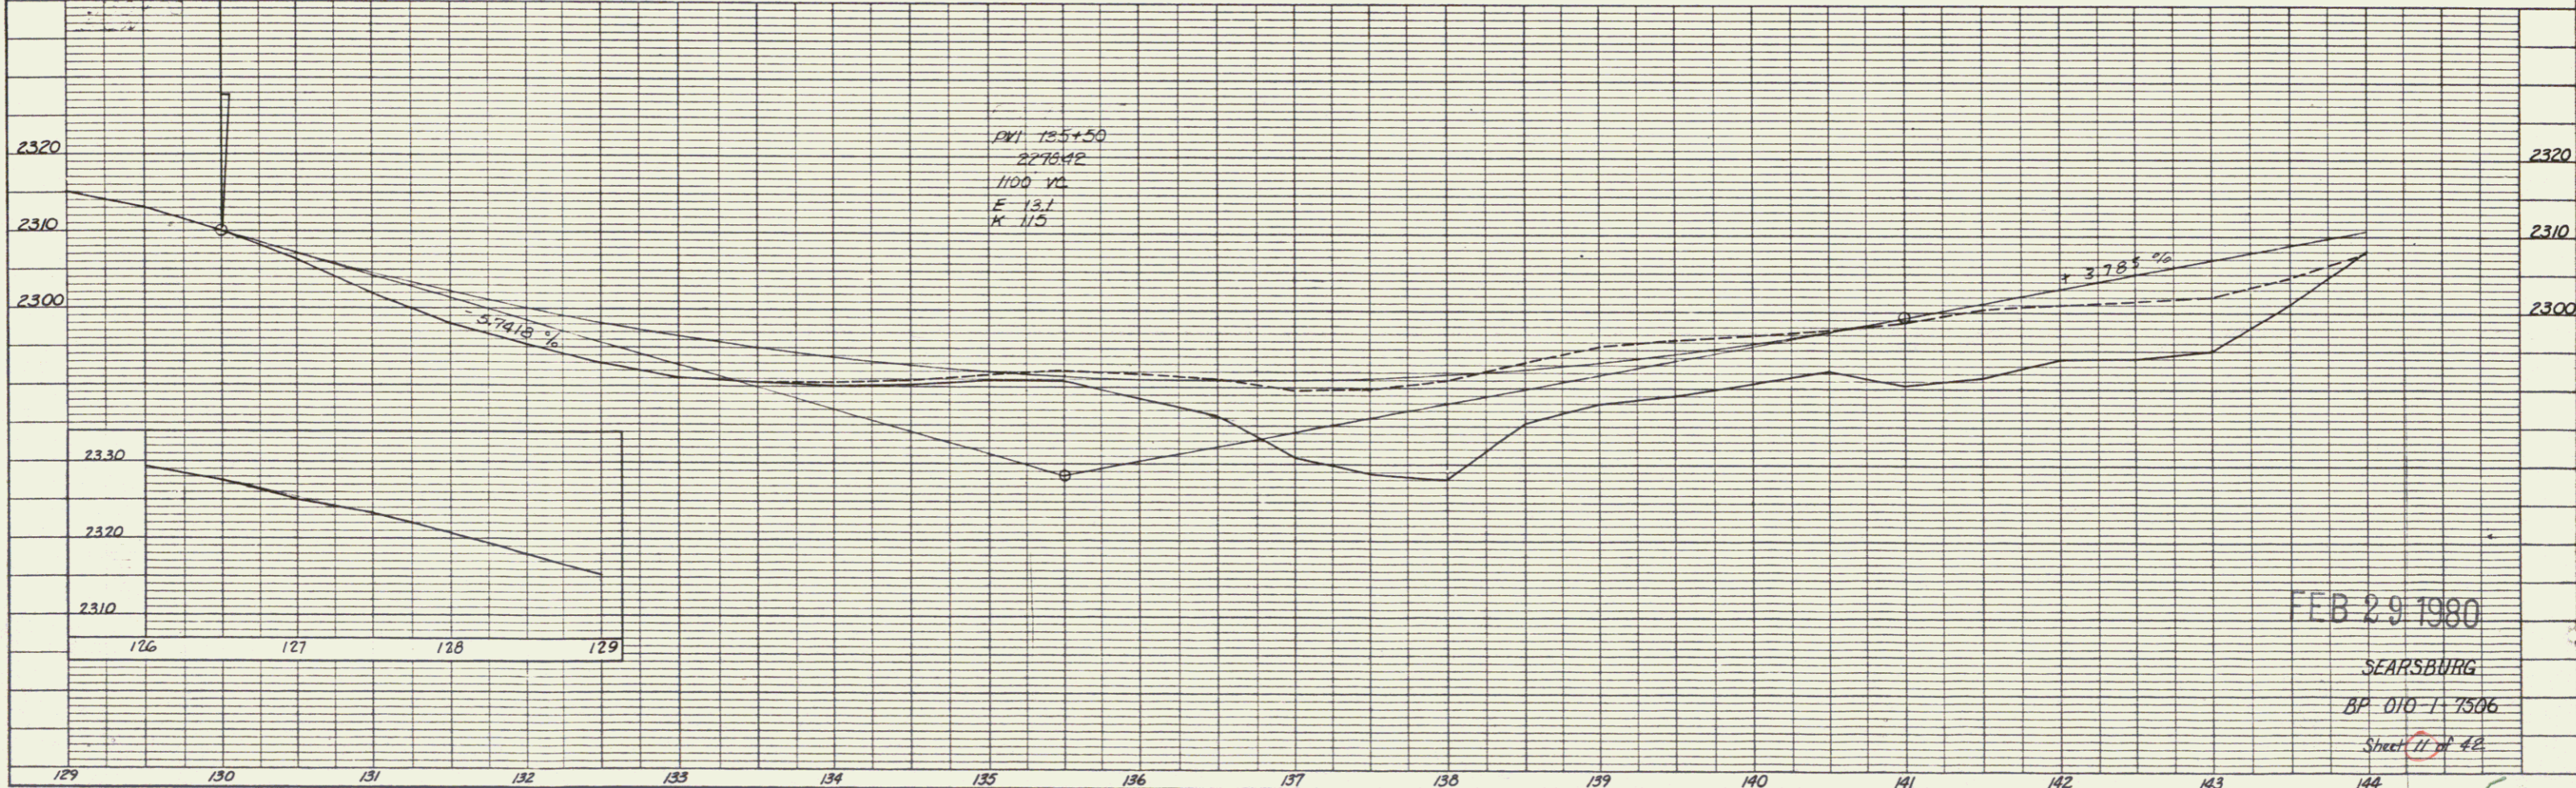


DATE	12/78
BY	G. SUNDGREN
PROJECT	SEARSBURG
DESCRIPTION	ALPHABET CHECKED
NOTE BOOK	PT. OF WAY CHECKED
NO.	

DATE	
BY	
PROJECT	SEARSBURG
DESCRIPTION	ALPHABET CHECKED
NOTE BOOK	PT. OF WAY CHECKED
NO.	

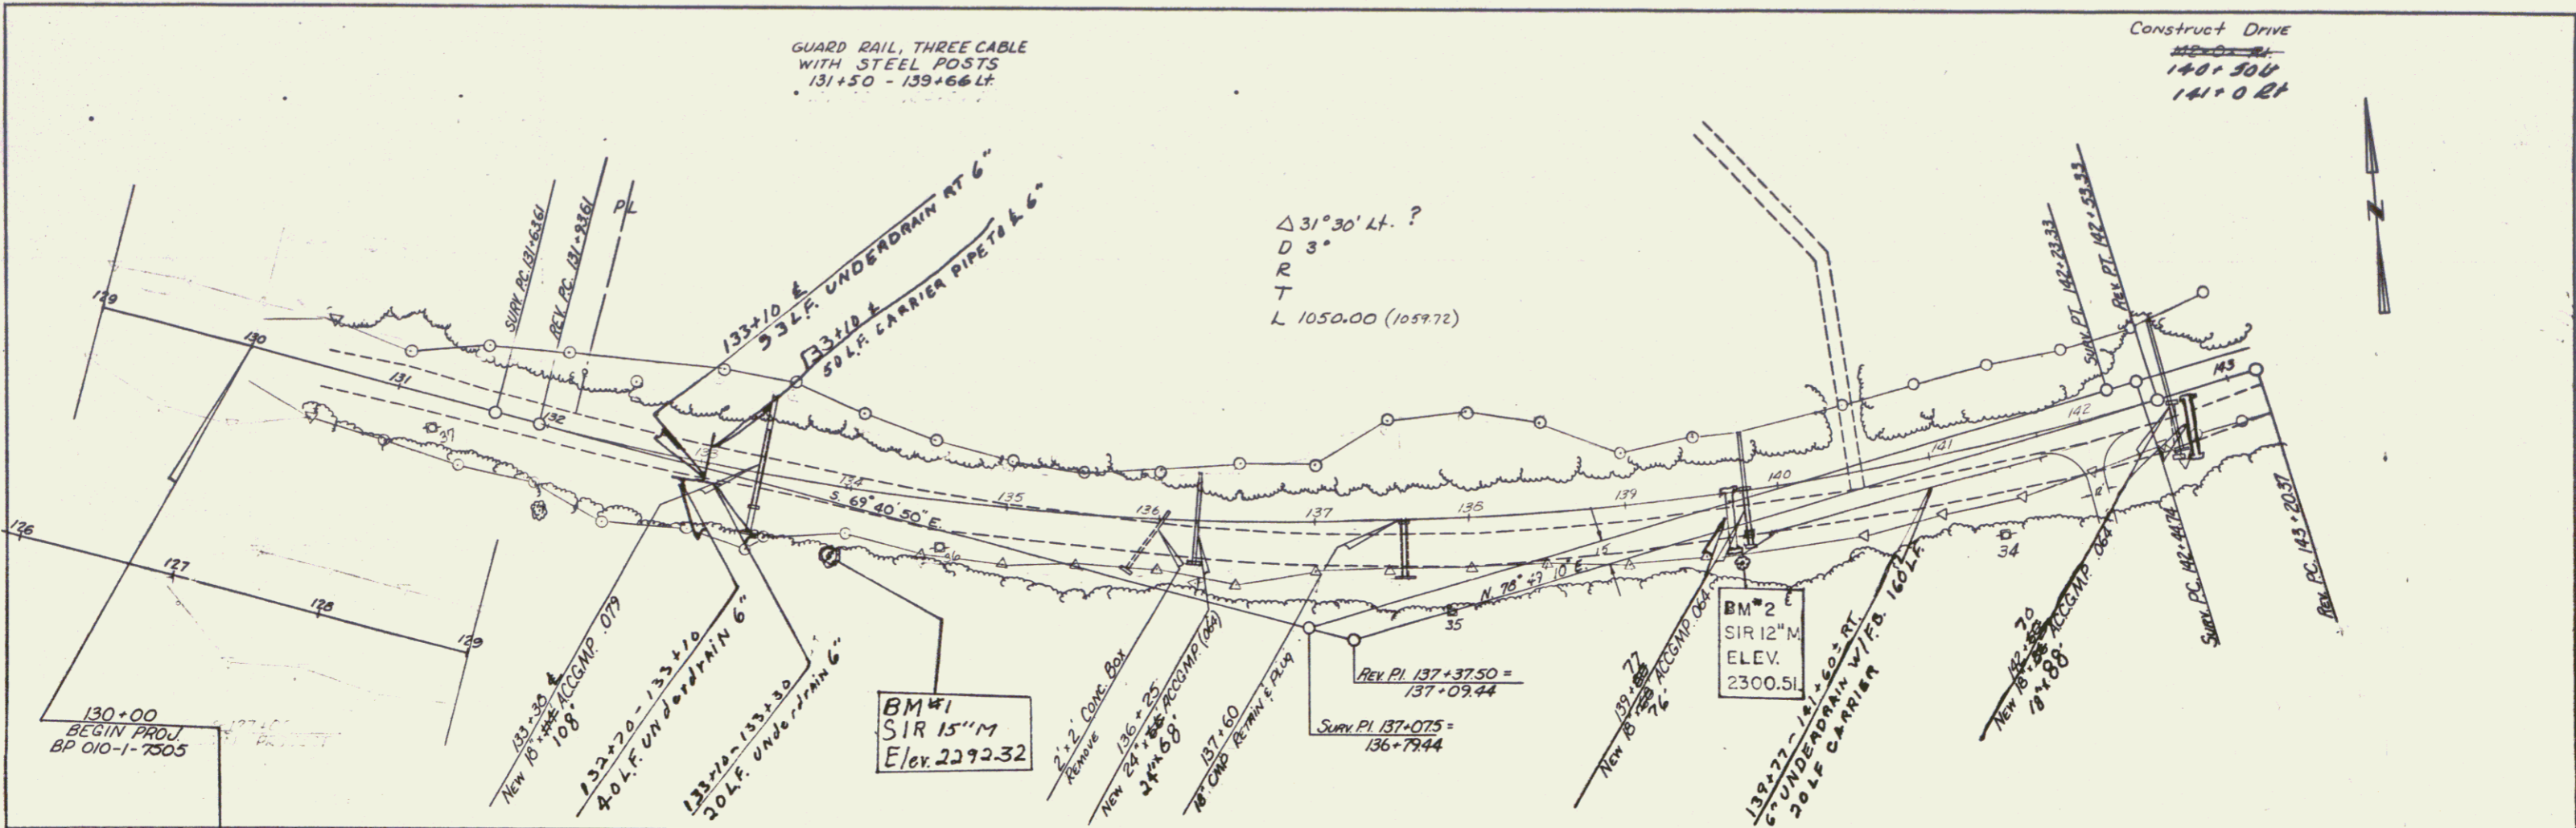

FEB 29 1980  
 SEARSBURG  
 BP 010-1-7506  
 Sheet 11 of 42