
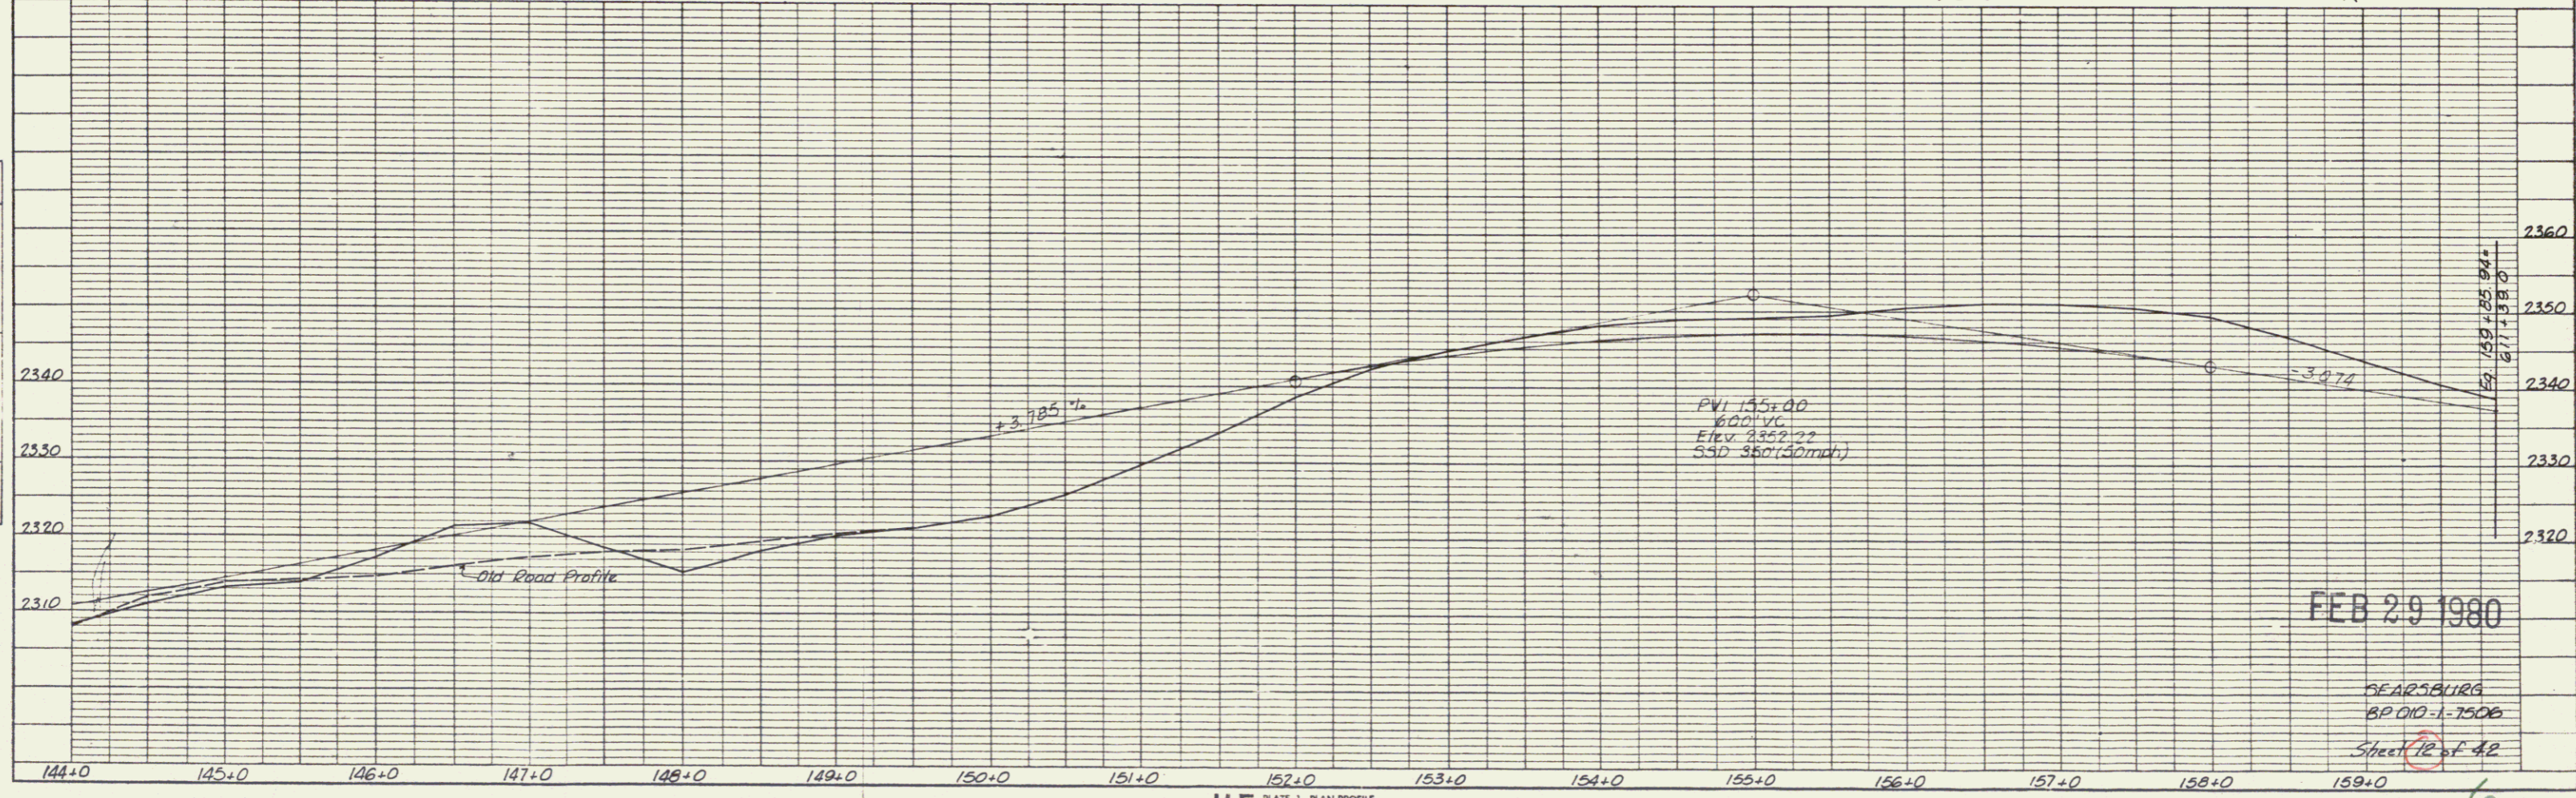


PLAN  
 DRAWN BY: [ ]  
 CHECKED BY: [ ]  
 DATE: [ ]

PROFILE  
 DRAWN BY: [ ]  
 CHECKED BY: [ ]  
 DATE: [ ]

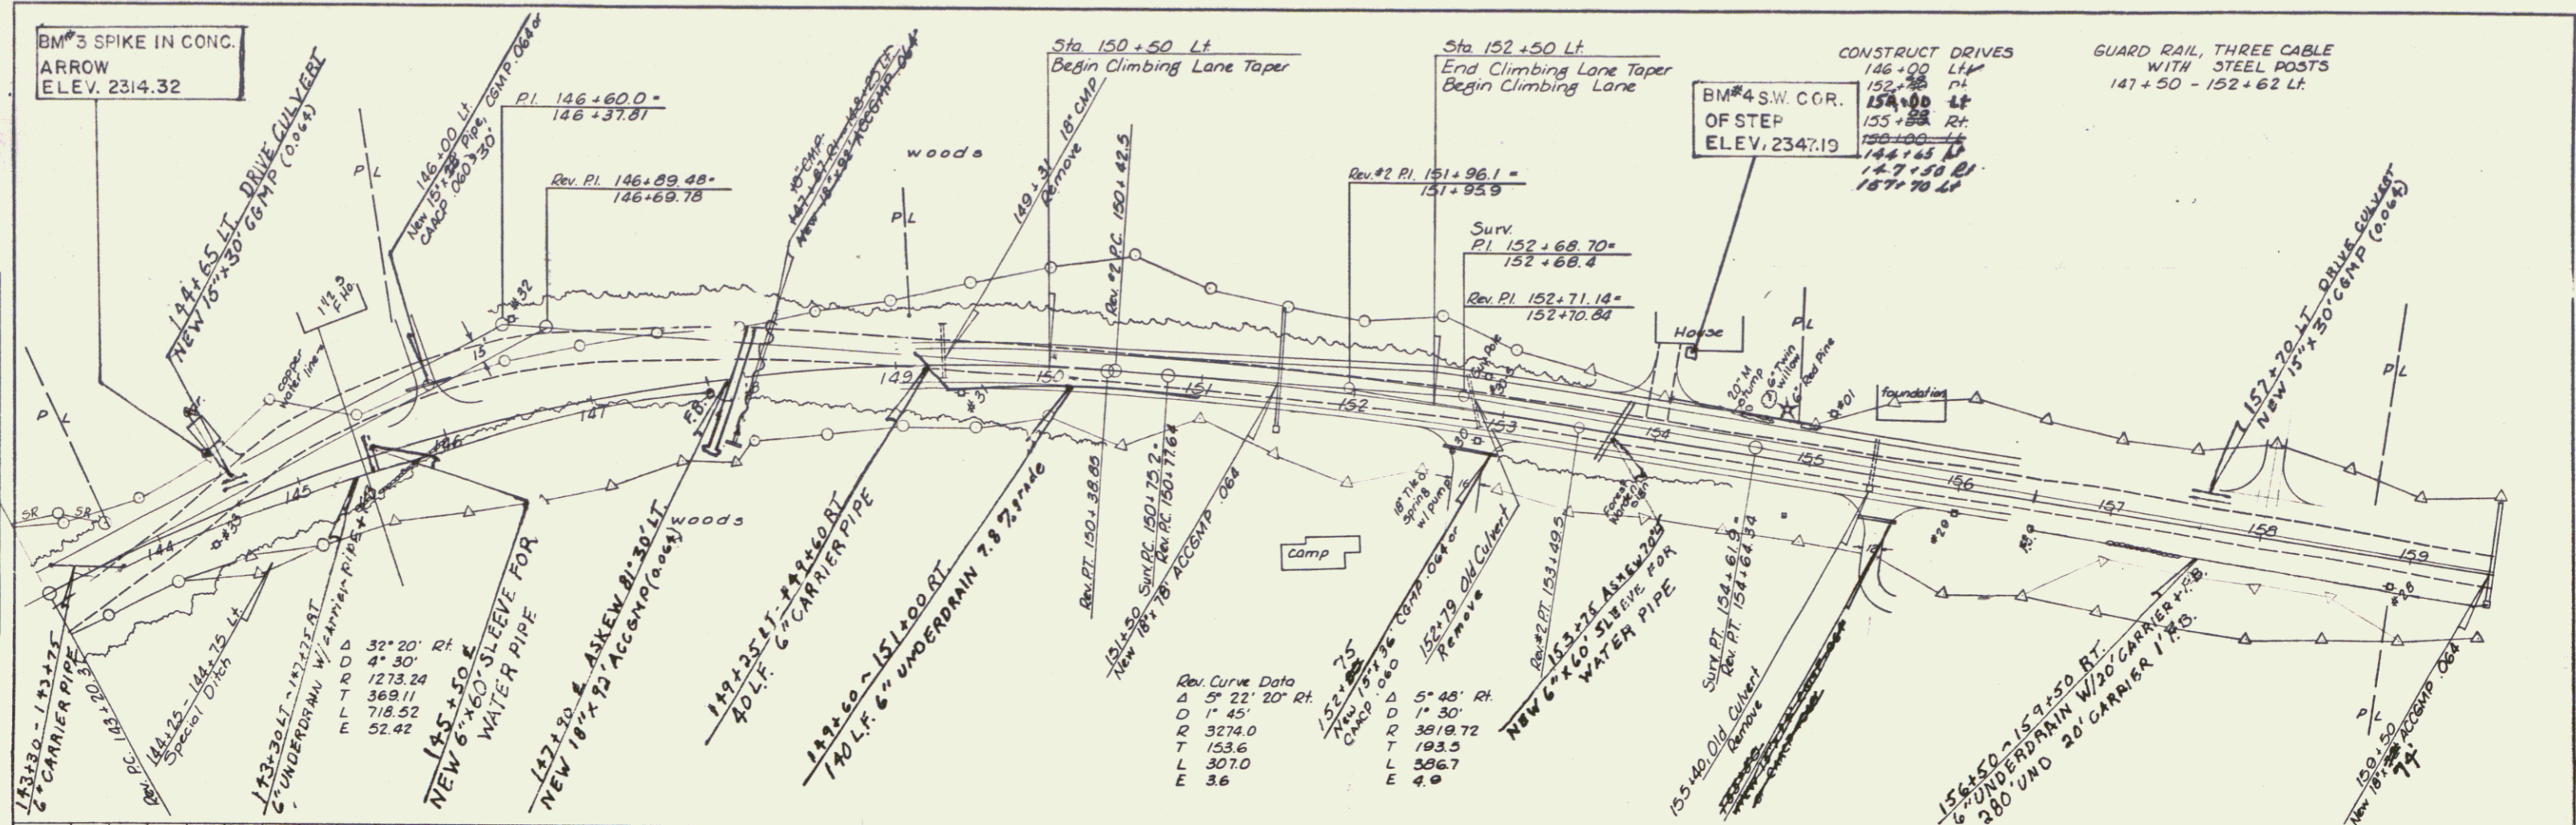

Rev Curve Data

Δ	5° 22' 20" Rt.
D	1' 45"
R	3274.0
T	153.6
L	307.0
E	3.6

FEB 29 1980

GEARSBURG  
 RD 110-1-7506  
 Sheet 12 of 42