


POOR ORIGINAL COPY

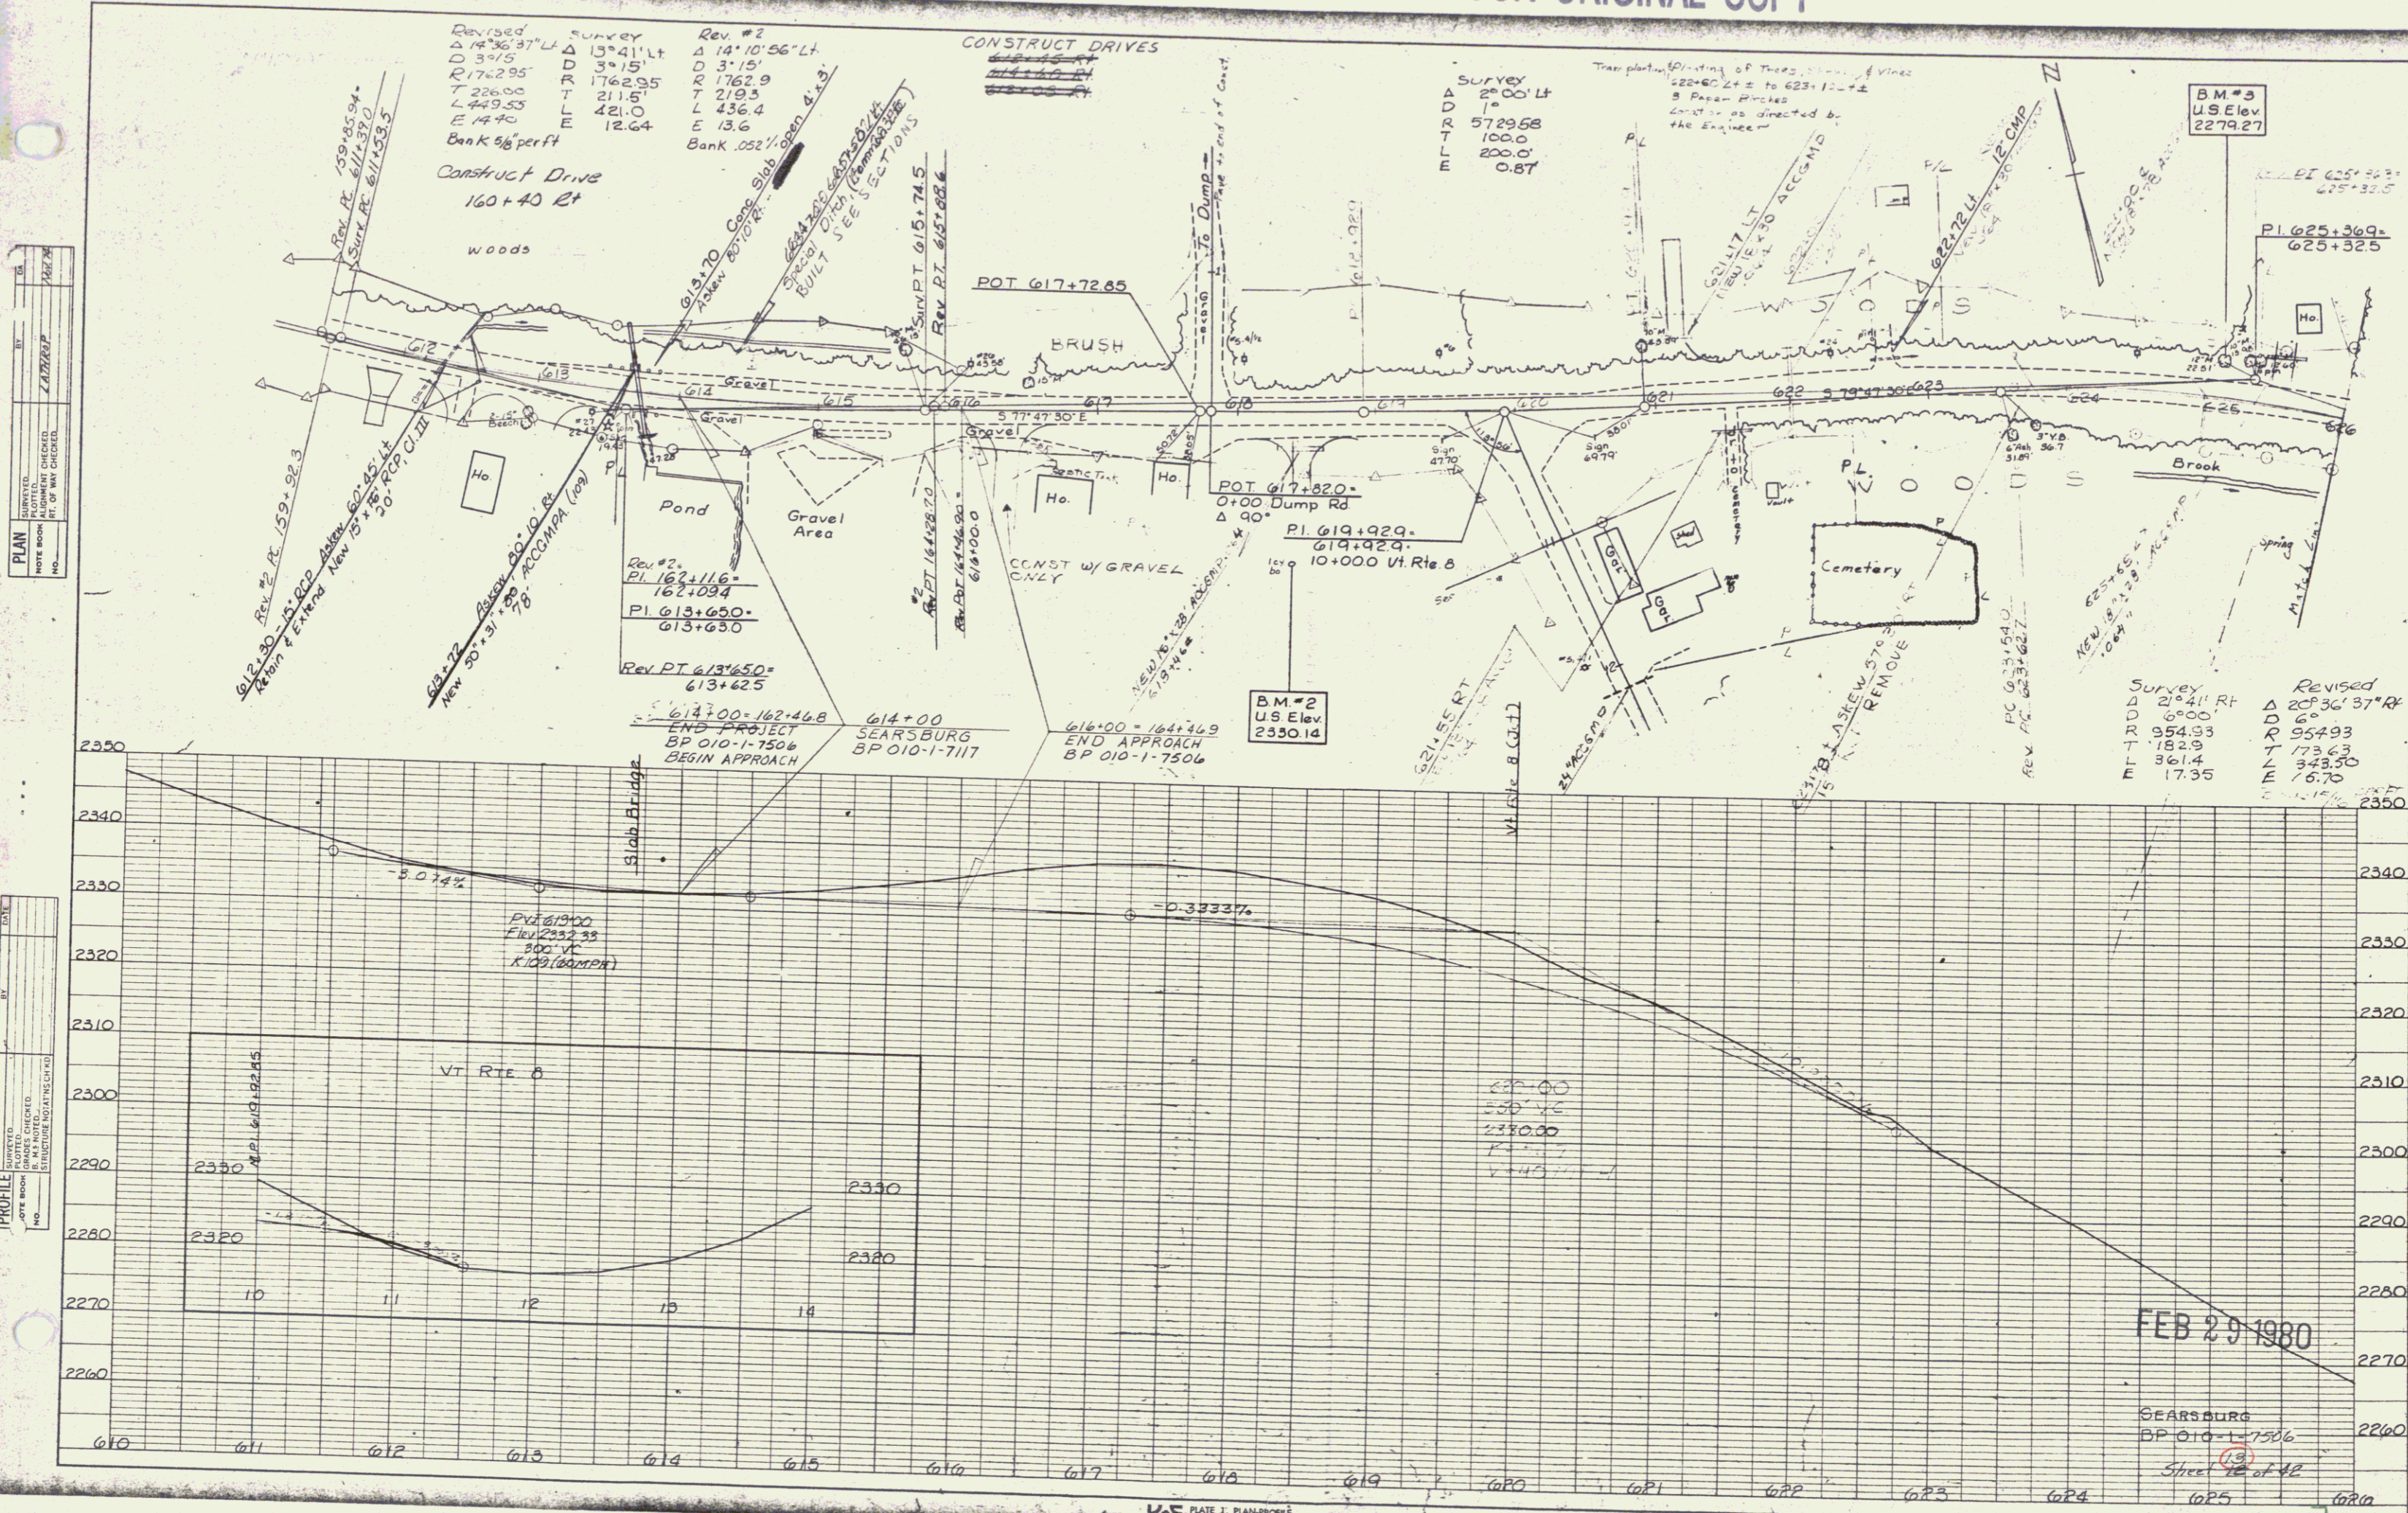

PLAN
 SURVEYED BY: []
 CHECKED BY: []
 DATE: []

PROFILE
 SURVEYED BY: []
 CHECKED BY: []
 DATE: []

FEB 29 1980

SEARSBURG
 BP 010-1-7506
 Sheet 12 of 12

K&E PLATE J, PLAN-PROFILE
 2007 & 2008 CO.

Sheet of Sheets