

DATE: _____
 BY: _____
 CHECKED: _____
 APPROVED: _____

DATE: _____
 BY: _____
 CHECKED: _____
 APPROVED: _____

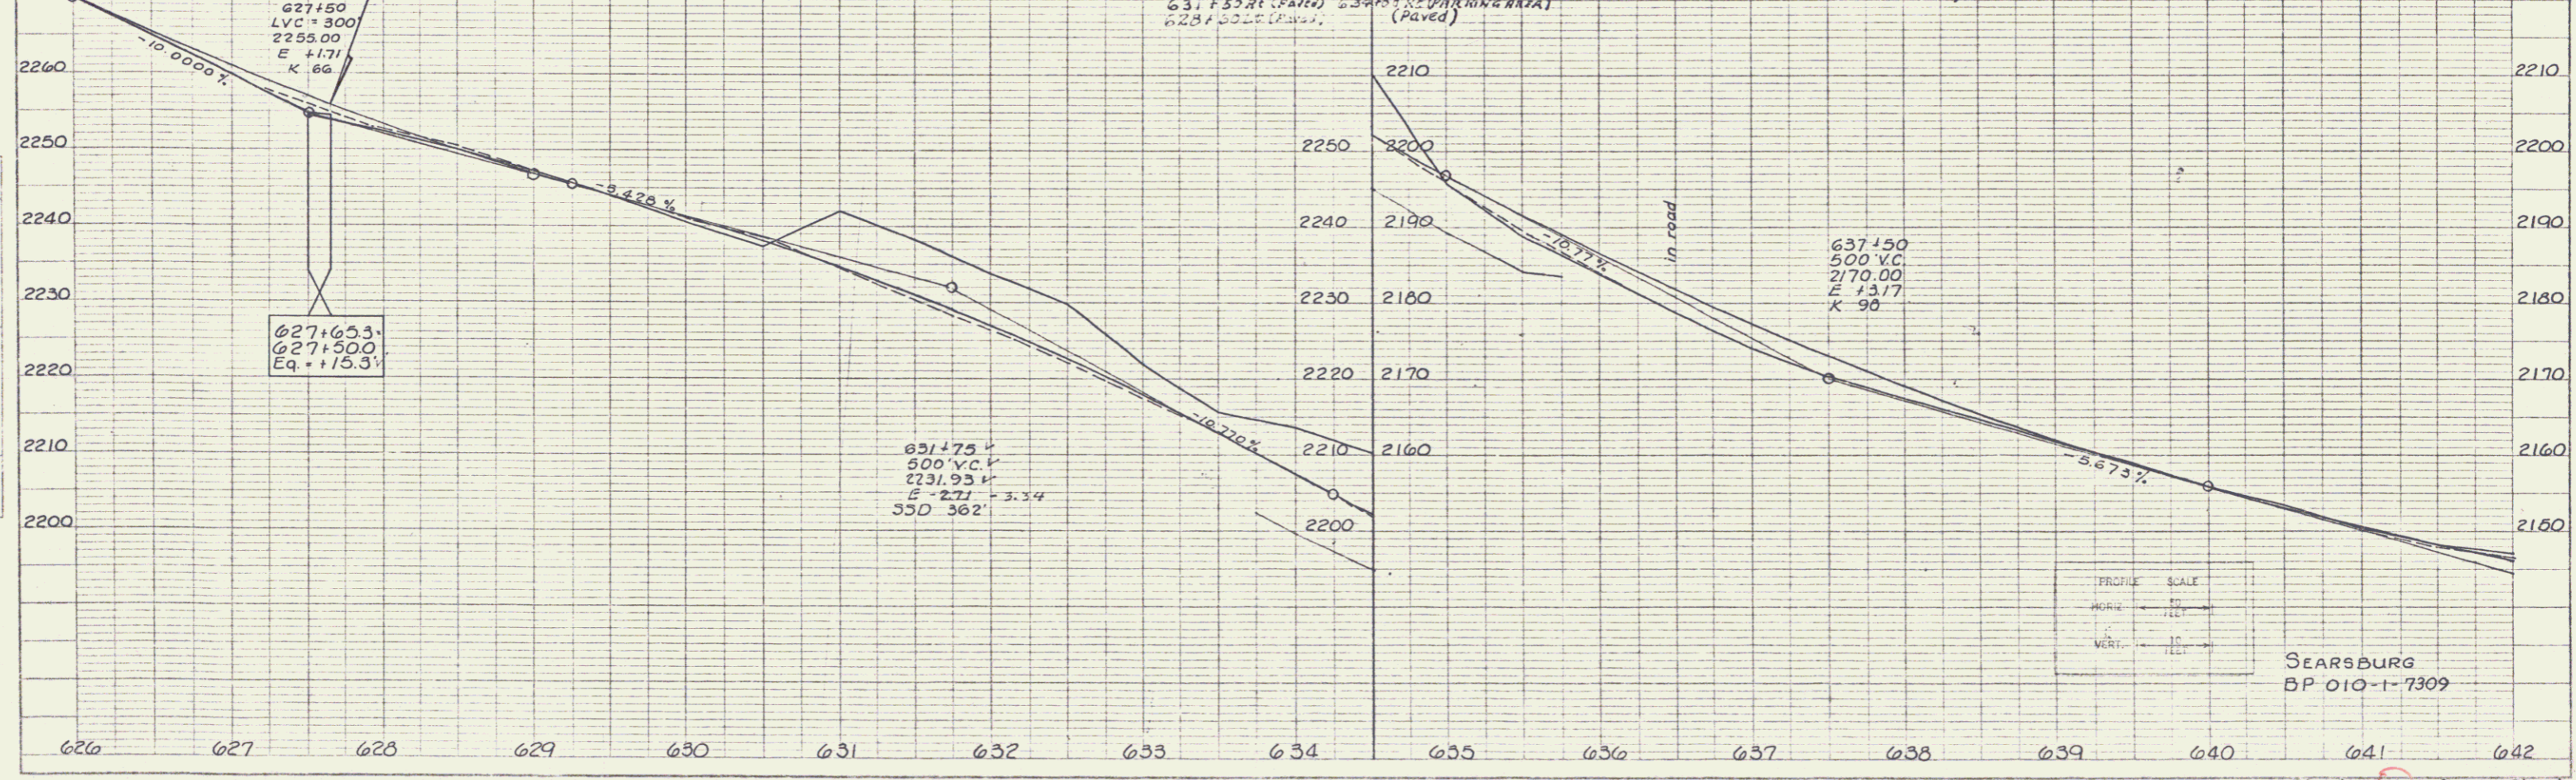
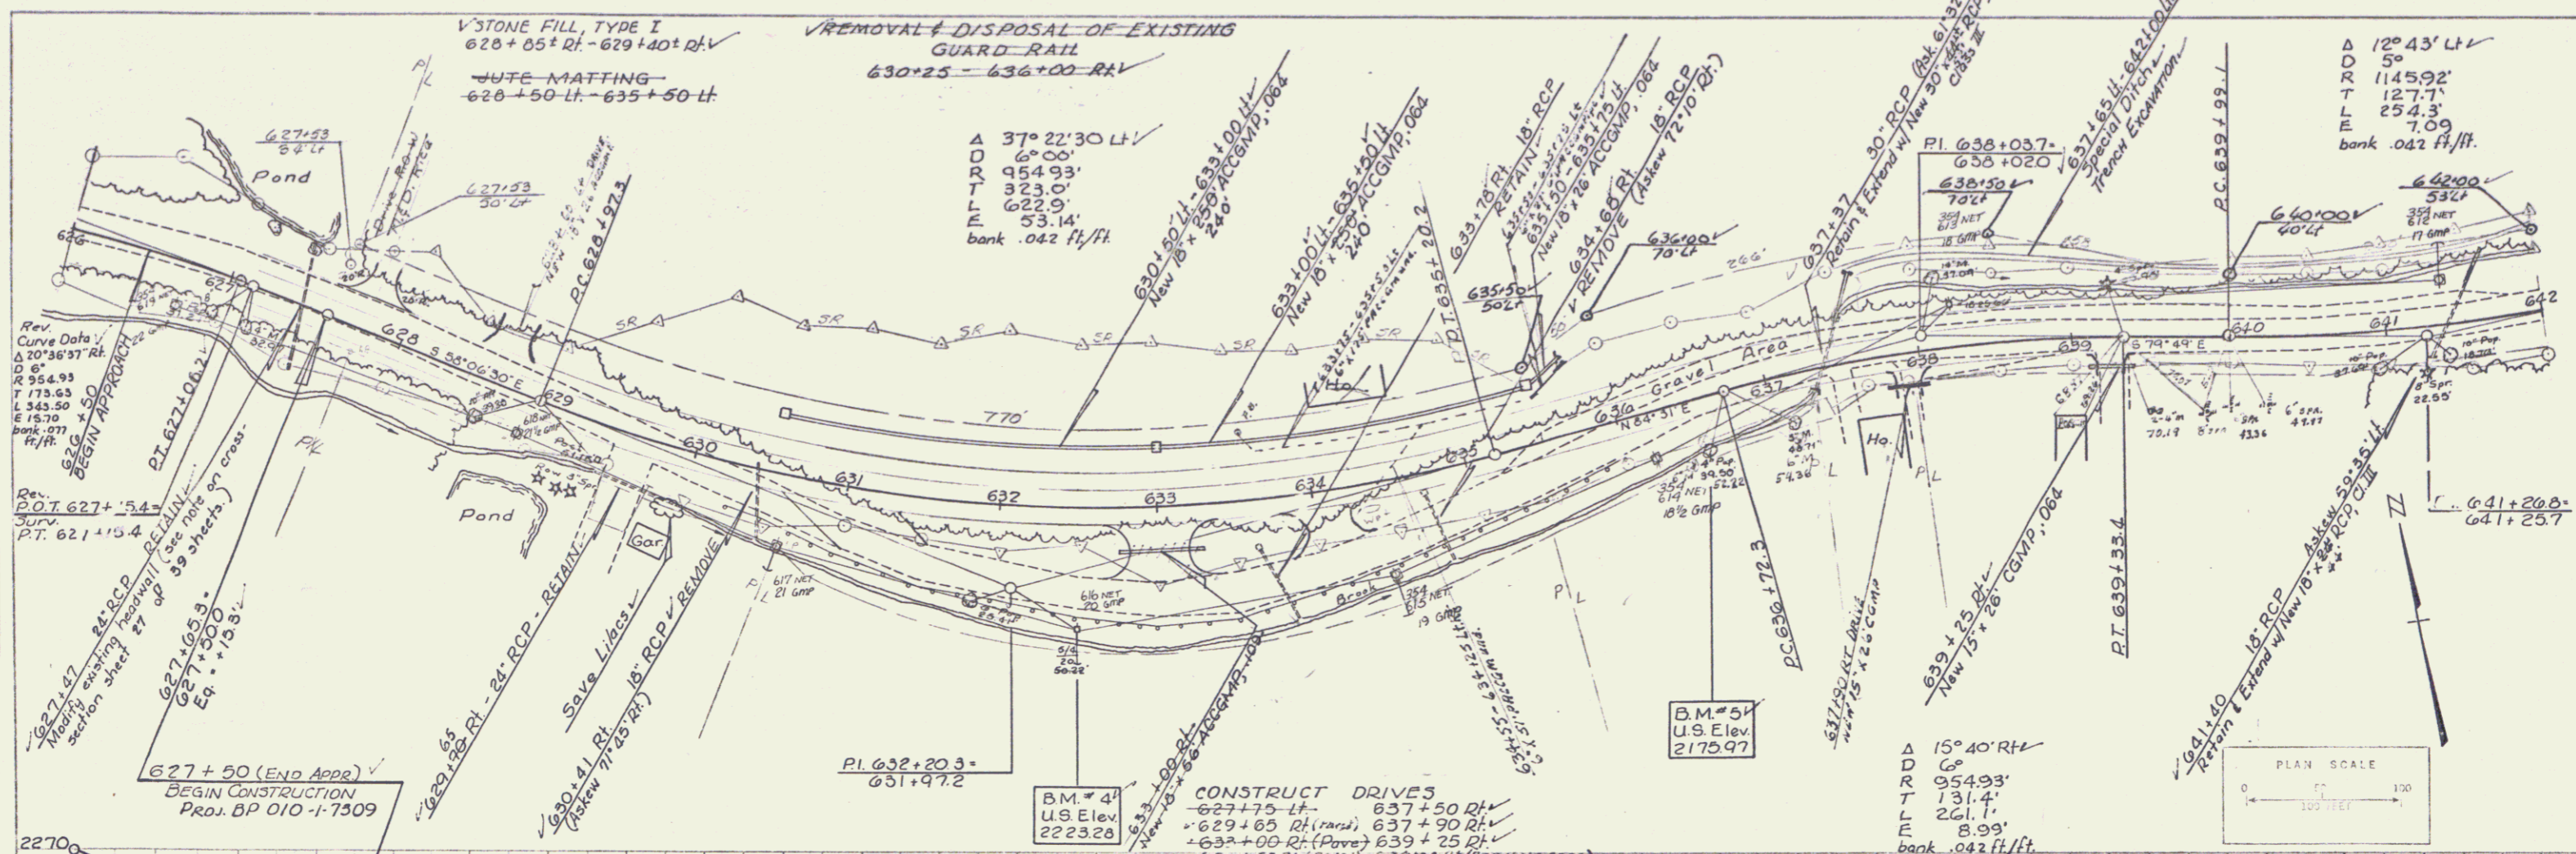


PLATE 1, PLAN/PROFILE
 48 7016 IMPERIAL™ BRASS AND COPPER