


DATE	
BY	
PROJECT	
NO.	
PLANNING	
DESIGN	
CONSTRUCTION	
REVISIONS	

DATE	
BY	
PROJECT	
NO.	
PLANNING	
DESIGN	
CONSTRUCTION	
REVISIONS	

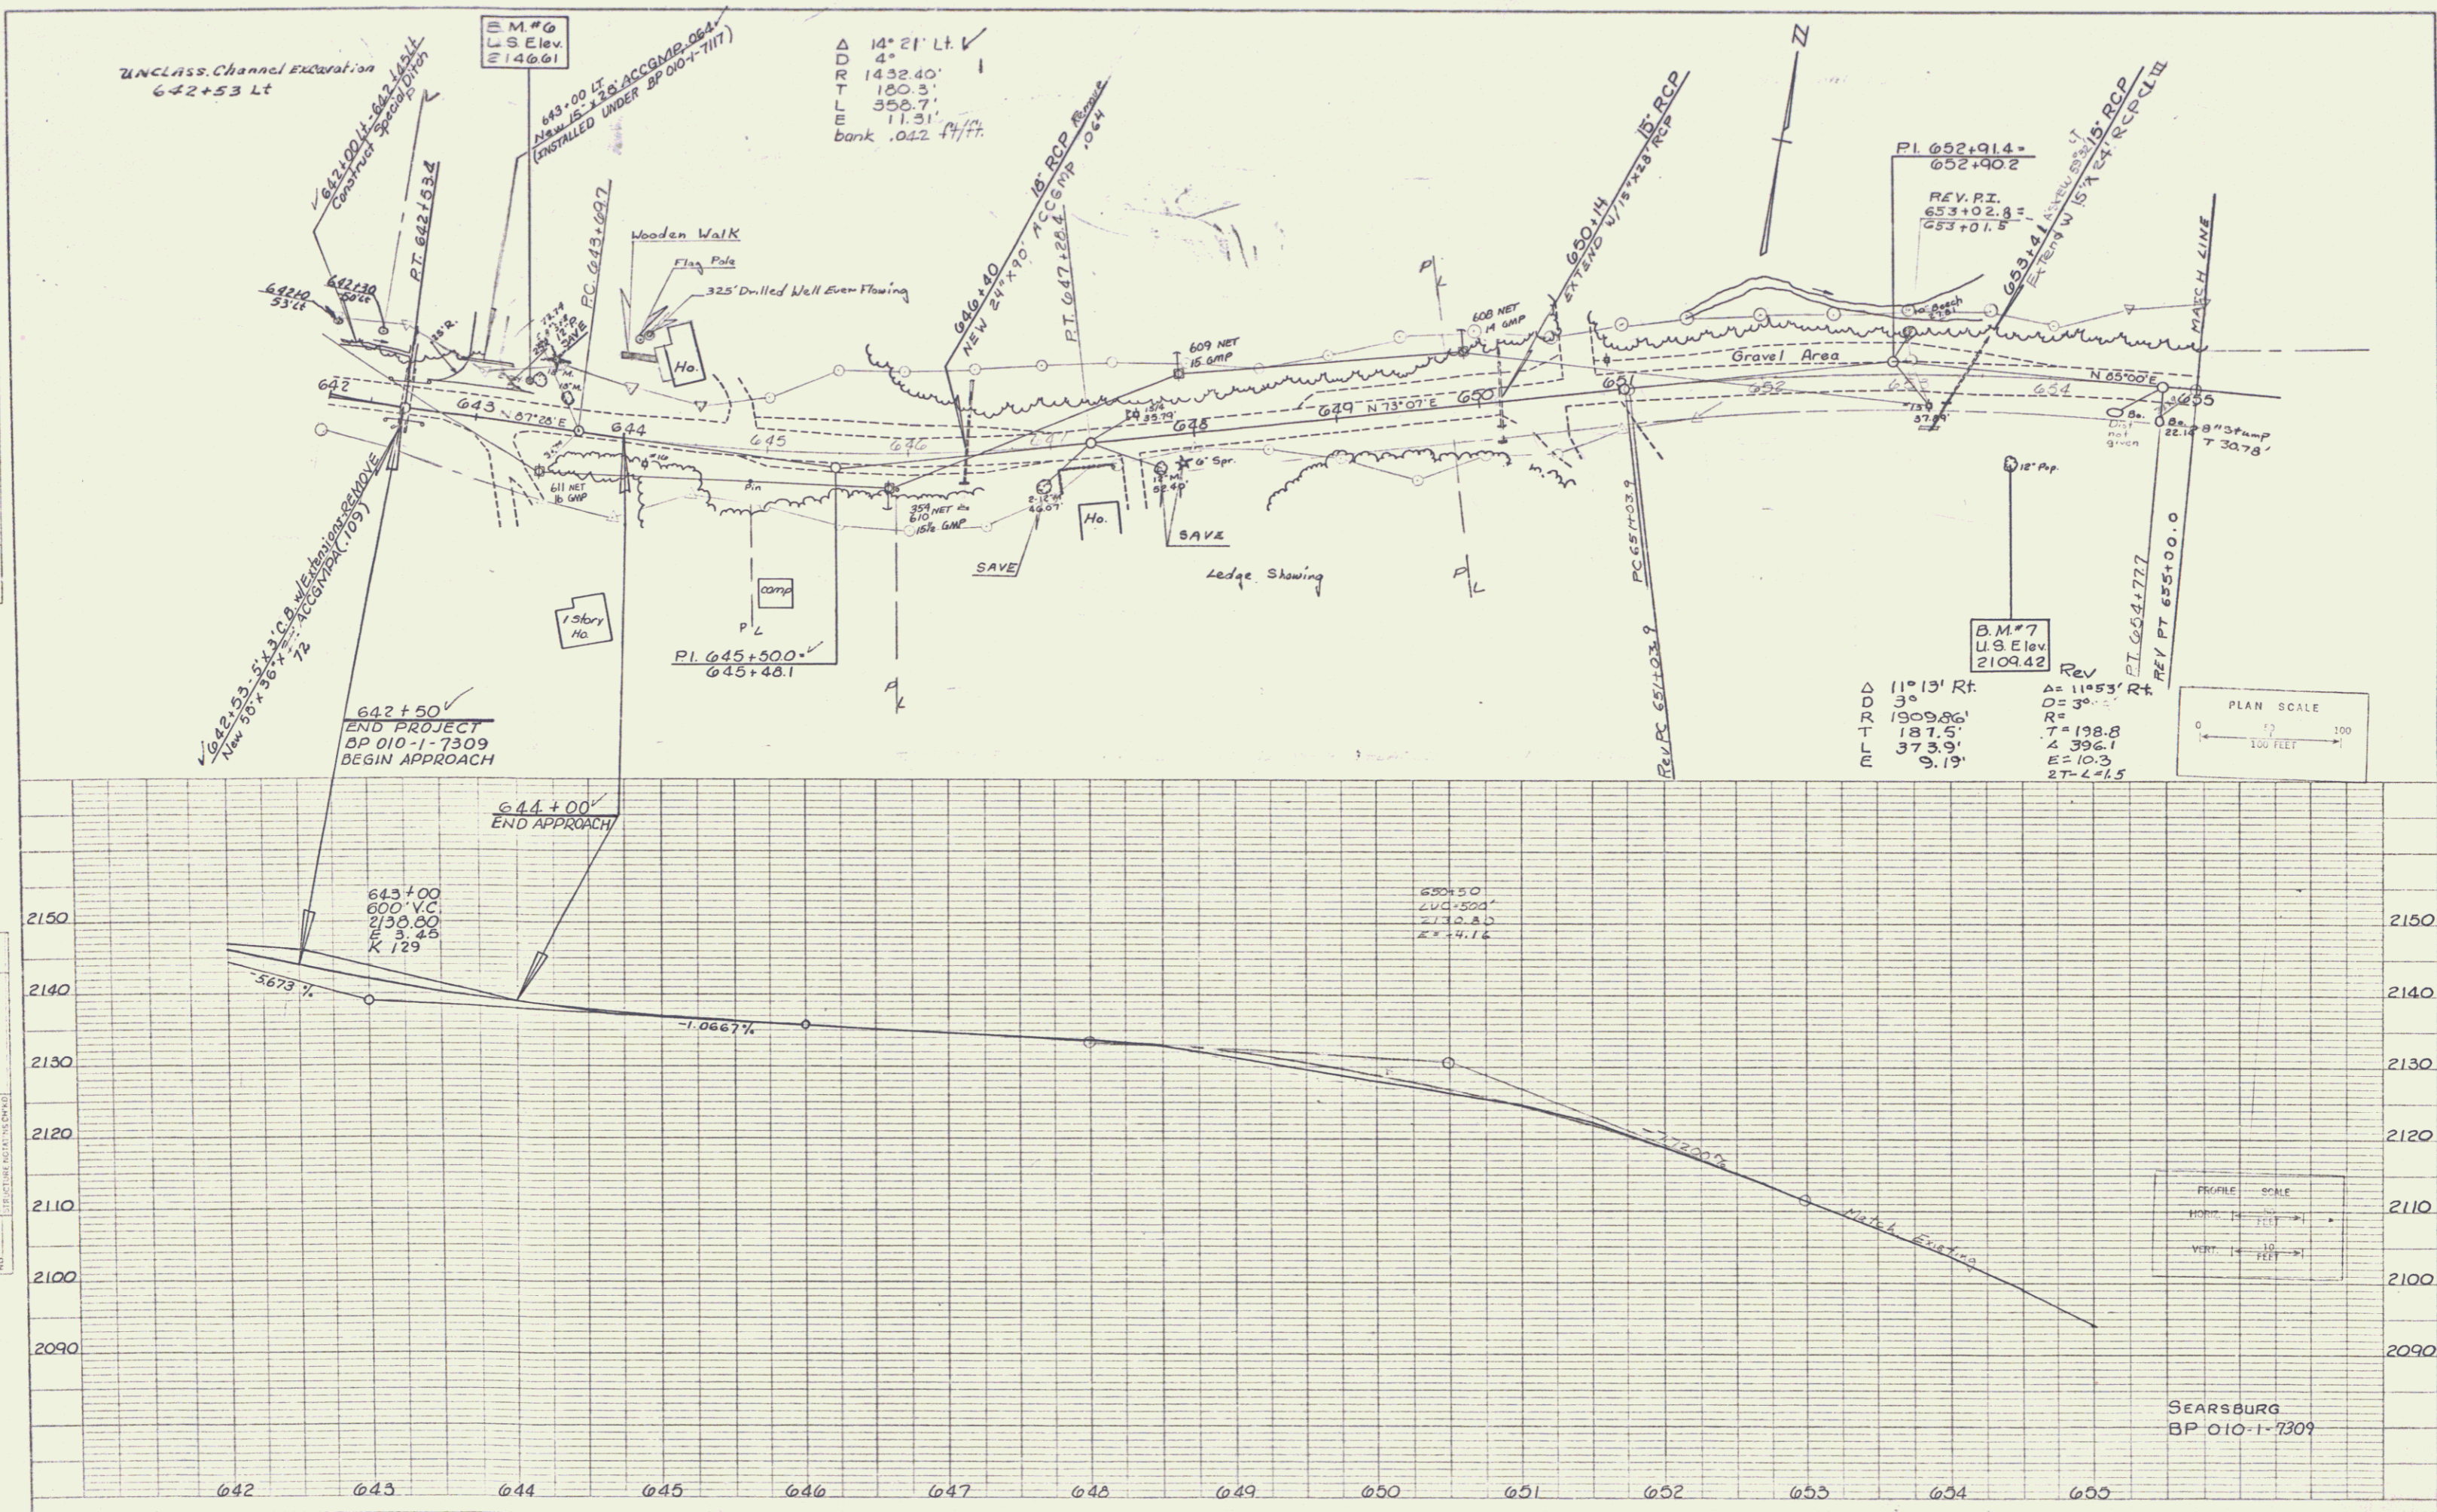

Δ 14° 21' Lt ✓  
4°  
1432.40'  
180.3'  
358.7'  
11.31'  
bank .042 ft/ft.

Rev  
Δ 11° 13' Rt.  
D 3°  
R 1909.86'  
T 187.5'  
L 373.9'  
E 9.19'

Δ 11° 53' Rt.  
D 3°  
R =  
T = 198.8'  
L = 396.1'  
E = 10.3'  
27-4-15