
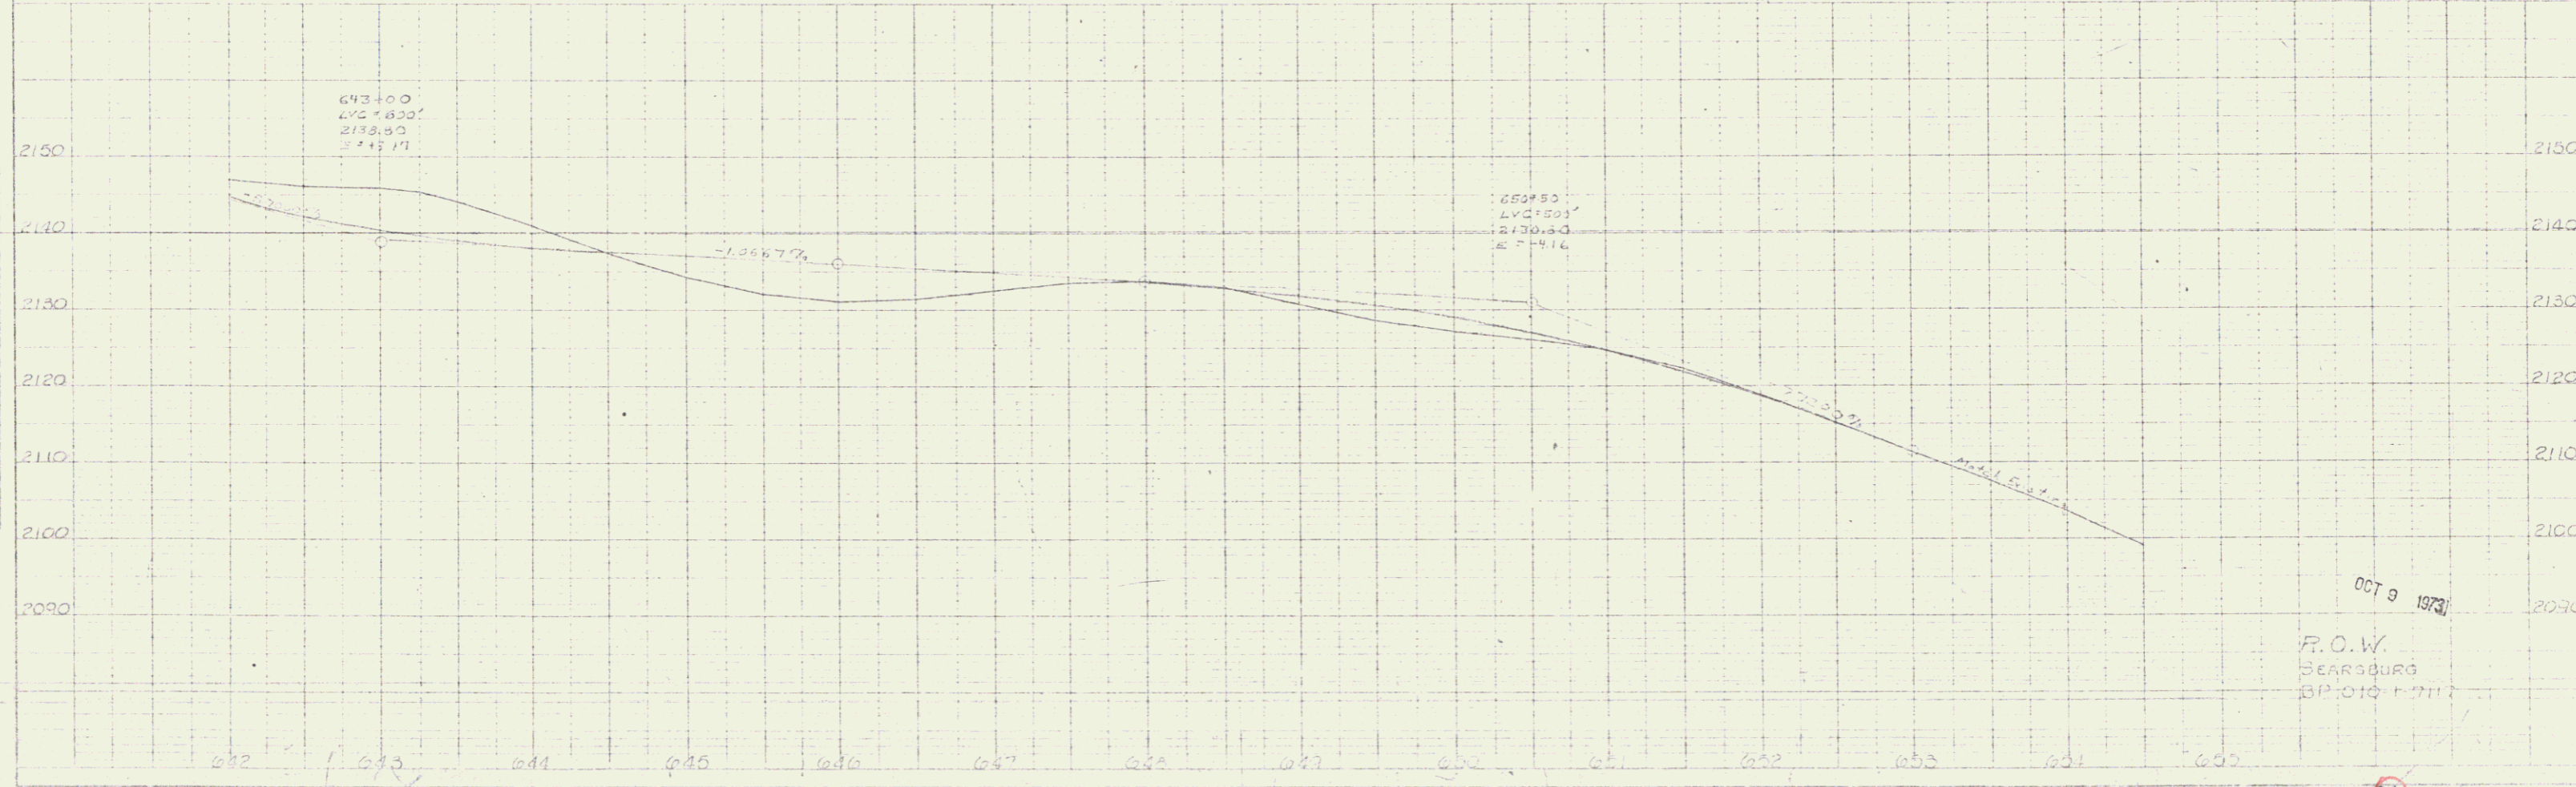


POOR ORIGINAL COPY

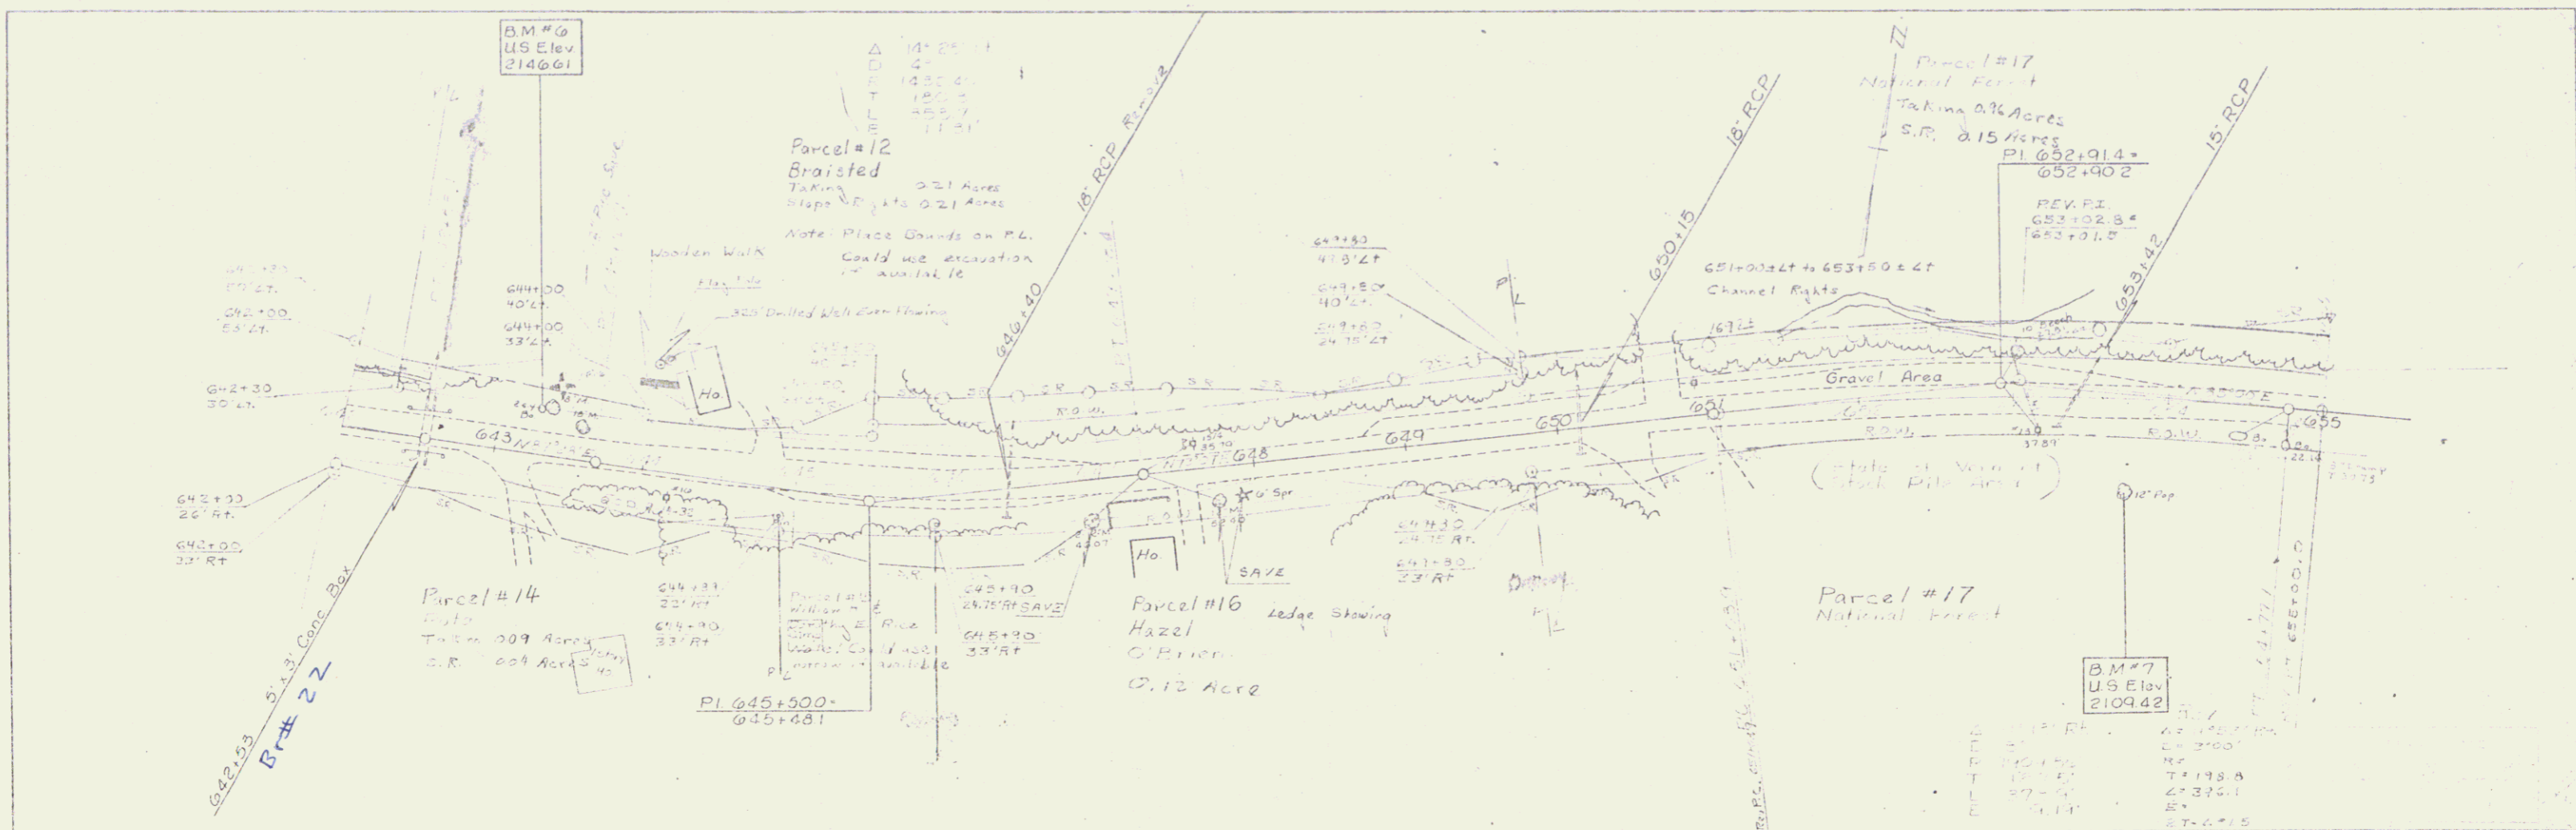

OCT 9 1973
R.O.W.
BEARSBURG
SP. 010 E 211

Sheet 5A