


STEEL BEAM GUARD RAIL
 STA 688+20 - 692+00 LT.
 STA 693+20 - 694+50 LT.

REMOVAL & RESETTING
 GUARD RAIL
 STA 692+00 - 701+00 LT.
 STA 693+20 - 693+20 LT (ST. BEAM)
 STA 694+20 - 694+20 LT (ST. BEAM)
 STA 696+20 - 702+00 LT (CRUISE)

CONSTRUCT DRIVES
 STA 694+00 - 695+00 LT.
 STA 697+00 - 700+00 LT.
 STA 693+00 LT.
 STA 688+50 RT.

USE FOR DISPOSAL OF EXCESS EXCAVATION
 STA. 692+00 - 701+00

100-11 1932 10 50

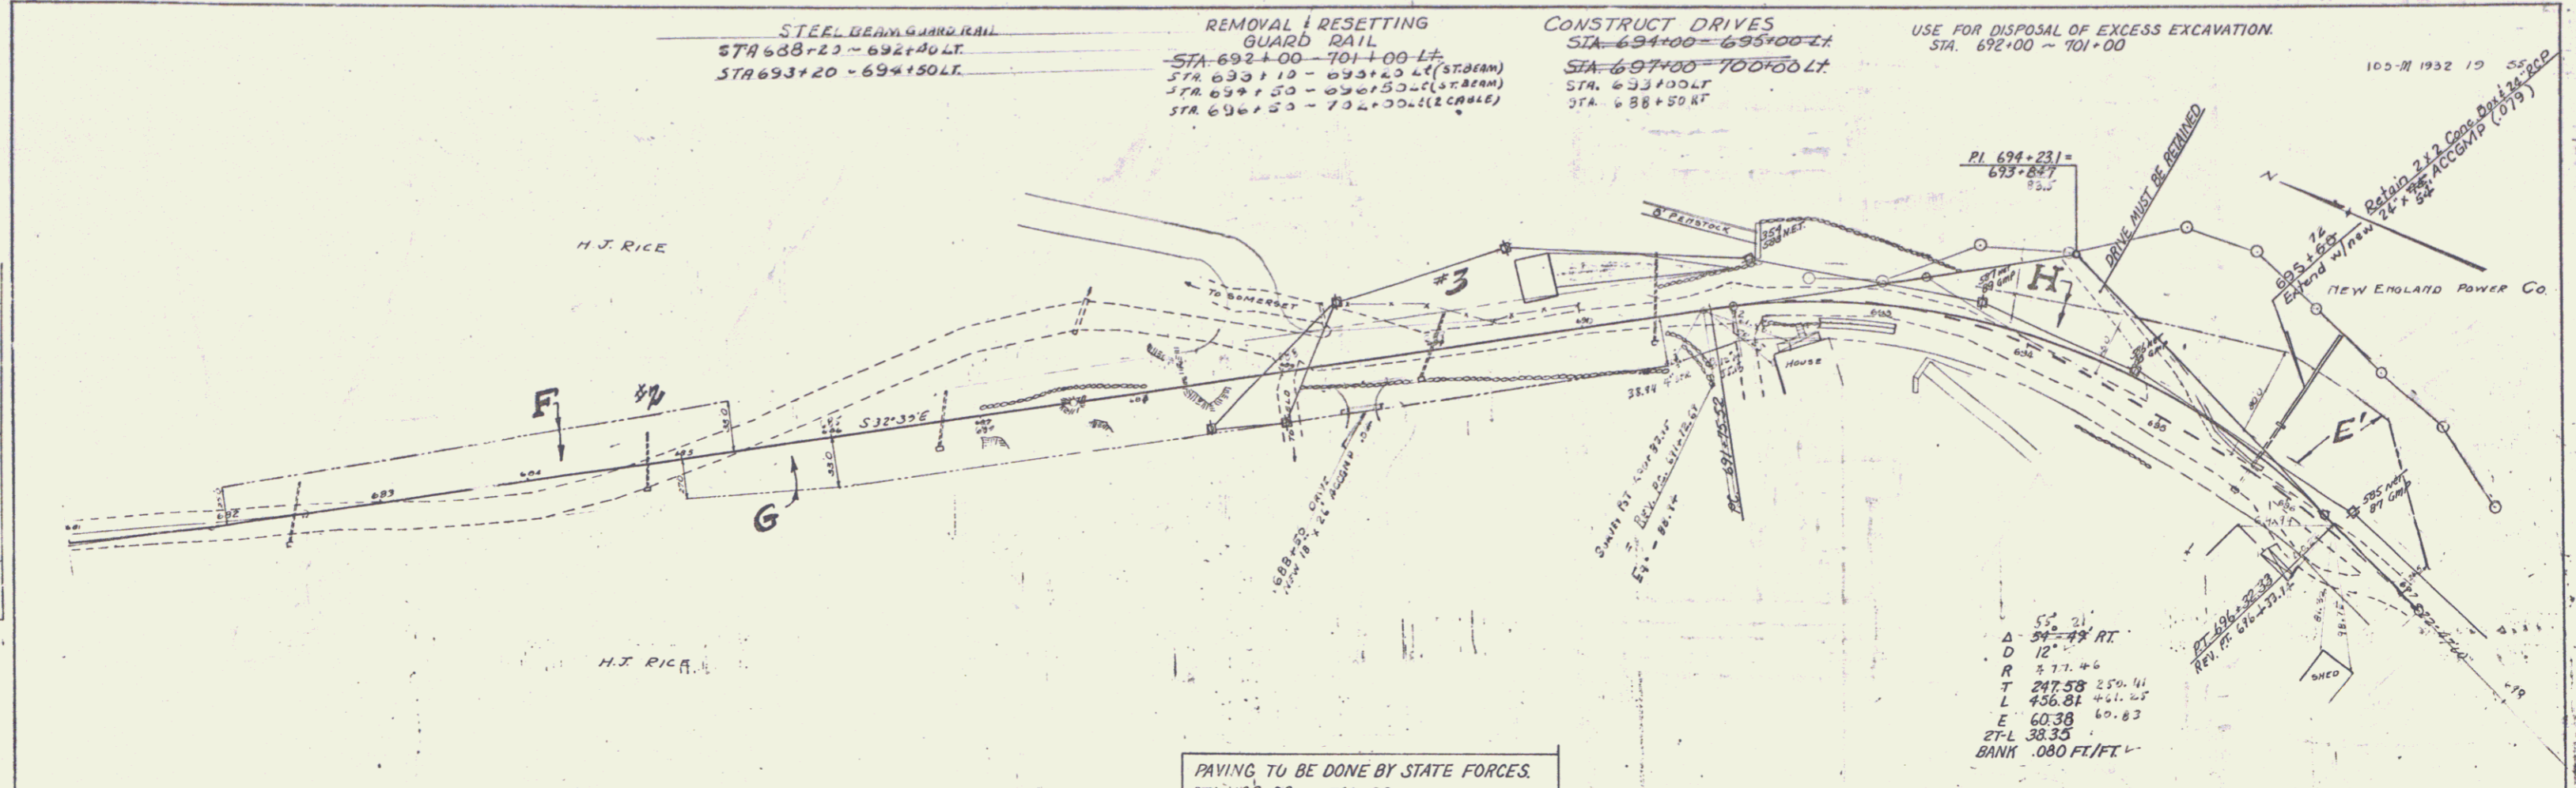

52 21
 Δ 54-48 RT
 D 12
 R 771.46
 T 247.58 250.41
 L 456.81 461.65
 E 60.38 60.83
 2T-L 38.35
 BANK .080 FT/FT

PAVING TO BE DONE BY STATE FORCES.
 STA 692+00 - 701+00

PRICE	TYPE OF INSTRUMENT	DATE OF INSTRUMENT	GENITOR	GENITEE	RECORDED	REMARKS
ABO	ENG. O.C.D.	10-29-32	H. J. J. RICE	1100 FT. 0	233	11-21-32 G.P. 70 69400
E	O.C.D.	11-10-33	New England Power Co.	1	222, 282	11-30-33

PLAN
 DRAWN BY
 CHECKED BY
 NOTE BOOK NO.
 DATE

PROFILE
 DRAWN BY
 CHECKED BY
 NOTE BOOK NO.
 DATE

DN 97 Spike in roof 12" Poplar 14' 11.50 603162 Elev 1006.06
 DN 98 Spike in trunk 24" Maple 23' 11 11.62 603195 Elev 1740.26

SEASBURY
 SHEET 9 OF 39
 8P010-1-7309