
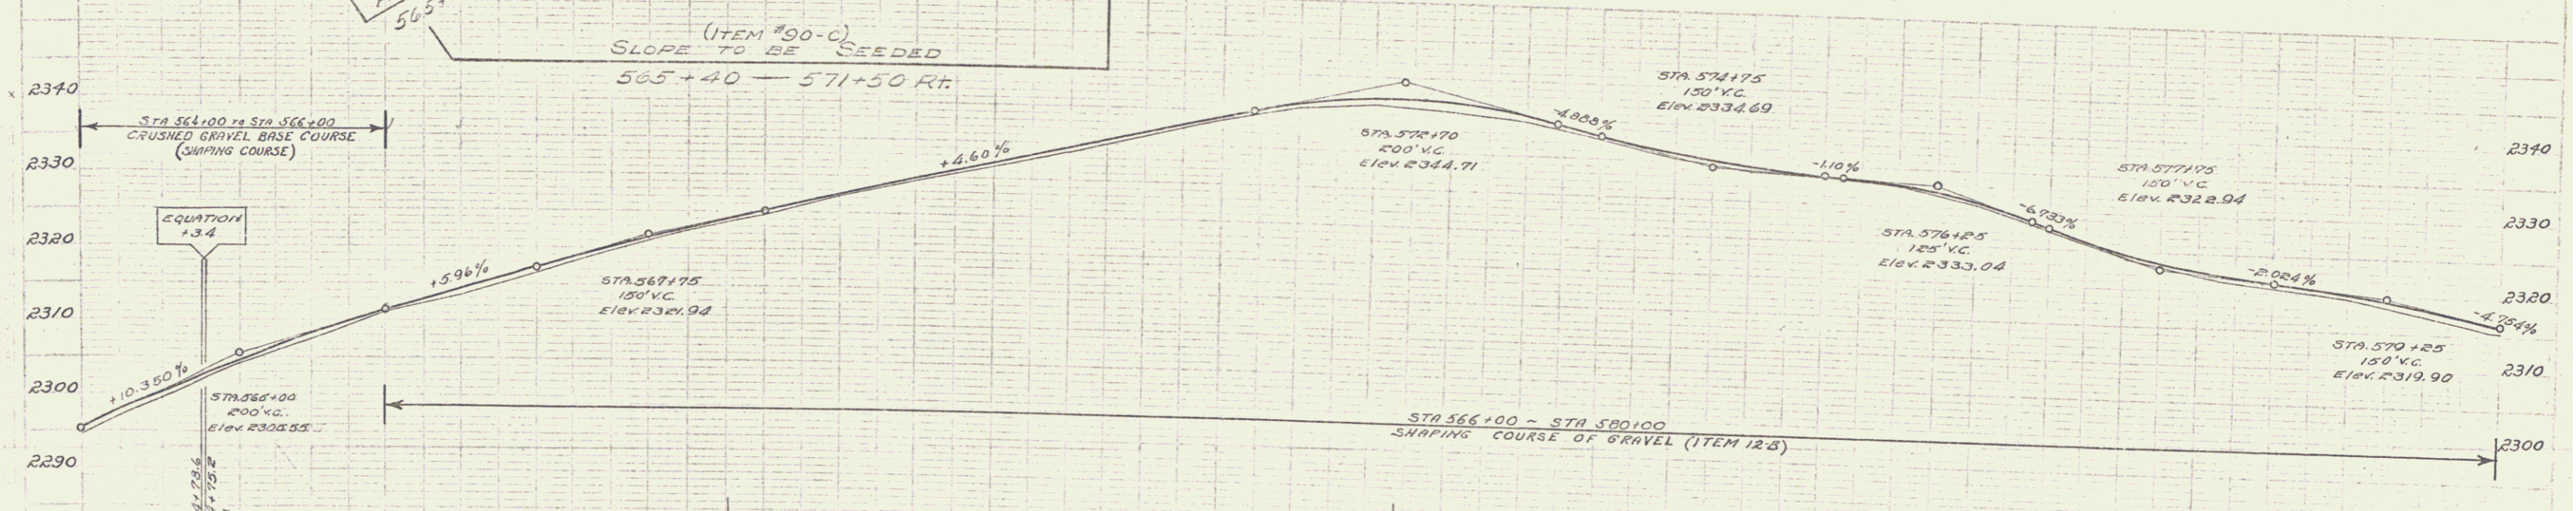


WOOD GUARD RAIL		GUIDE POSTS OF WOOD		CABLE GUARD RAIL	
STATION	LEFT RIGHT	STATION	LEFT RIGHT	STATION	LEN. CABLE PLYLINE
568+27	24'	564+03	~	570+00	48' 40" 88'
575+40	24'	568+27	~		
579+93	24' 24'	575+40	~		
		578+14	~		

STATE ROAD DIST. NO. 105 M 1932 II 33

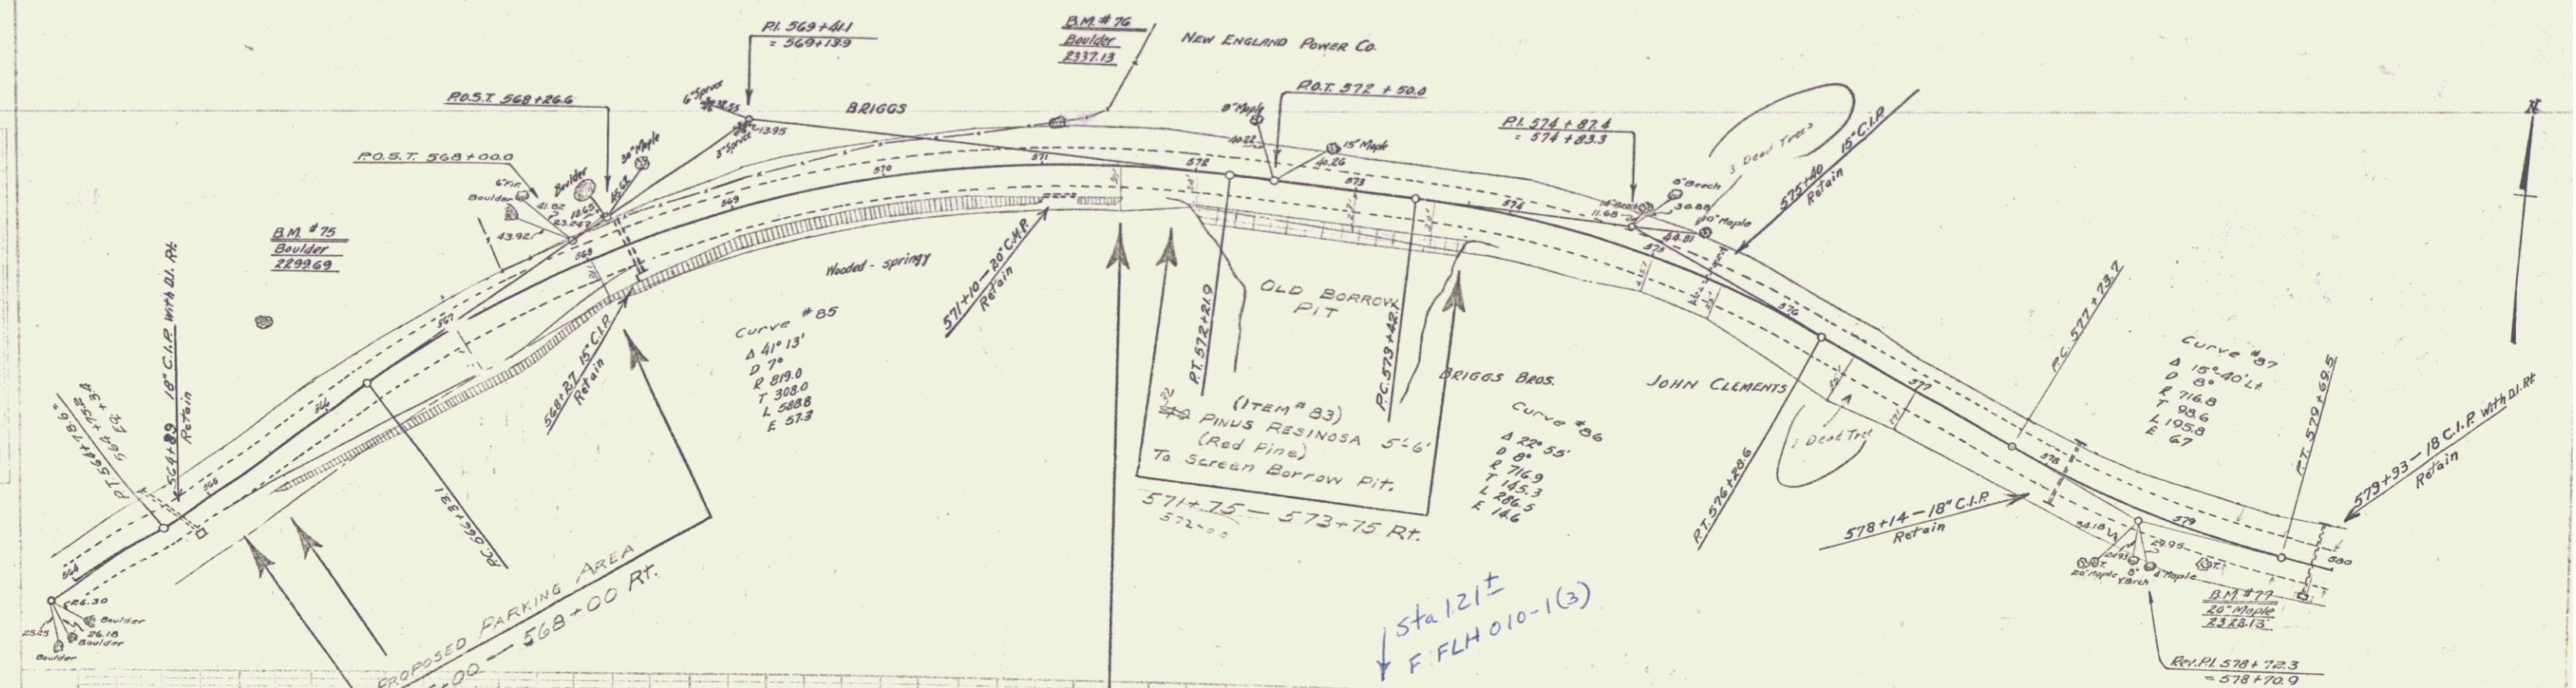

STATION	ELEVATION
564	2296.2
564	2296.6
564	2300.10
564	2301.0
564	2301.6
564	2302.85
565	2304.45
565	2305.1
565	2305.85
566	2311.2
566	2311.51
566	2312.4
566	2314.40
567	2316.6
567	2317.47
567	2318.7
567	2321.83
567	2321.68
567	2322.3
567	2322.97
567	2324.1
567	2325.59
568	2327.1
568	2327.6
568	2328.3
568	2328.8
568	2329.3
568	2329.9
569	2331.6
569	2332.59
570	2334.2
570	2335.60
571	2337.9
571	2338.59
572	2341.8
572	2342.7
573	2346.8
573	2347.6
573	2348.0
574	2352.6
574	2352.3
574	2353.60
575	2354.0
575	2354.50
576	2357.9
576	2358.6
576	2359.0
577	2361.7
577	2362.0
577	2362.8
578	2364.8
578	2365.0
578	2365.8
579	2367.7
579	2368.0
579	2368.4
580	2371.3
580	2371.6
580	2372.3
580	2372.6
580	2373.3
580	2373.6
580	2374.3
580	2374.6
580	2375.3
580	2375.6
580	2376.3
580	2376.6
580	2377.3
580	2377.6
580	2378.3
580	2378.6
580	2379.3
580	2379.6
580	2380.3
580	2380.6
580	2381.3
580	2381.6
580	2382.3
580	2382.6
580	2383.3
580	2383.6
580	2384.3
580	2384.6
580	2385.3
580	2385.6
580	2386.3
580	2386.6
580	2387.3
580	2387.6
580	2388.3
580	2388.6
580	2389.3
580	2389.6
580	2390.3
580	2390.6
580	2391.3
580	2391.6
580	2392.3
580	2392.6
580	2393.3
580	2393.6
580	2394.3
580	2394.6
580	2395.3
580	2395.6
580	2396.3
580	2396.6
580	2397.3
580	2397.6
580	2398.3
580	2398.6
580	2399.3
580	2399.6
580	2400.3
580	2400.6
580	2401.3
580	2401.6
580	2402.3
