
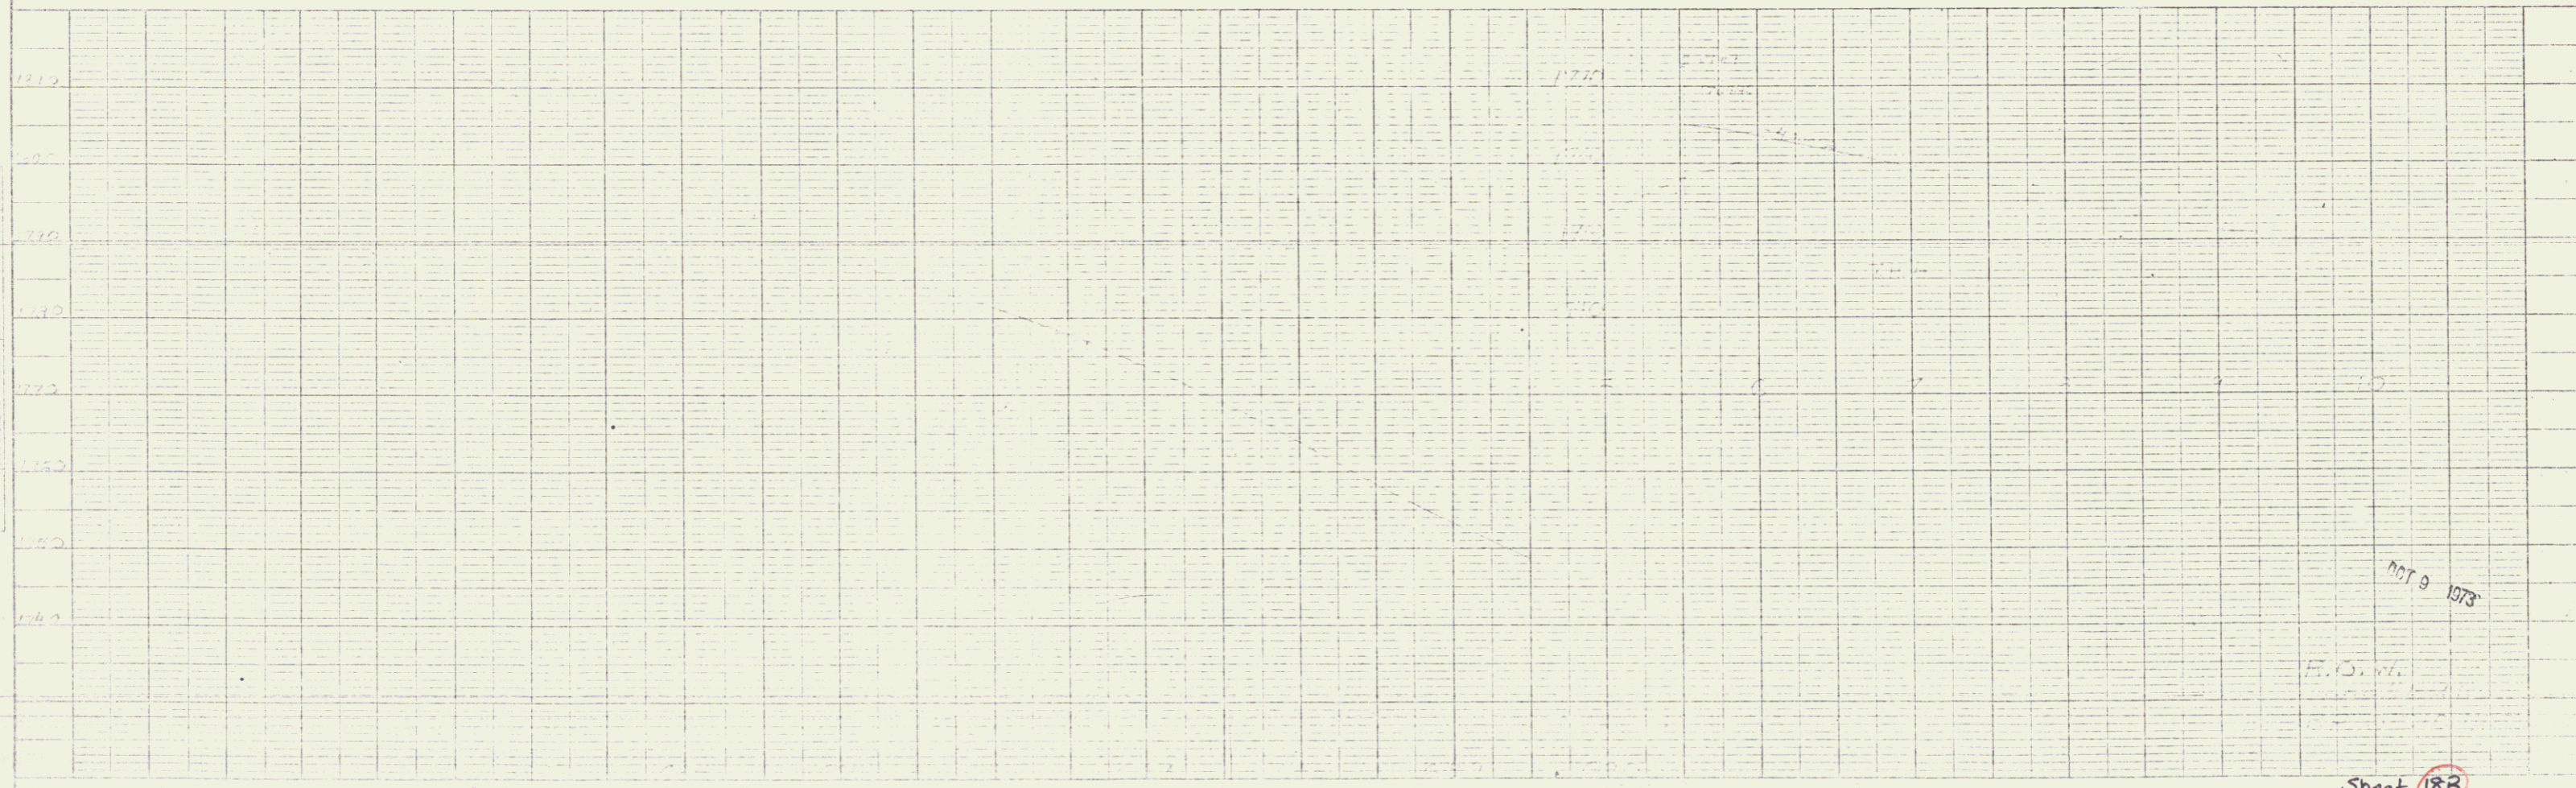


POOR ORIGINAL COPY

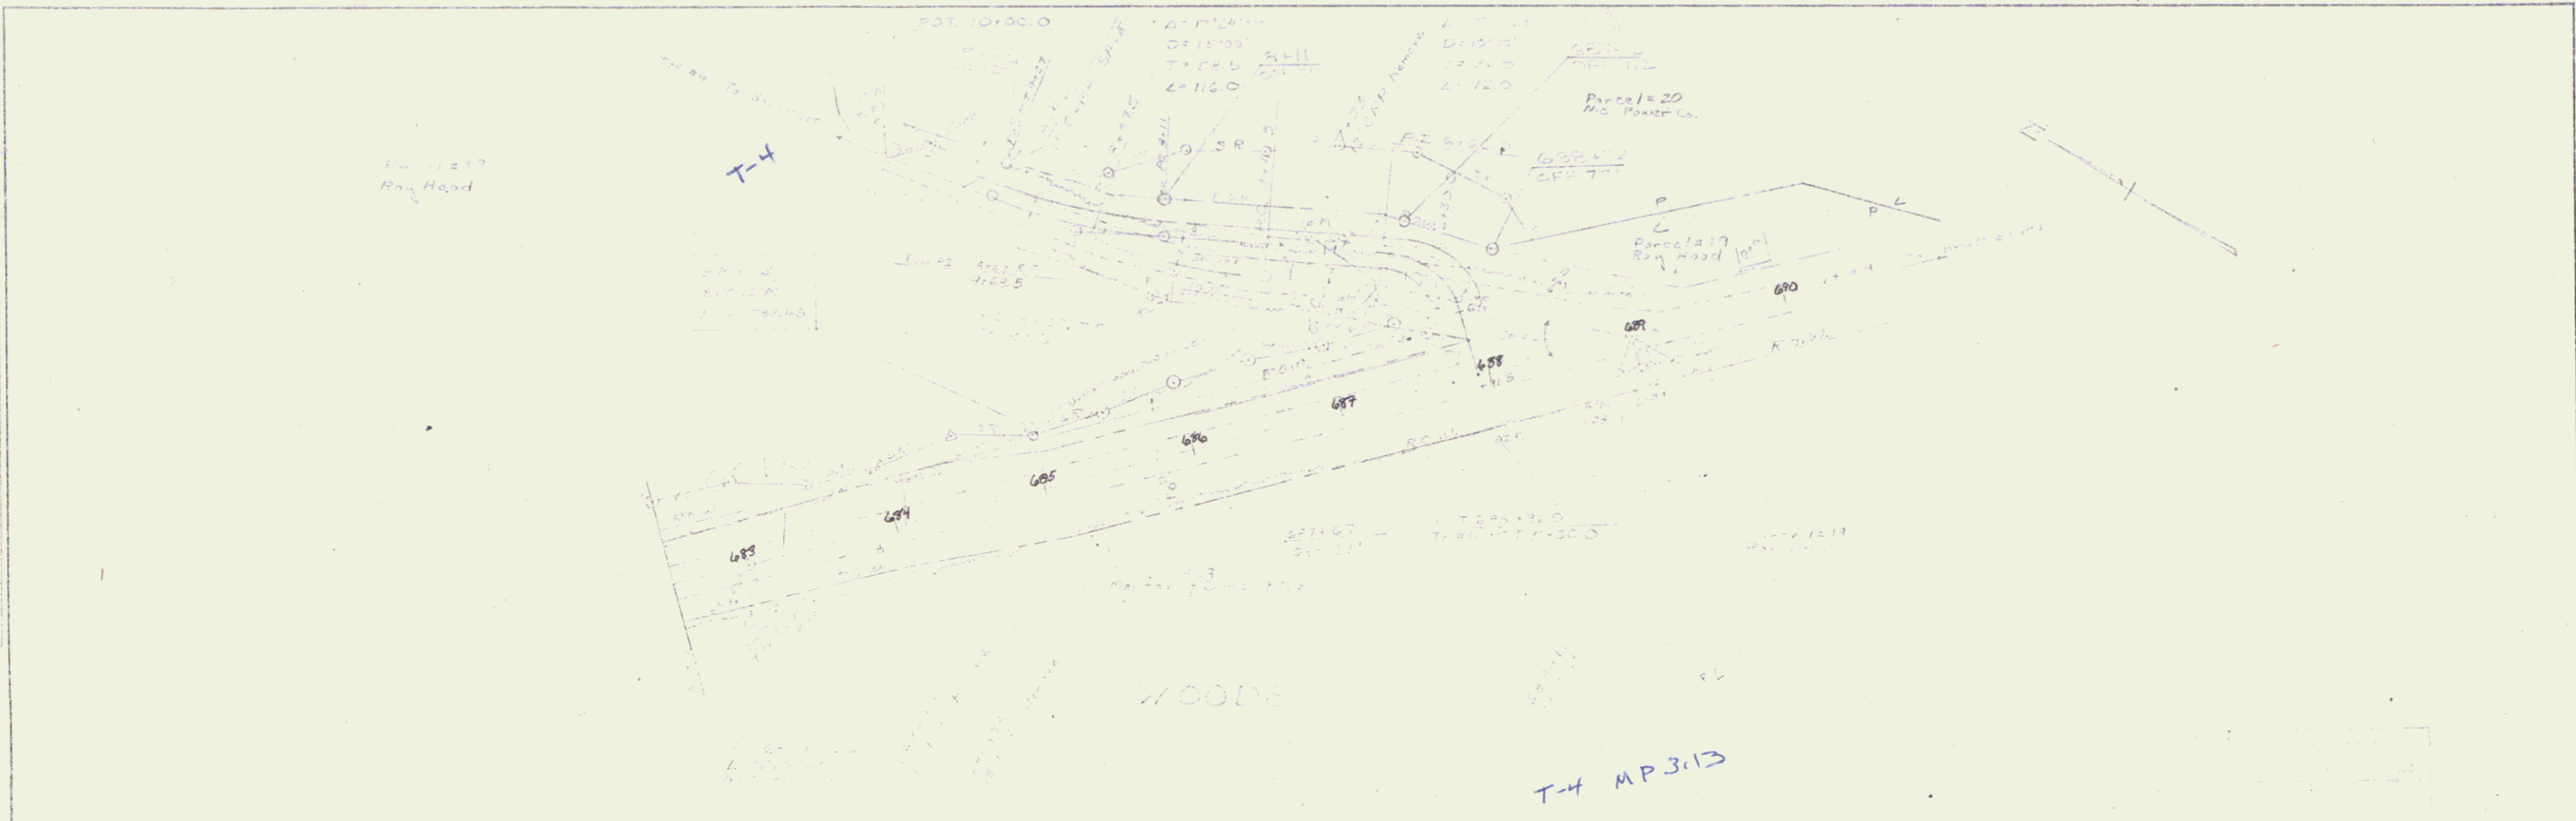

PLAN
 DATE: 10/1/73
 DRAWN BY: [illegible]
 CHECKED BY: [illegible]

PROFILE
 DATE: 10/1/73
 DRAWN BY: [illegible]
 CHECKED BY: [illegible]

Sheet 188