


POOR ORIGINAL COPY


111.01	111.02	111.03	111.04
111.05	111.06	111.07	111.08
111.09	111.10	111.11	111.12

105 E 1936 4 8
105 F 1936 5 6

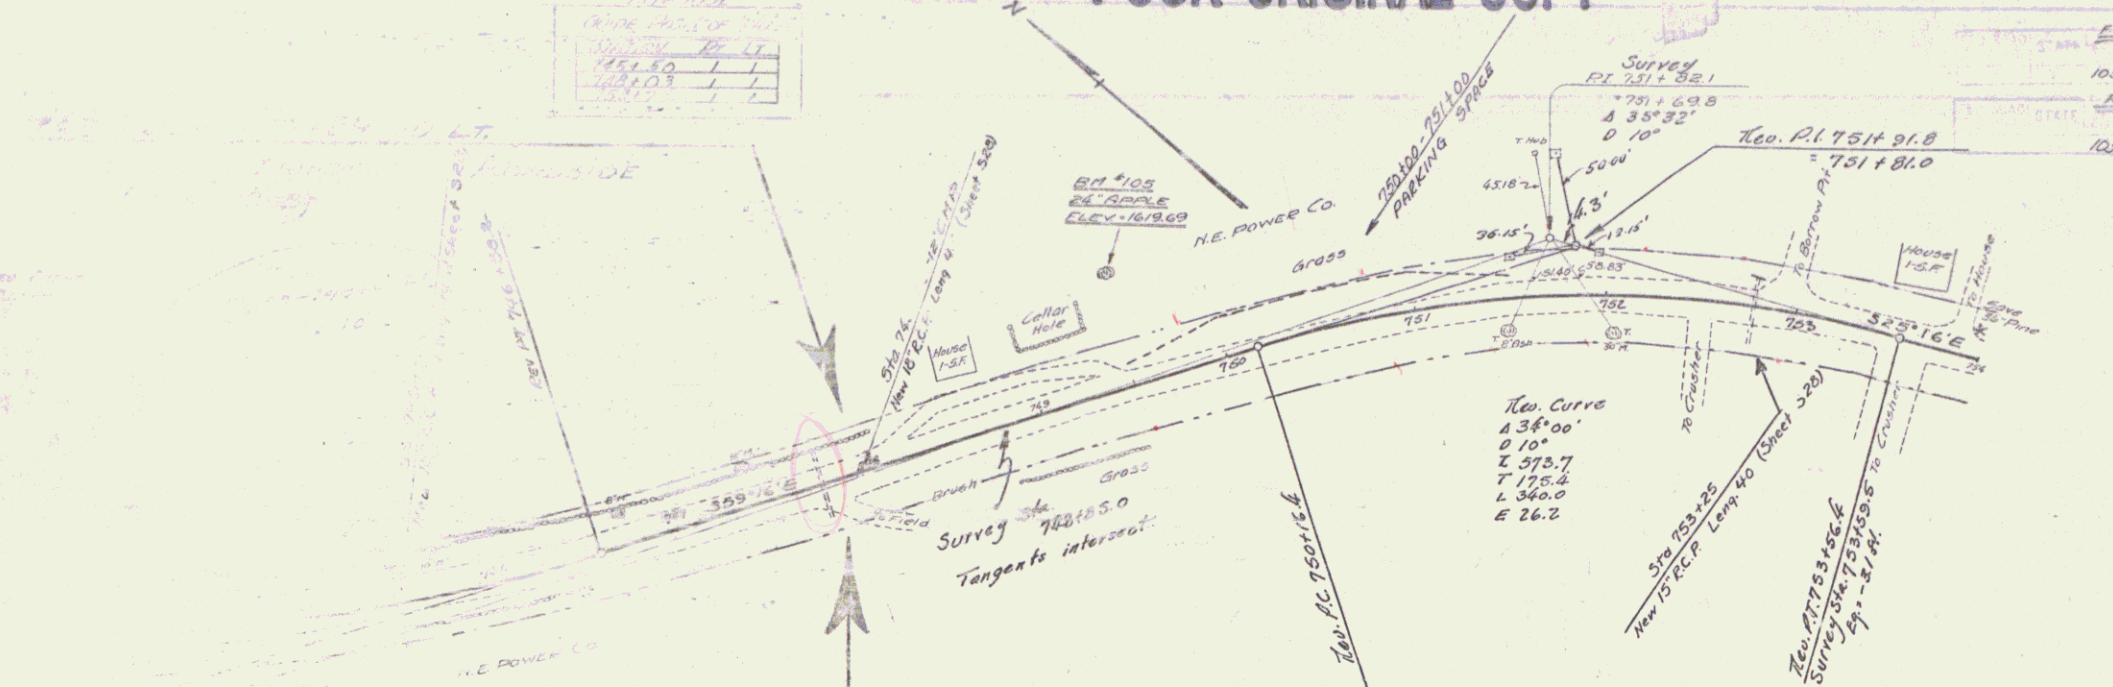

Now Special Shop Construction (S.P.C.) to include construction of Surface Gravel, Road Shoulders, Guard Rail and Guide Posts.
 Now Shop Construction (S.P.C.) included Grading, Subbase and Curbs, constructed in contract in 1934.
 The grades on this project are required from the finished surface.

TO BE SLOPE TO BE SECTED TO
 (ITEM 90-C)
 747+00 - 747+00 RT.

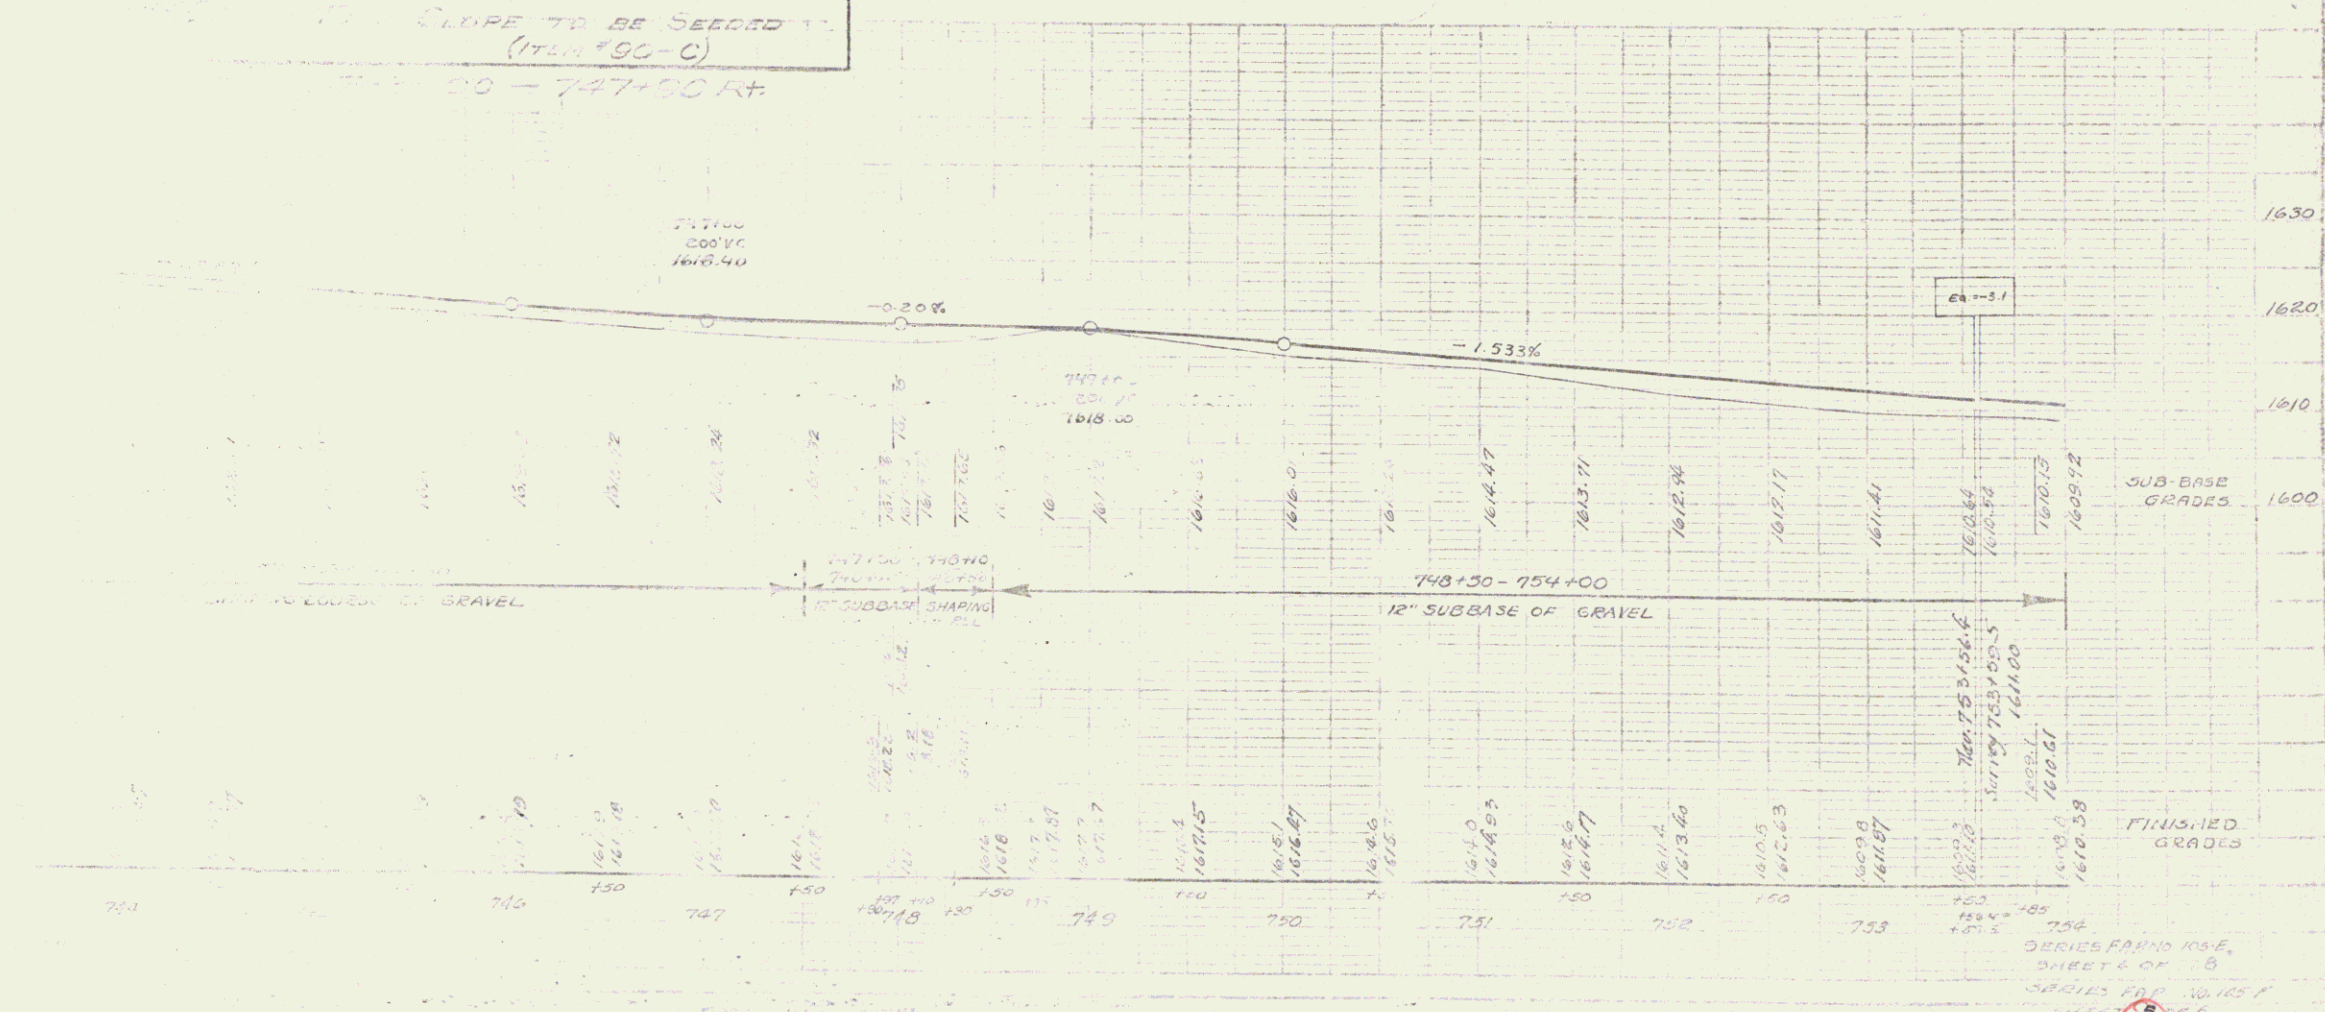

SERIES F&D 1936 E,
 SHEET NO. 8
 DRAWN BY: [Signature]
 CHECKED BY: [Signature]