

FAP 105F

CABLE GUARD RAIL		GUIDE POSTS OF WOOD	
STATION	PI	STATION	PI
757+120	120.3	757+120	120.3
757+150	150.0	757+150	150.0
760+180	180.0	760+180	180.0
761+122	122.0	761+122	122.0
765+160	160.7	765+160	160.7


105-I 1936 1 2A

CONCRETE R.O.W. MARKERS

STATION	LT.	RT.	DISTANCE
754+75			200 ft.
756+30			400 "
757+30			750 "
758+00			750 "
758+30			600 "
759+00			250 "
759+00			250 "
759+22			450 "
763+25			450 "
764+00			450 "
764+30			250 "

10 DEAD TREES TO BE REMOVED (ITEM #92-B)
757+00 - 768+00 FT.

PARCEL KIND OF DATE OF INSTRUMENT INSTRUMENT GRANTOR GRANTEE RECORDED REMARKS
#12 AB G.C.D. 310-34 NEW ENGLAND POWER CO. TR. 04/11/11 B 290-1 3-27-34

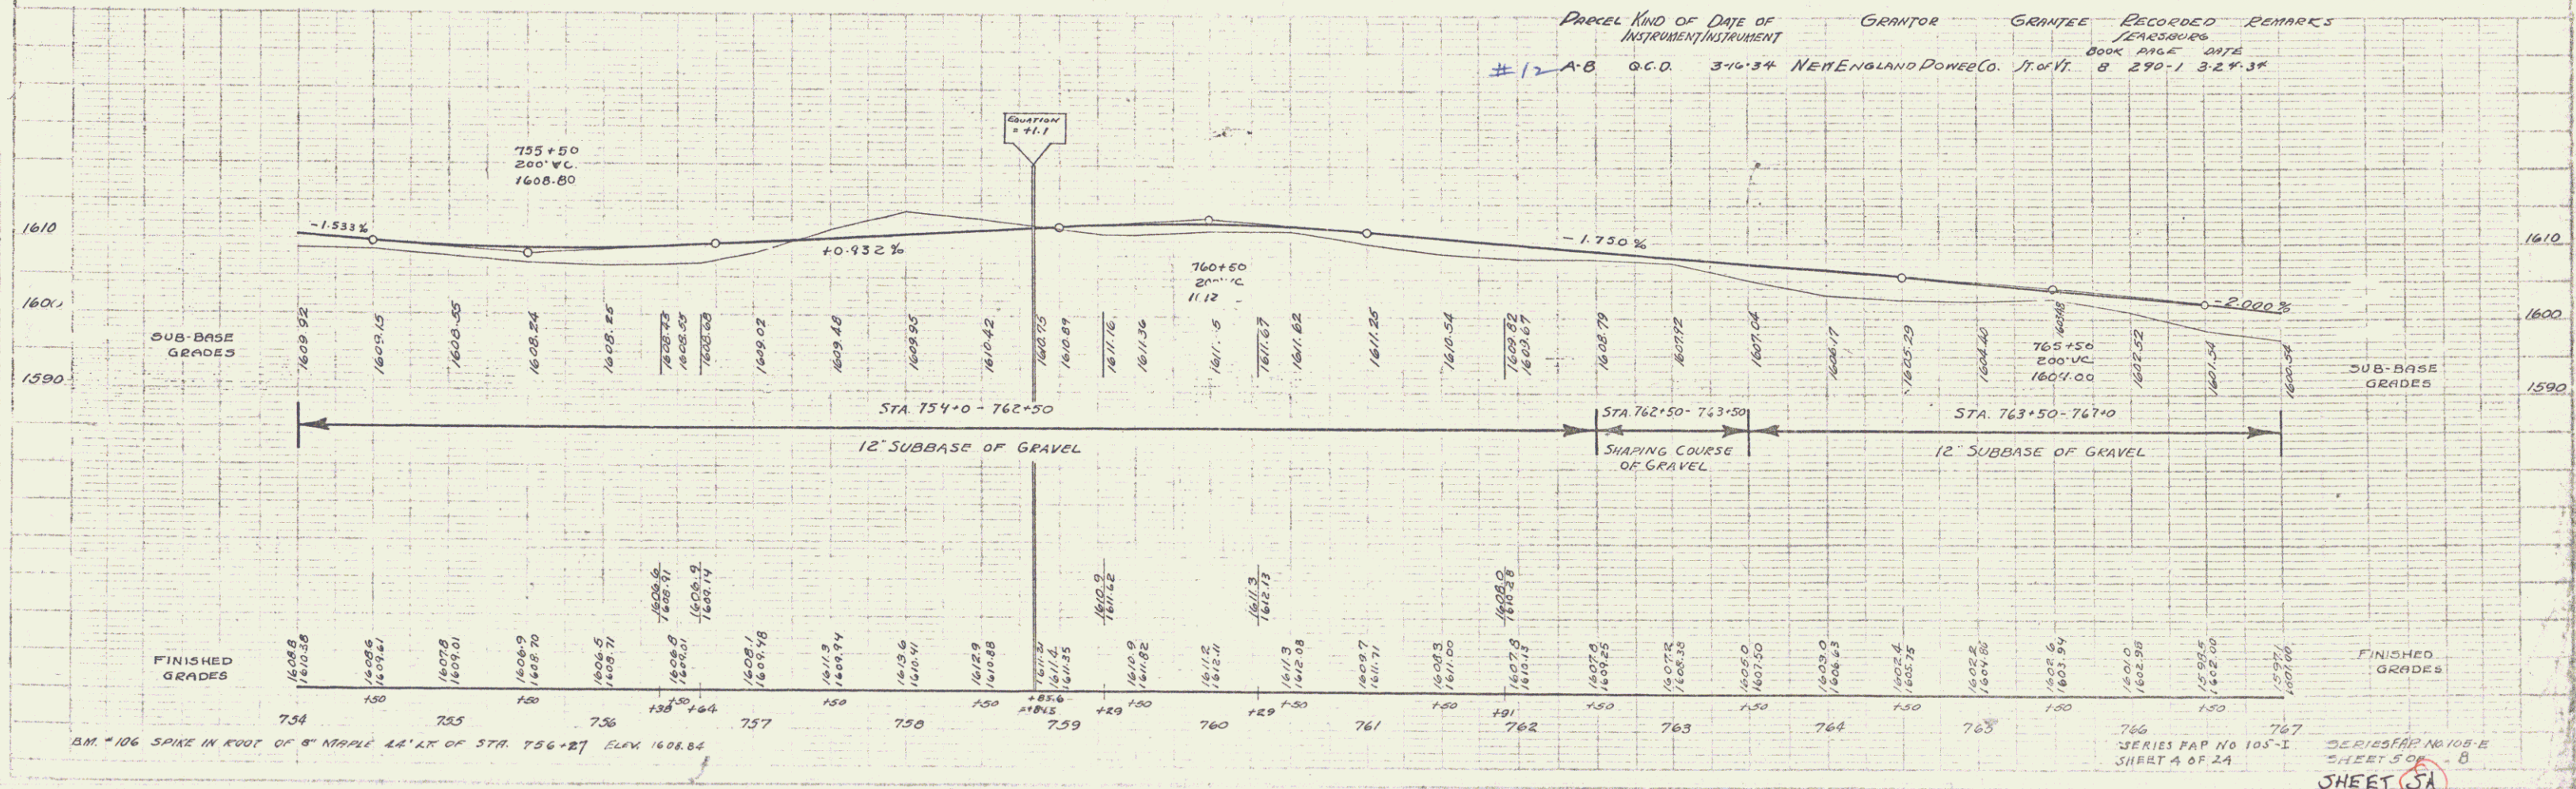

SERIES FAP NO 105-I
SHEET 4 OF 24
SERIES FAP NO 105-II
SHEET 5 OF 8
SHEET SA