


PLAN
 DATE
 DRAWN BY
 CHECKED BY
 TITLE

PROFILE
 DATE
 DRAWN BY
 CHECKED BY
 TITLE

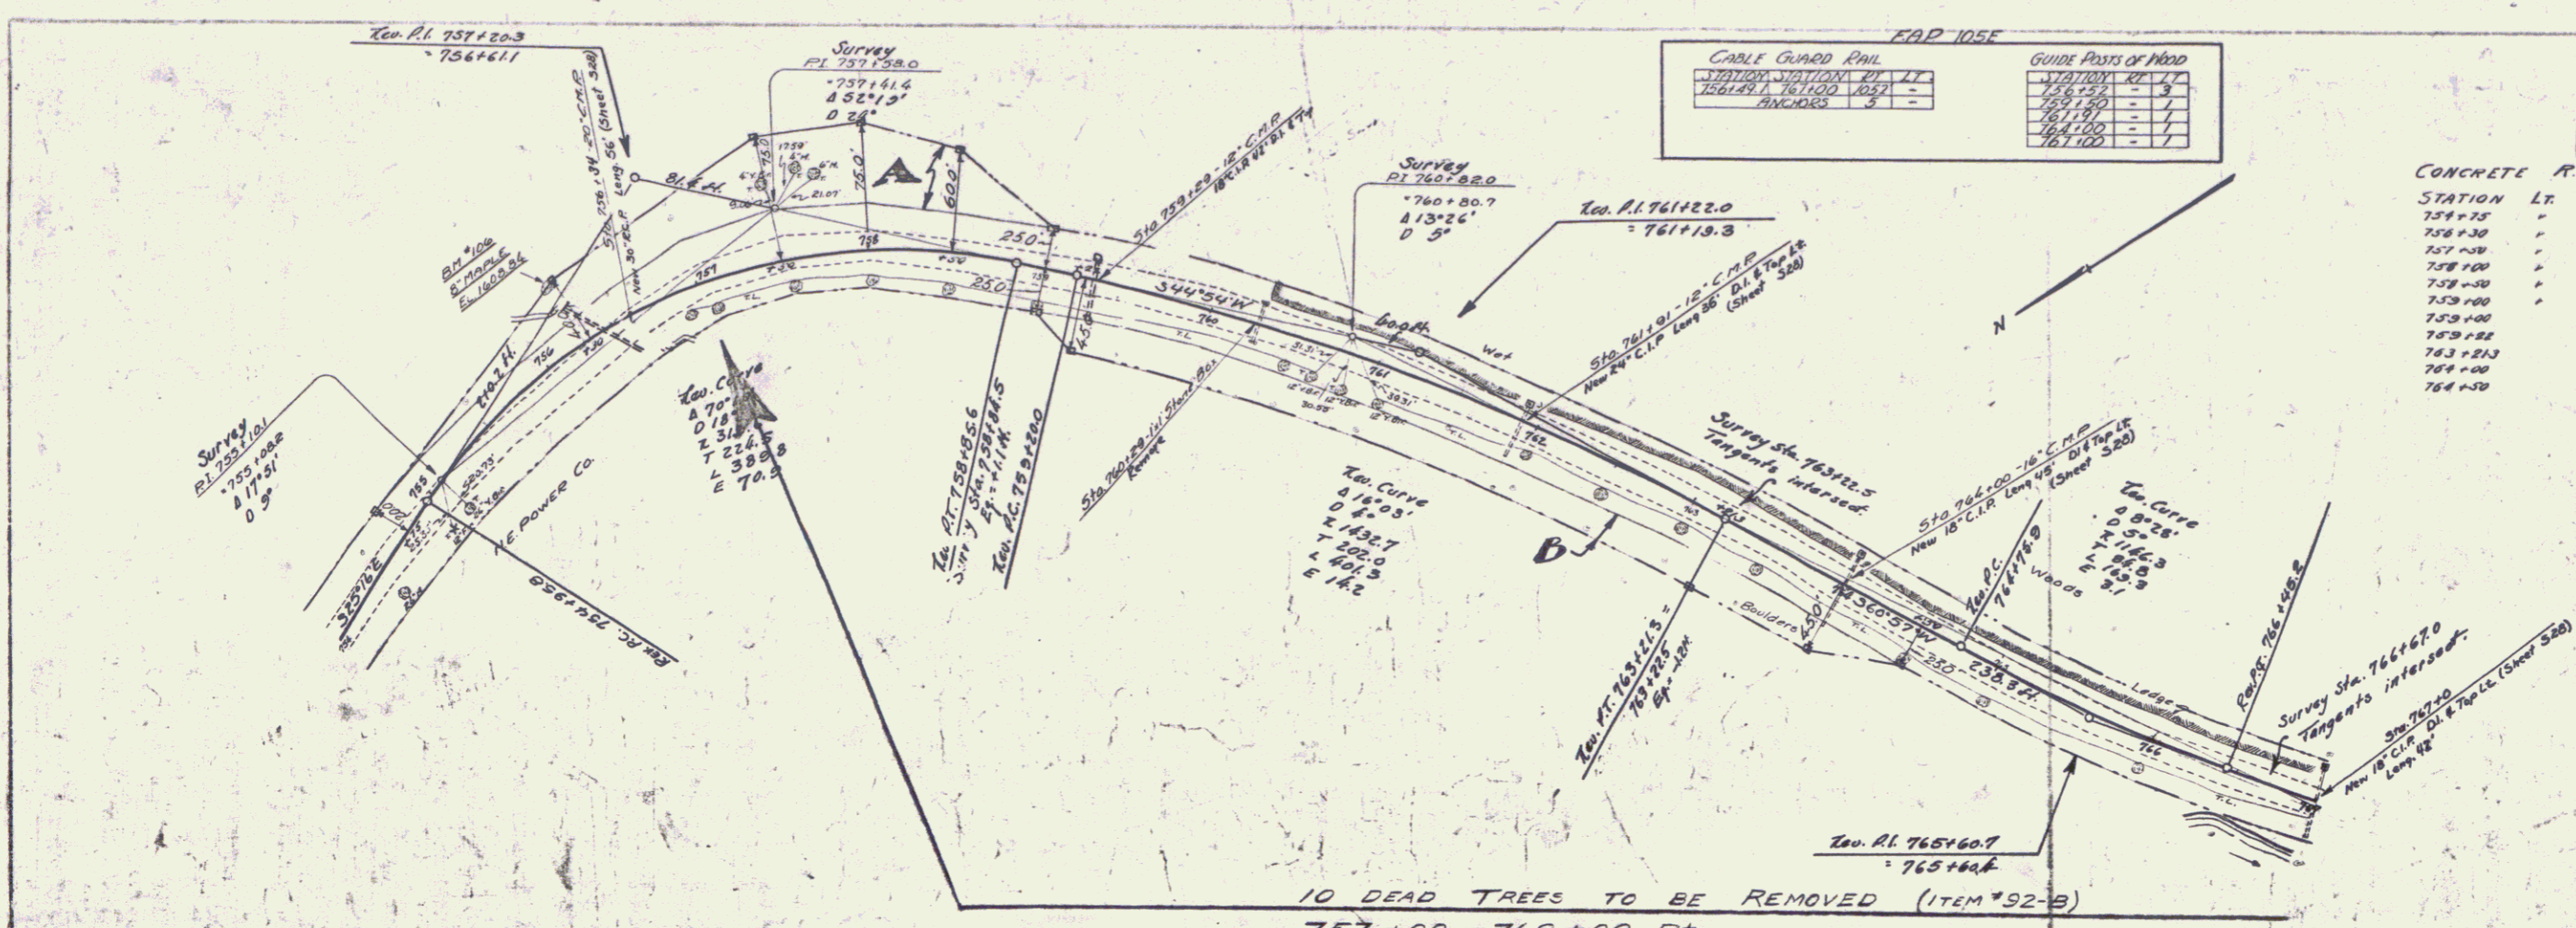


FAP 105E

CABLE GUARD RAIL		GUIDE POSTS OF WOOD	
STATION	REMARKS	STATION	REMARKS
754+00	1	754+00	1
755+00	1	755+00	1
756+00	1	756+00	1
757+00	1	757+00	1
758+00	1	758+00	1
759+00	1	759+00	1
760+00	1	760+00	1
761+00	1	761+00	1

FAP
 105-E 1936 5 B
 105-I 1936 1 24

CONCRETE R.O.W. MARKERS

STATION	LT	RT	DISTANCE
754+25	-	-	200 FT.
754+30	-	-	400 "
757+00	-	-	750 "
758+00	-	-	800 "
759+00	-	-	850 "
759+00	-	-	850 "
759+25	-	-	850 "
763+25	-	-	450 "
764+00	-	-	450 "
764+25	-	-	250 "

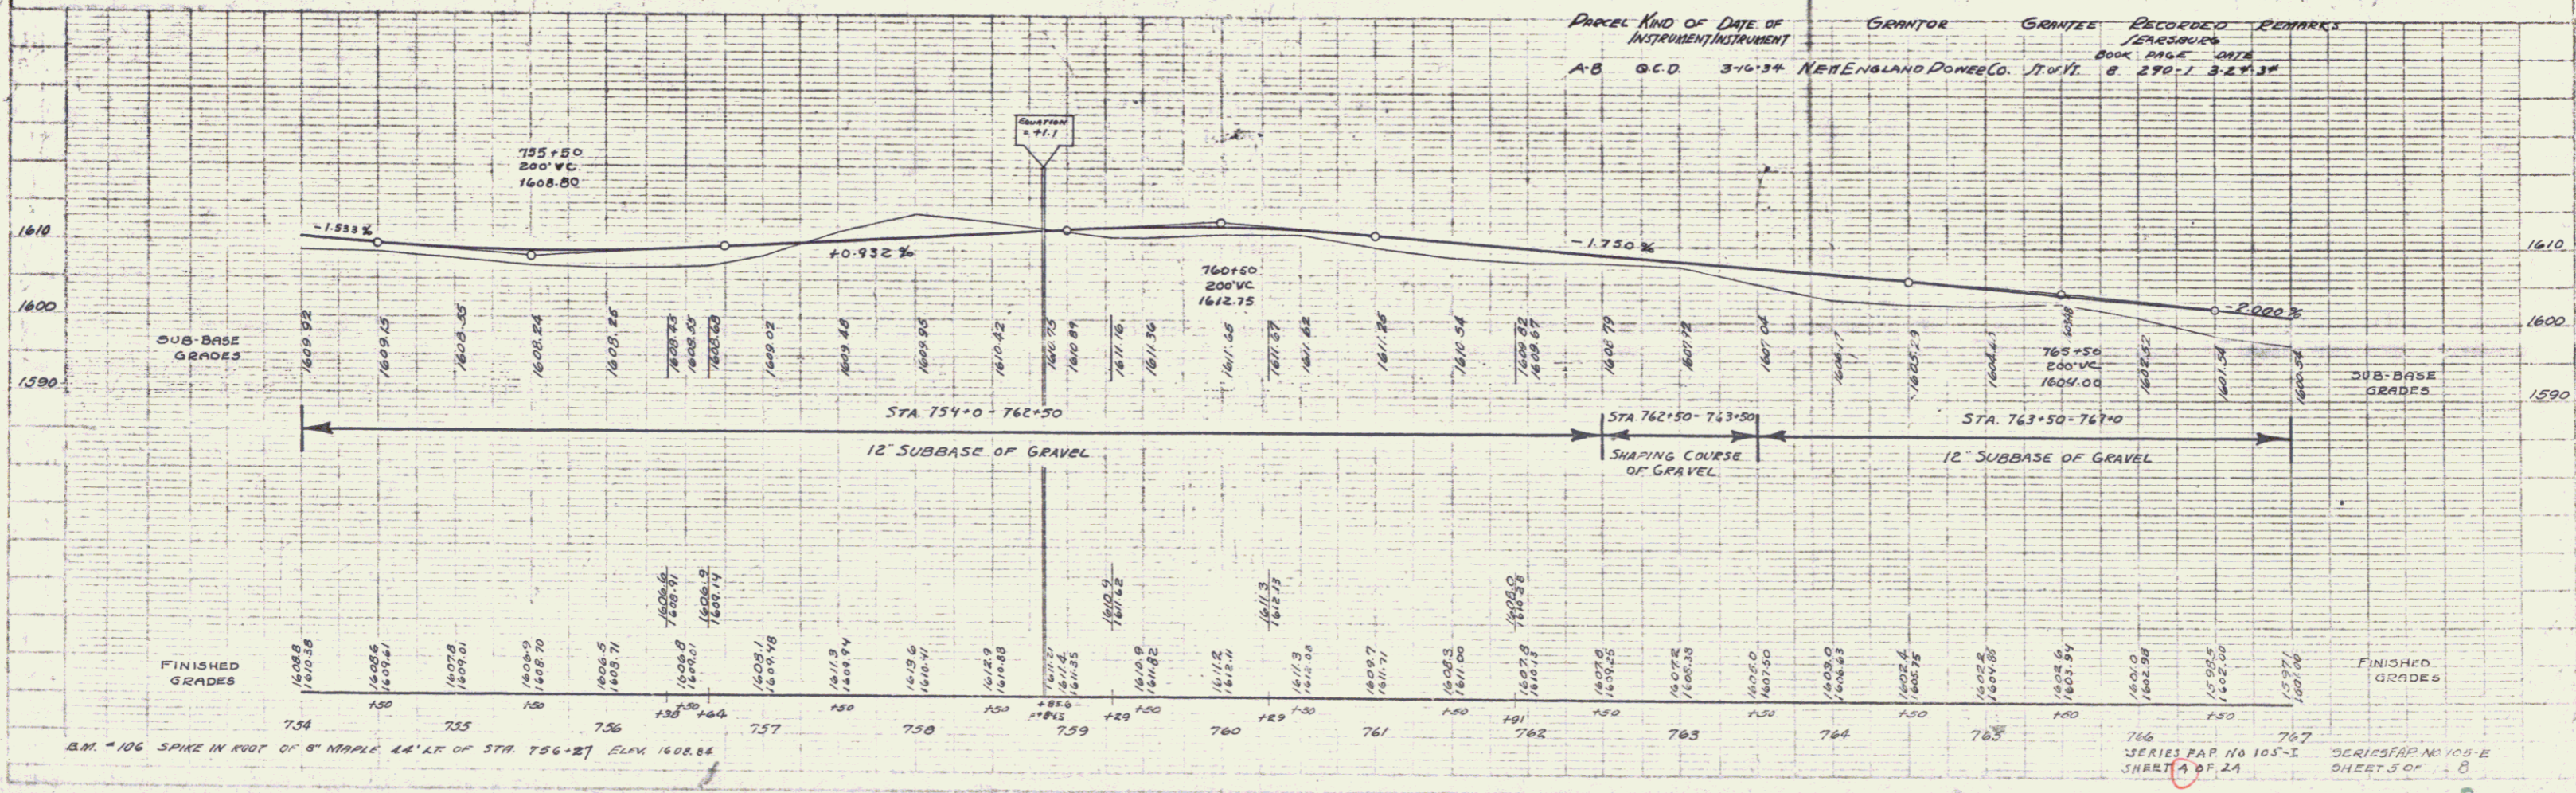

PARCEL KIND OF DATE OF INSTRUMENT GRANTOR GRANTEE RECORDED REMARKS
 A.B. G.C.D. 3-10-34 NERENGLAND DOWNS CO. ST. N.Y. BOOK PAGE 290-1 3-27-38

766
 SERIES FAP NO 105-E
 SHEET 4 OF 24

767
 SERIES FAP NO 105-E
 SHEET 5 OF 24