



Plan No. 105-I 1986 71 24  
 Date 63 H 136 4 45

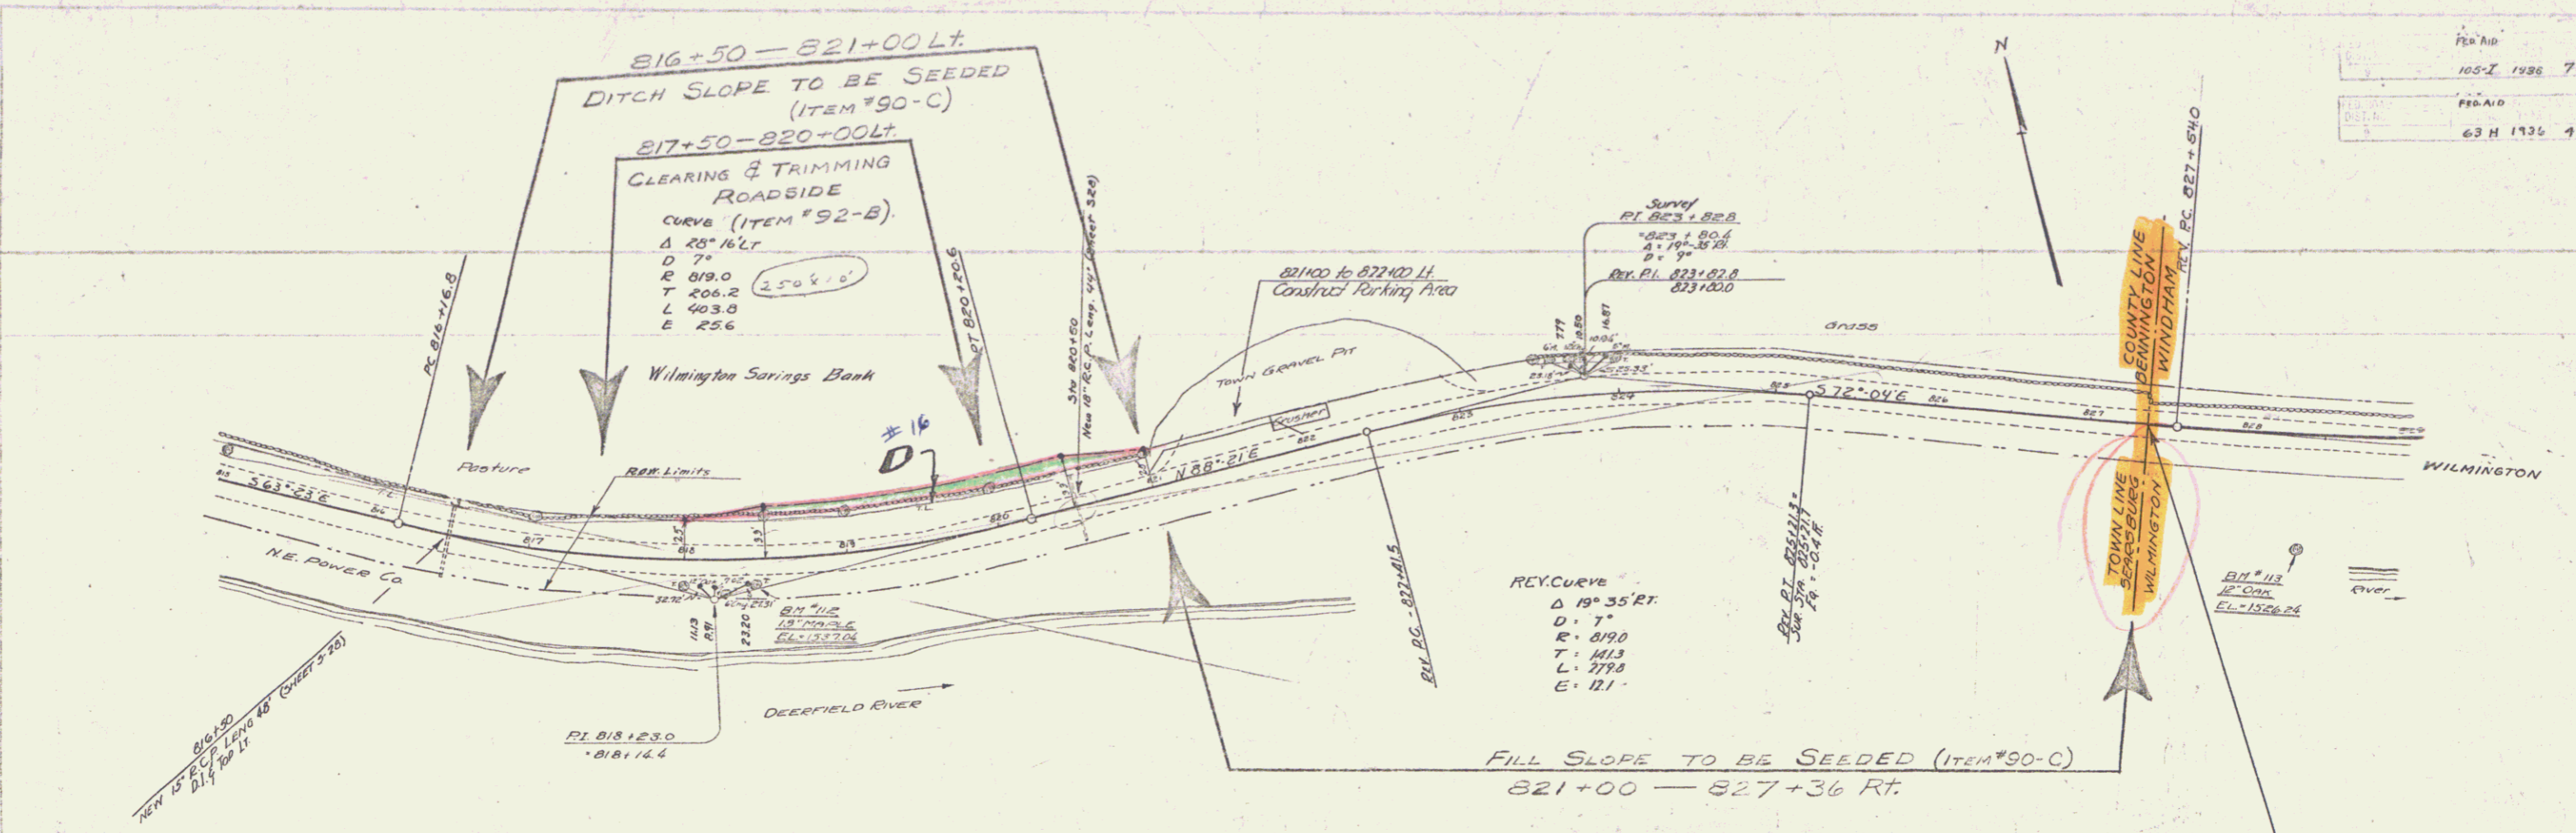

PARCEL KIND OF DATE OF GRANTOR GRANTEE RECORDED REMARKS  
 INSTRUMENT  
 A.B.C.D. W.D. 6-29-35 WILMINGTON SAVINGS BANK ST. OFT. © 395-47 8-10-35

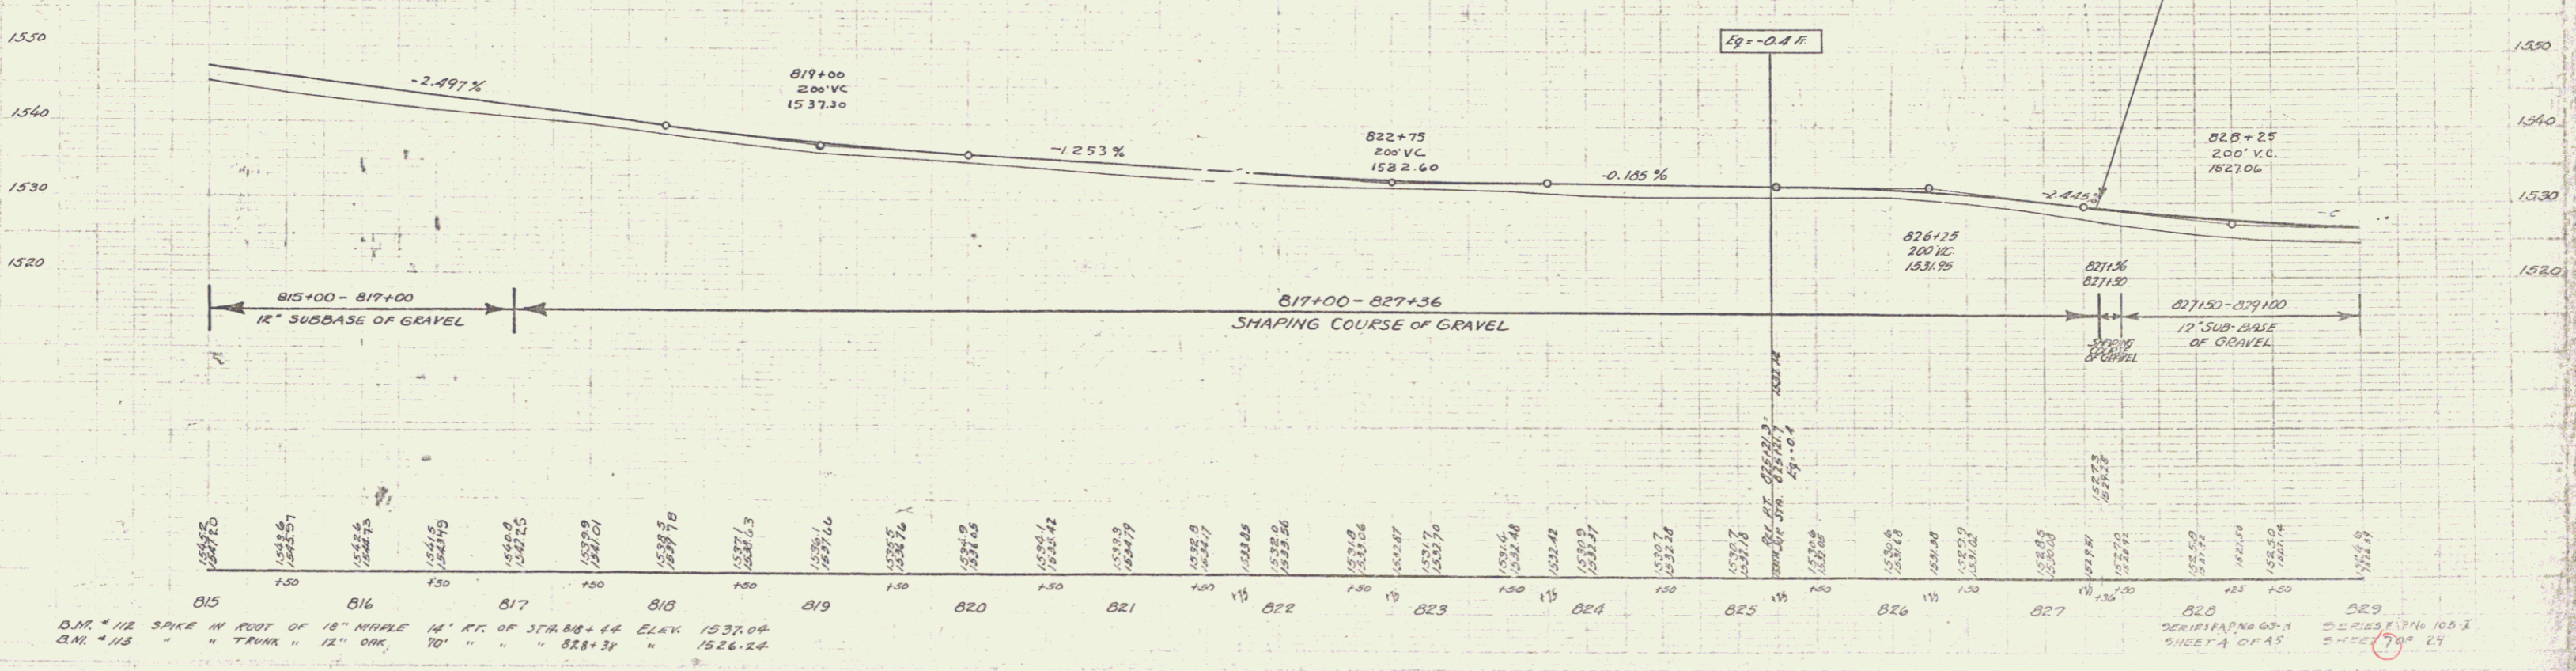

D.M. #12 SPIKE IN ROOT OF 18" NIPPLE 14' RT. OF STA 84+44 ELEV. 1537.04  
 D.M. #13 " " TRUNK " 12" DIAK. 70' " " " 828+34 " 1526.24