


PARCEL NO.	DATE OF INSTRUMENT	GRANTOR	GRANTEE	RECORDED	REMARKS
1	Q.C.D. 10-4-35	Frank G. Smith (Trustee)	B. B. Schenck Leonard	31 of 11, 30 193-199	10-D-35

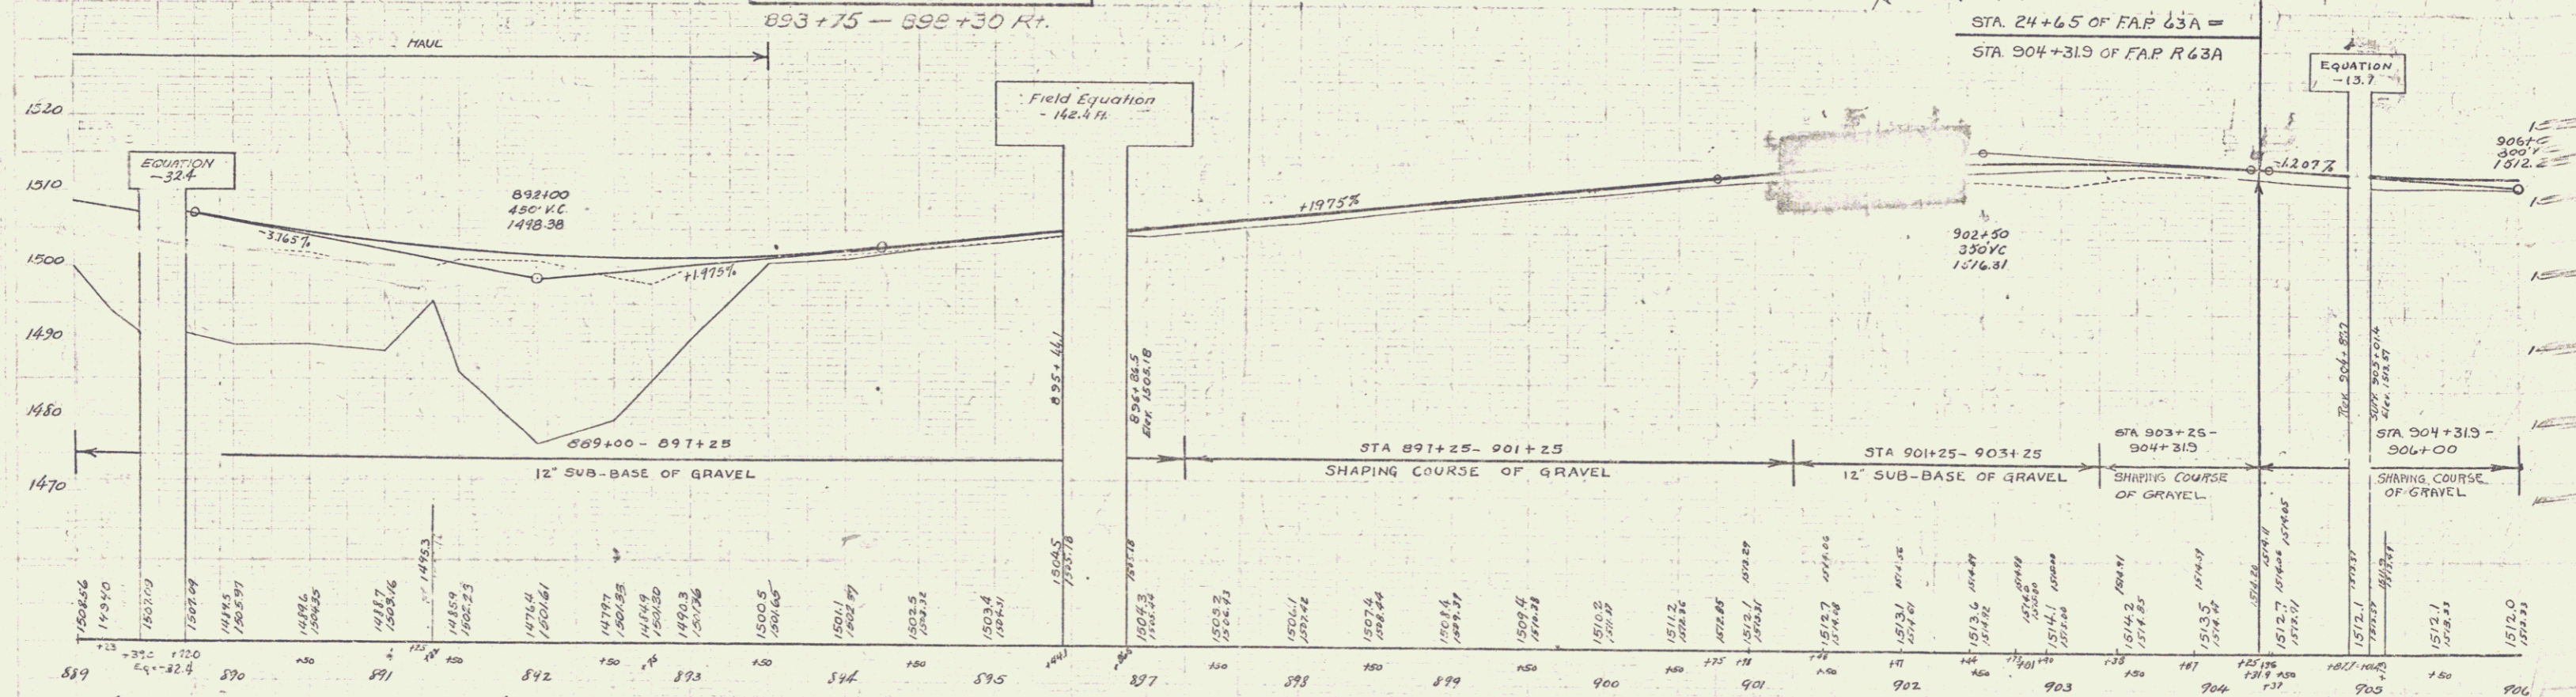

BMT #120 SAKL IN ROOT 18" MAPLE 70' RT. STA. 894+80 EL. 1499.61