



PARCEL #510 OF DATE OF INSTRUMENT GEANTOR GEANTOR RECORDED REMARKS
 ABC-D C.C.D. 6-28-35 Camp Jeshurun Staff: 30 194-7 6-29-35
 MILWAUKEE

STATE OF WISCONSIN
 COUNTY OF MILWAUKEE
 DISTRICT NO. 1
 63-N 1936 11 45

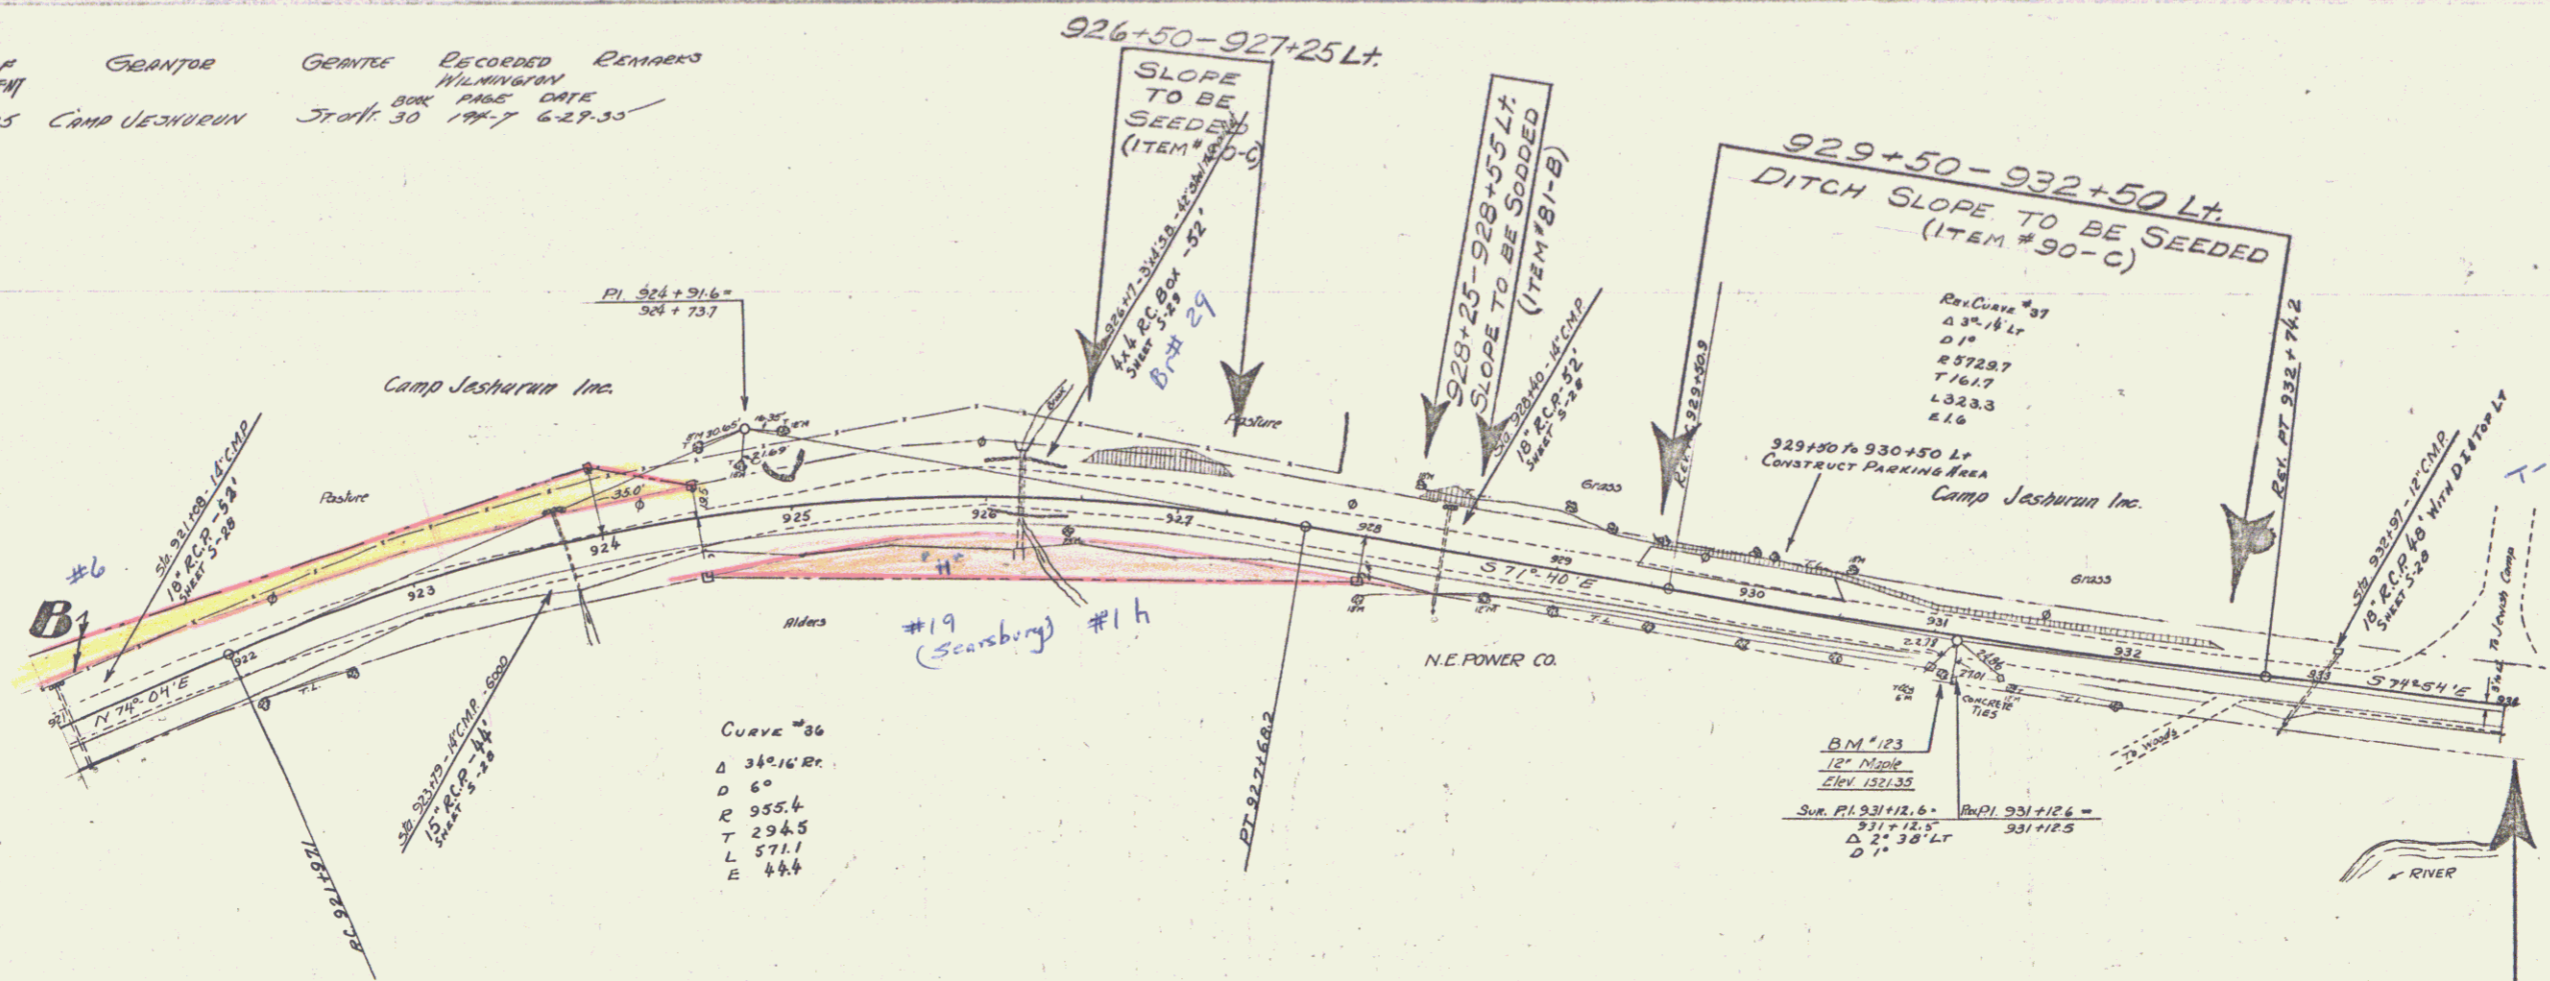

FILL SLOPE TO BE SEEDED (ITEM #90-C)
 914+00 — 934+00 Ft.

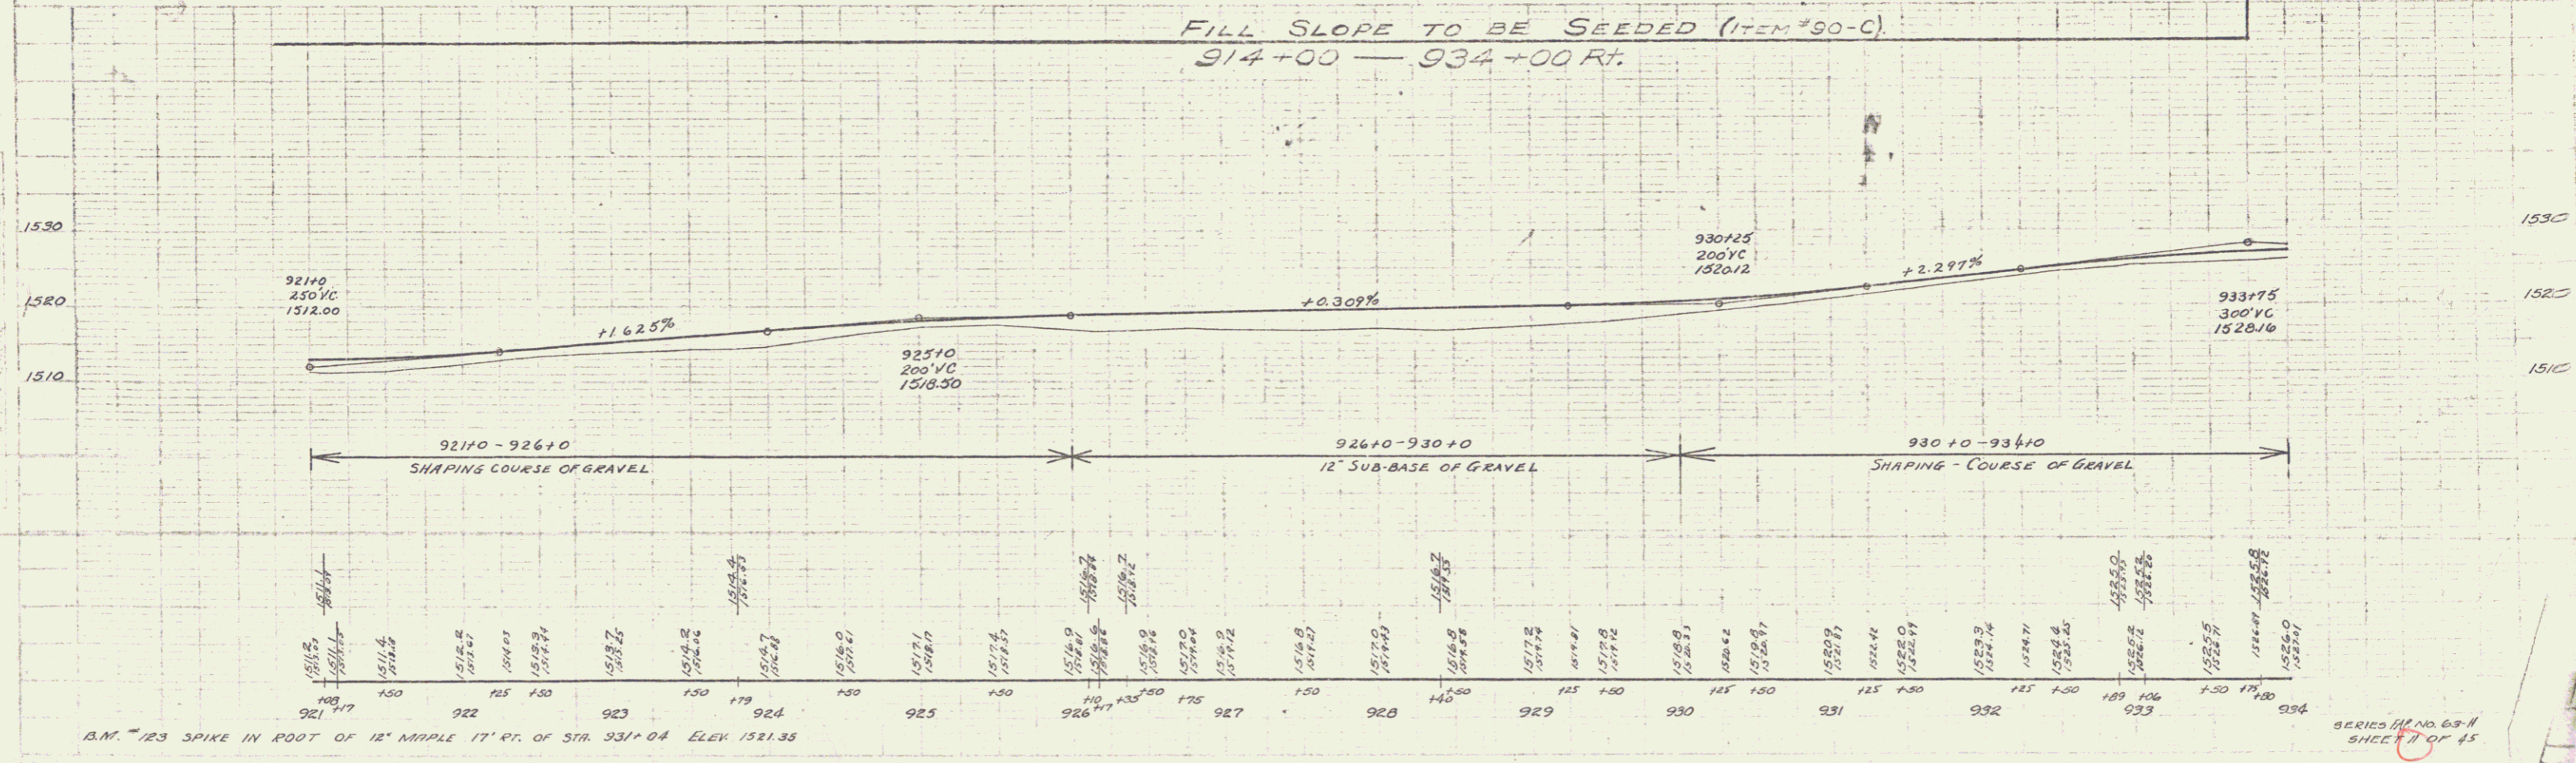

B.M. #123 SPIKE IN ROOT OF 12\"/>

SERIES #1 NO. 63-N SHEET 7 OF 15