
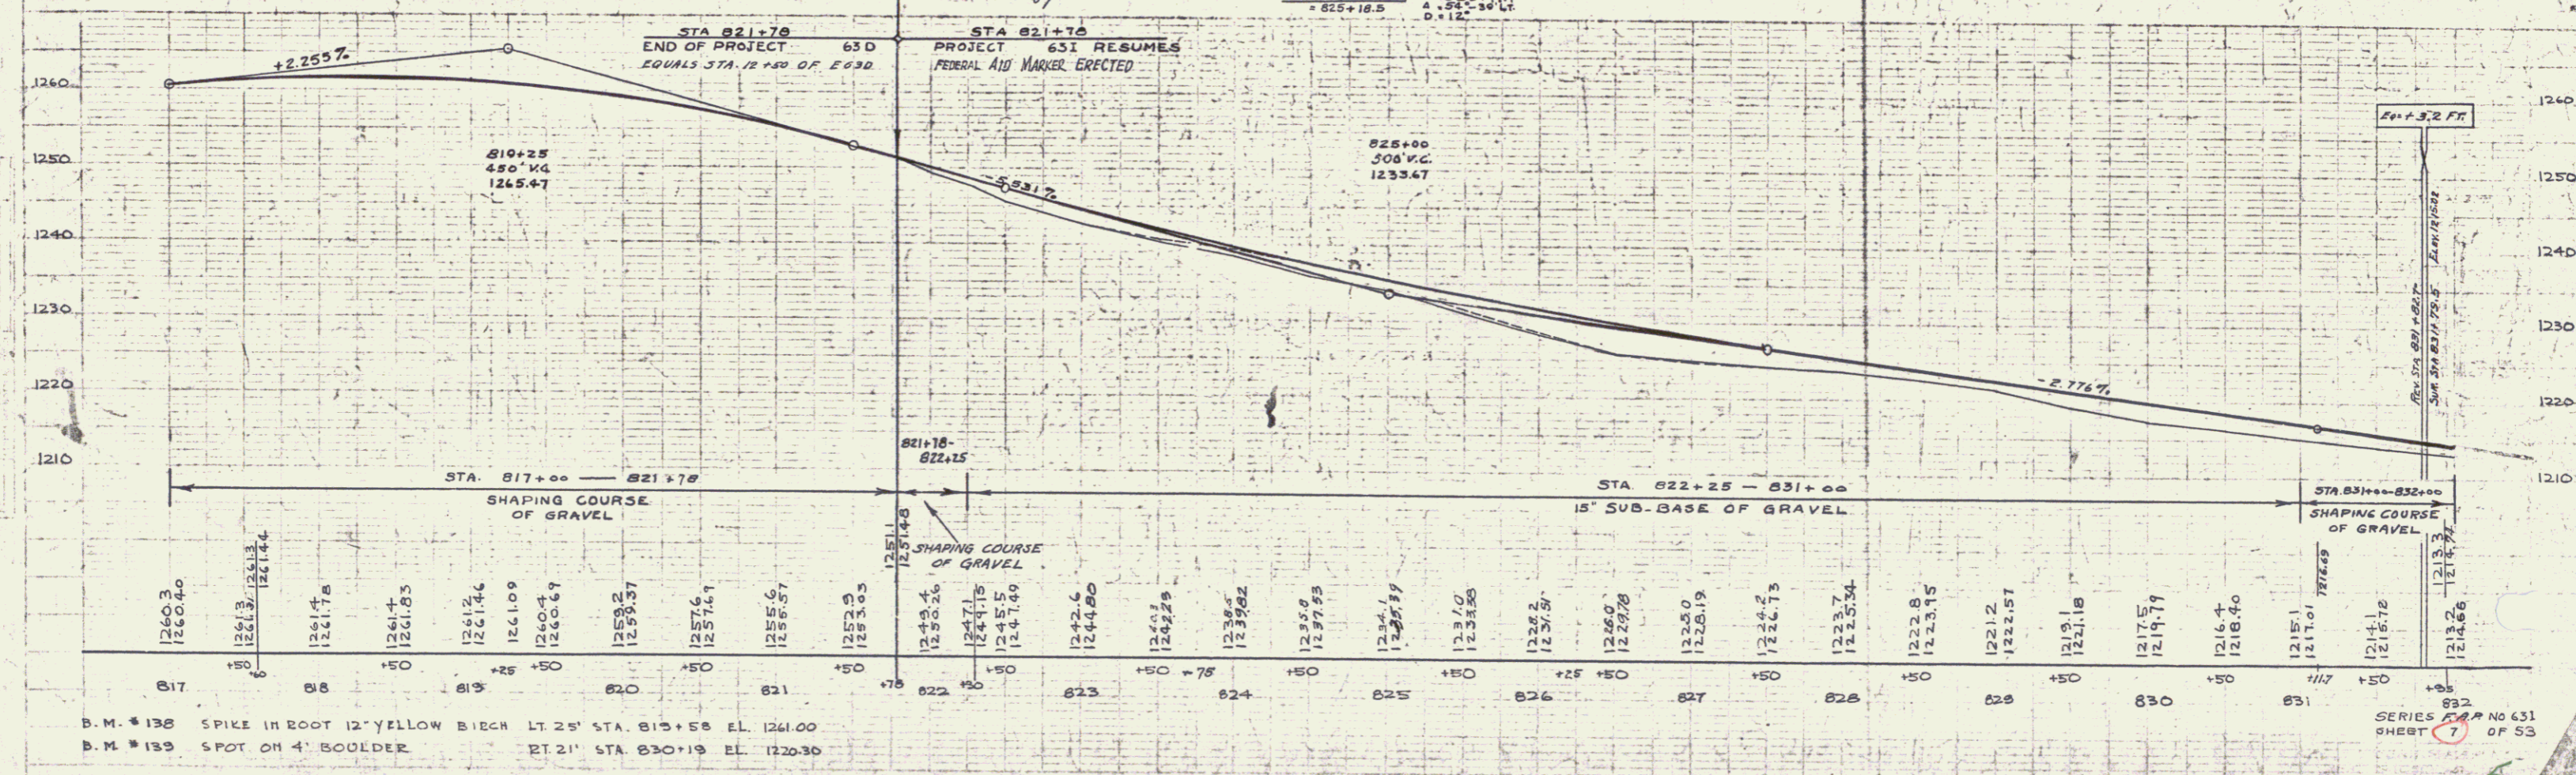


FED. ROAD DIST. NO.	STATE	FED. AID PROJ. NO.	FISCAL YEAR	SHEET NO.	TOTAL SHEETS
3	VT	651 (1938)	7	53	

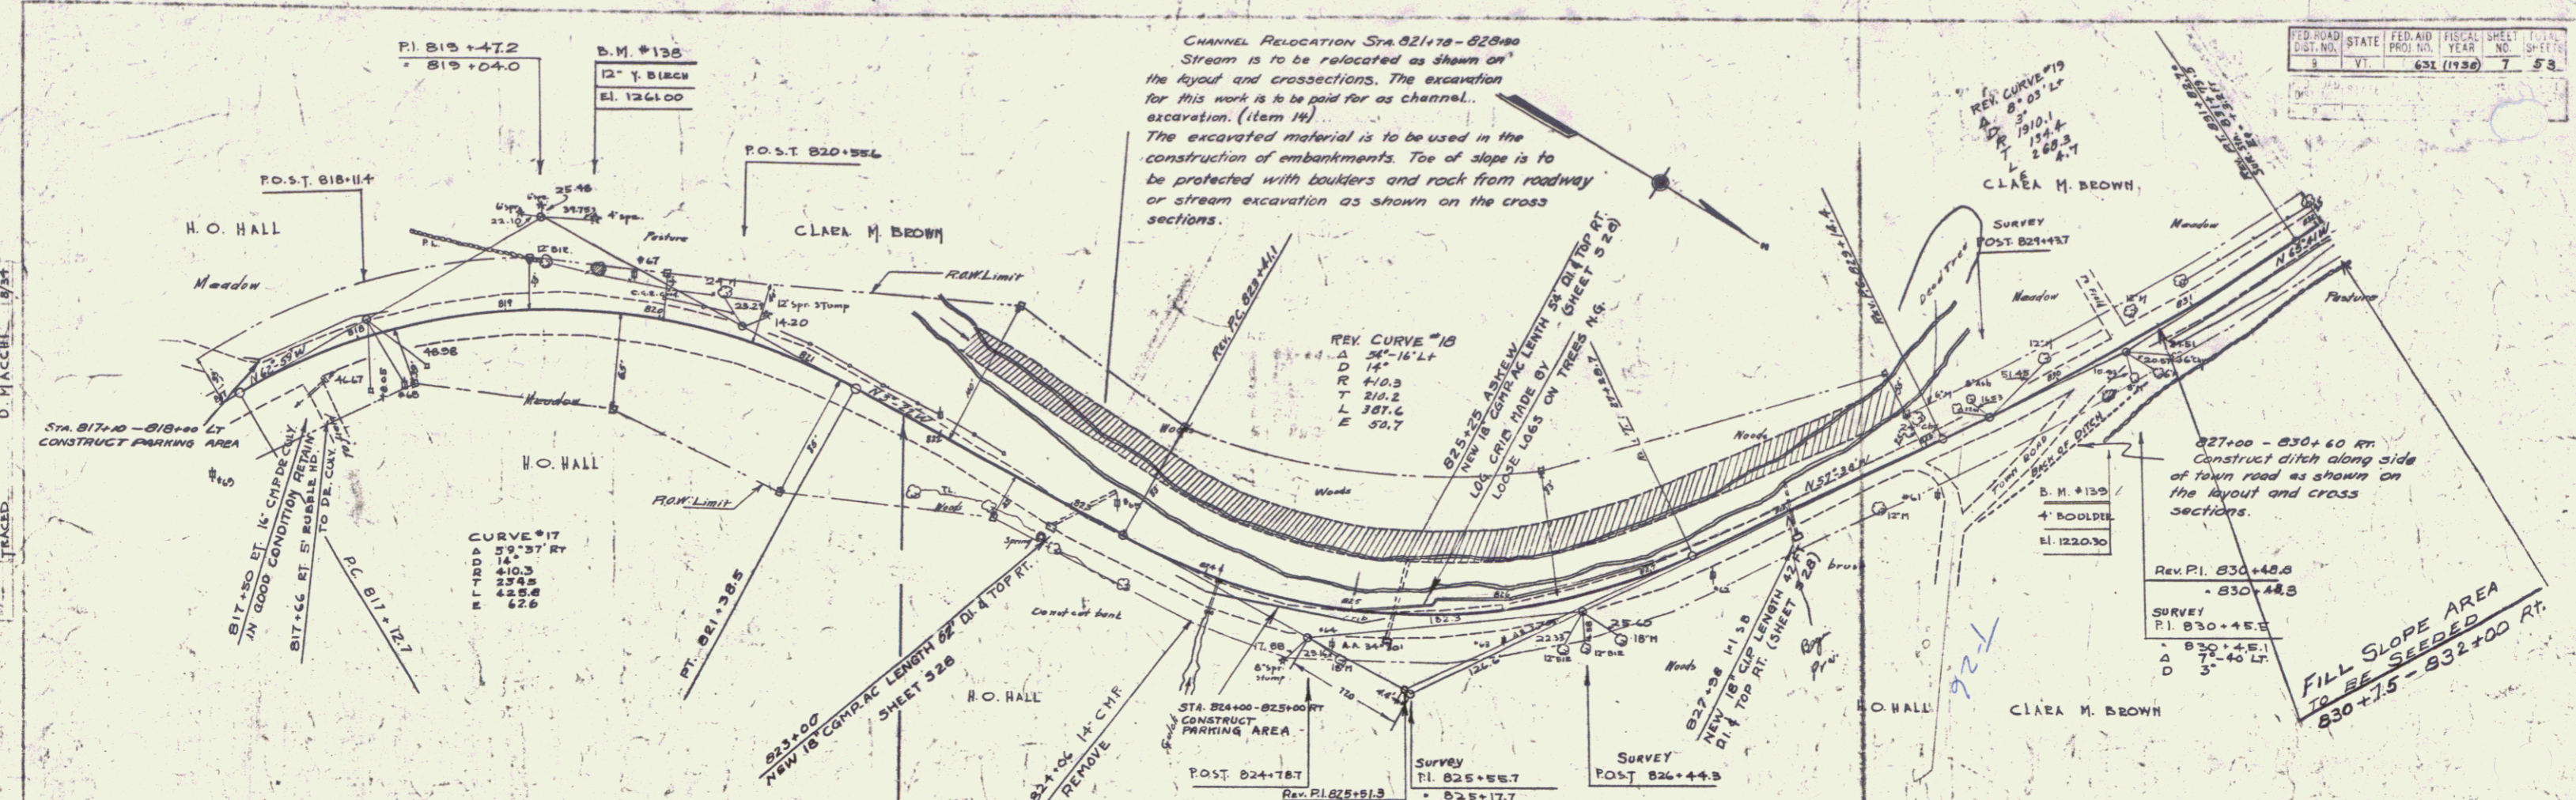

D.M. #138 SPIKE IN ROOT 12" YELLOW BIRCH LT 25' STA. 813+58 EL. 1261.00
 D.M. #139 SPOT ON 4' BOULDER RT 21' STA 830+19 EL. 1220.30

SERIES 651 No 651 SHEET 7 OF 53