
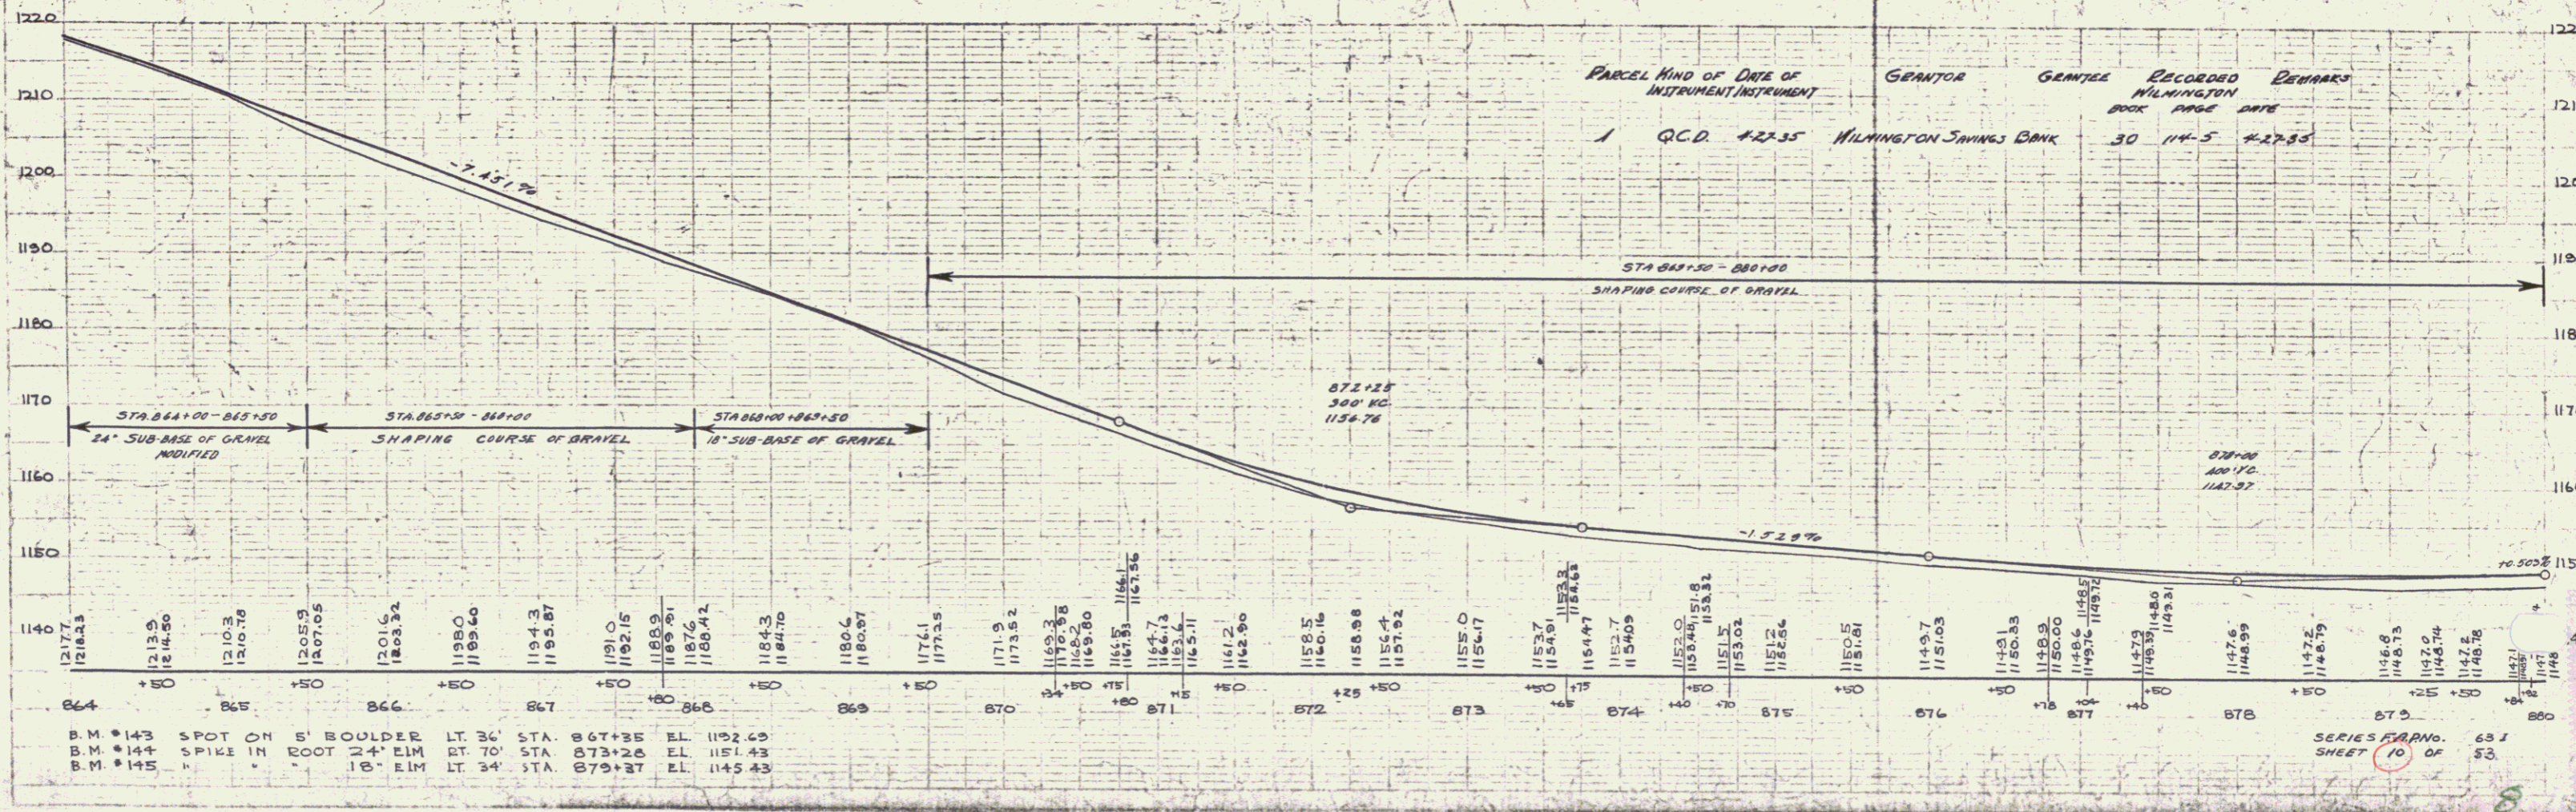


BOVINACCHI 8/34
 D. MACCHI 8/34
 PLACED

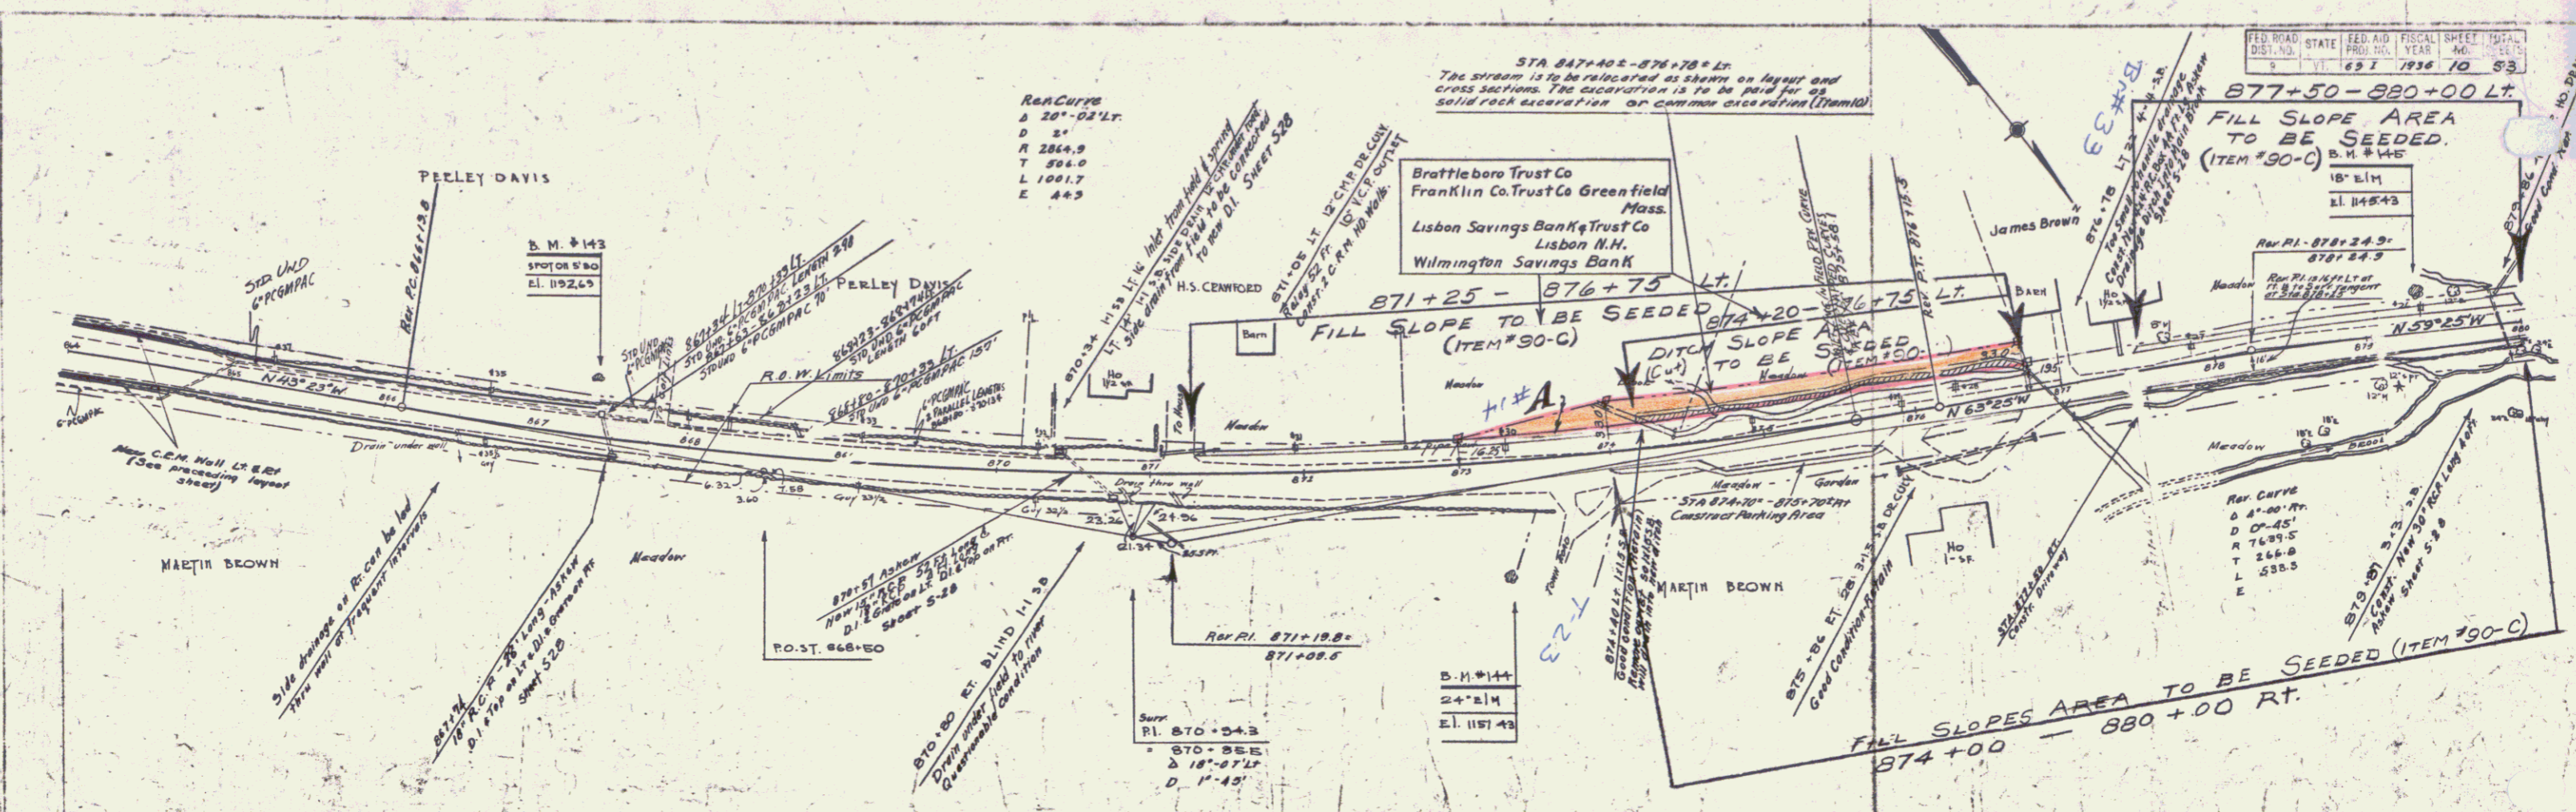

B.M.	Description	Station	Elevation
B.M. #143	SPOT ON S BOULDER LT. 36'	STA. 867+35	EL. 1192.69
B.M. #144	SPIKE IN ROOT 24' EIM RT. 70'	STA. 873+26	EL. 1151.43
B.M. #145	18' EIM LT. 34'	STA. 879+37	EL. 1145.43

PARCEL	HIND OF DIRT OF INSTRUMENT	GRANTOR	GRANTEE	RECORDED	REMARKS
1	Q.C.D. #2735	WILMINGTON SAVINGS BANK	30	114-5	#2735

SERIES MAP NO. 631
 SHEET 10 OF 53