
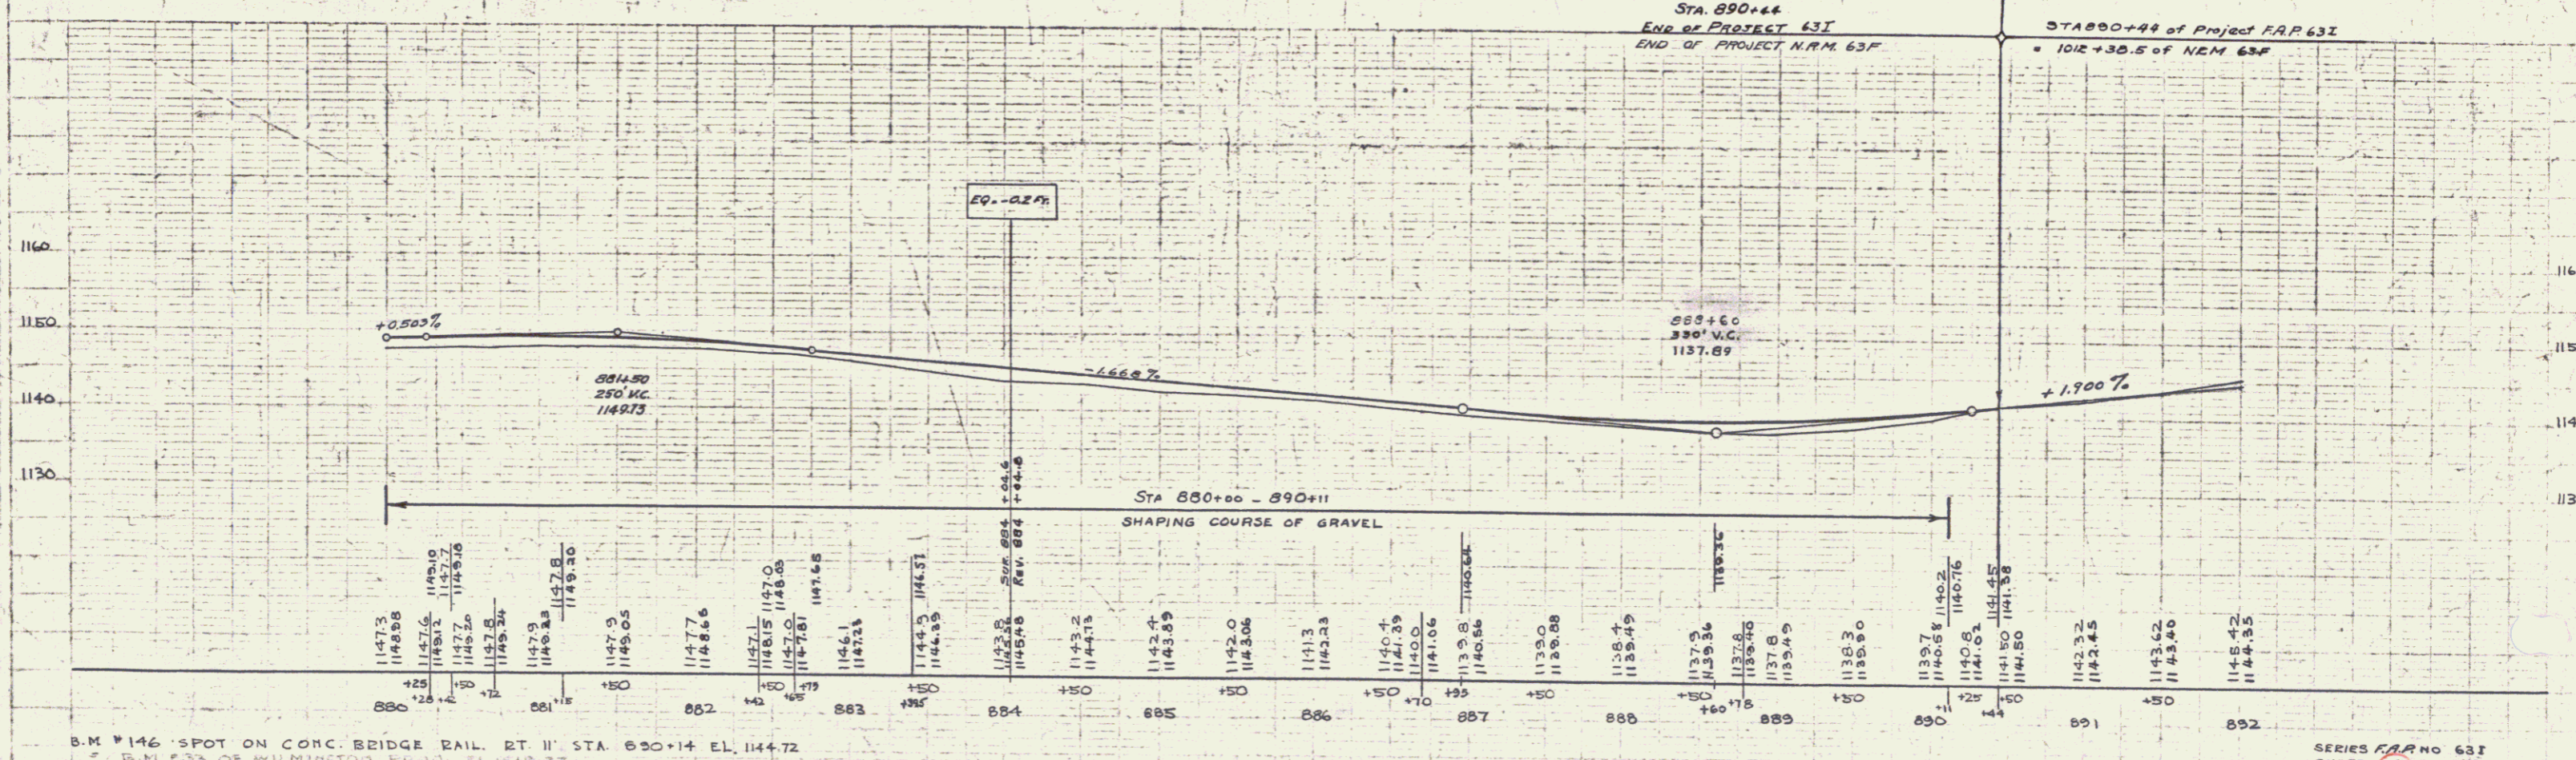


DESIGNED BY  
 D. MACCHI 8/34

DESIGNED BY  
 D. MACCHI 8/34

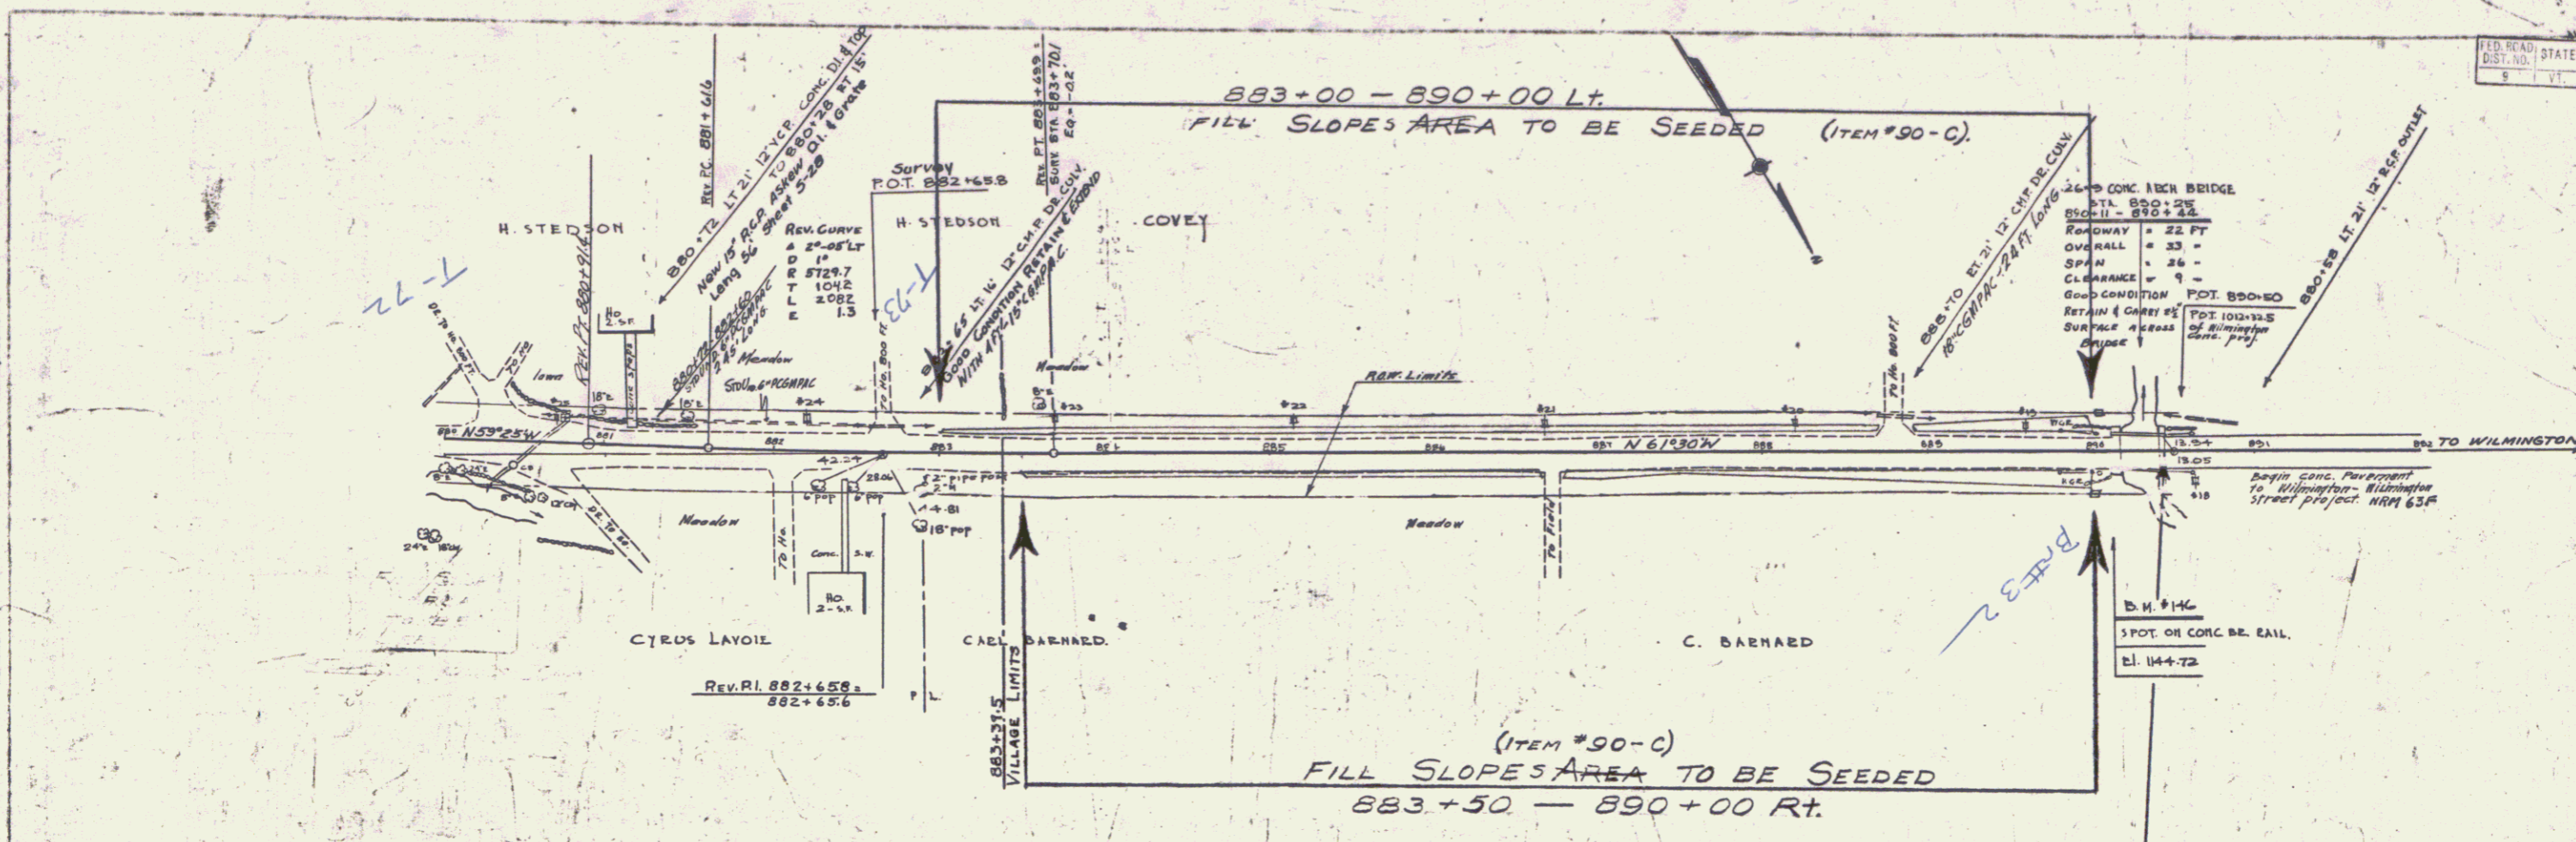

B.M. #146 SPOT ON CONC. BRIDGE RAIL RT. 21 STA. 890+14 EL. 1144.72  
 B.M. #33 OF WILMINGTON PROJ. 11 1913-37