



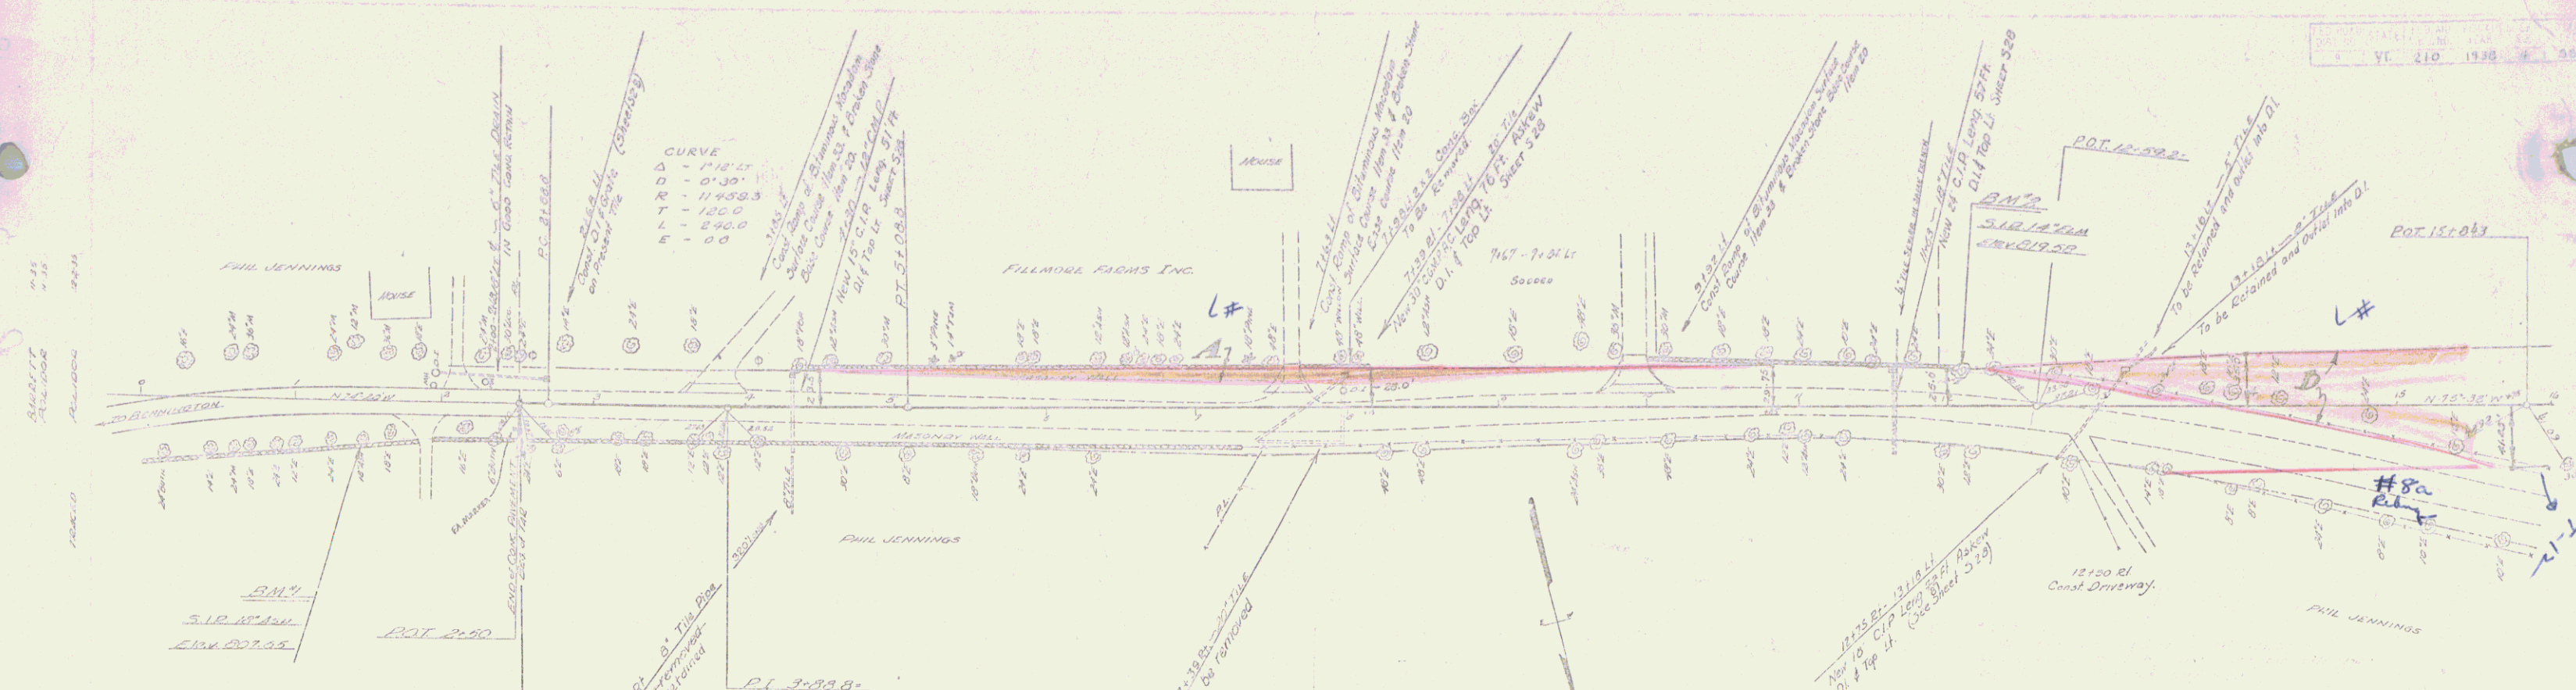

POOR ORIGINAL COPY

PARCEL INSTRUMENT	DATE	GRANTOR	GRANTEE	RECORDED	REMARKS
ABCD EFGHI	Q.C.D.	6-28-37	FILLMORE FARMS INC.	STOFV 1 465 527-37	CUL STA 71.10

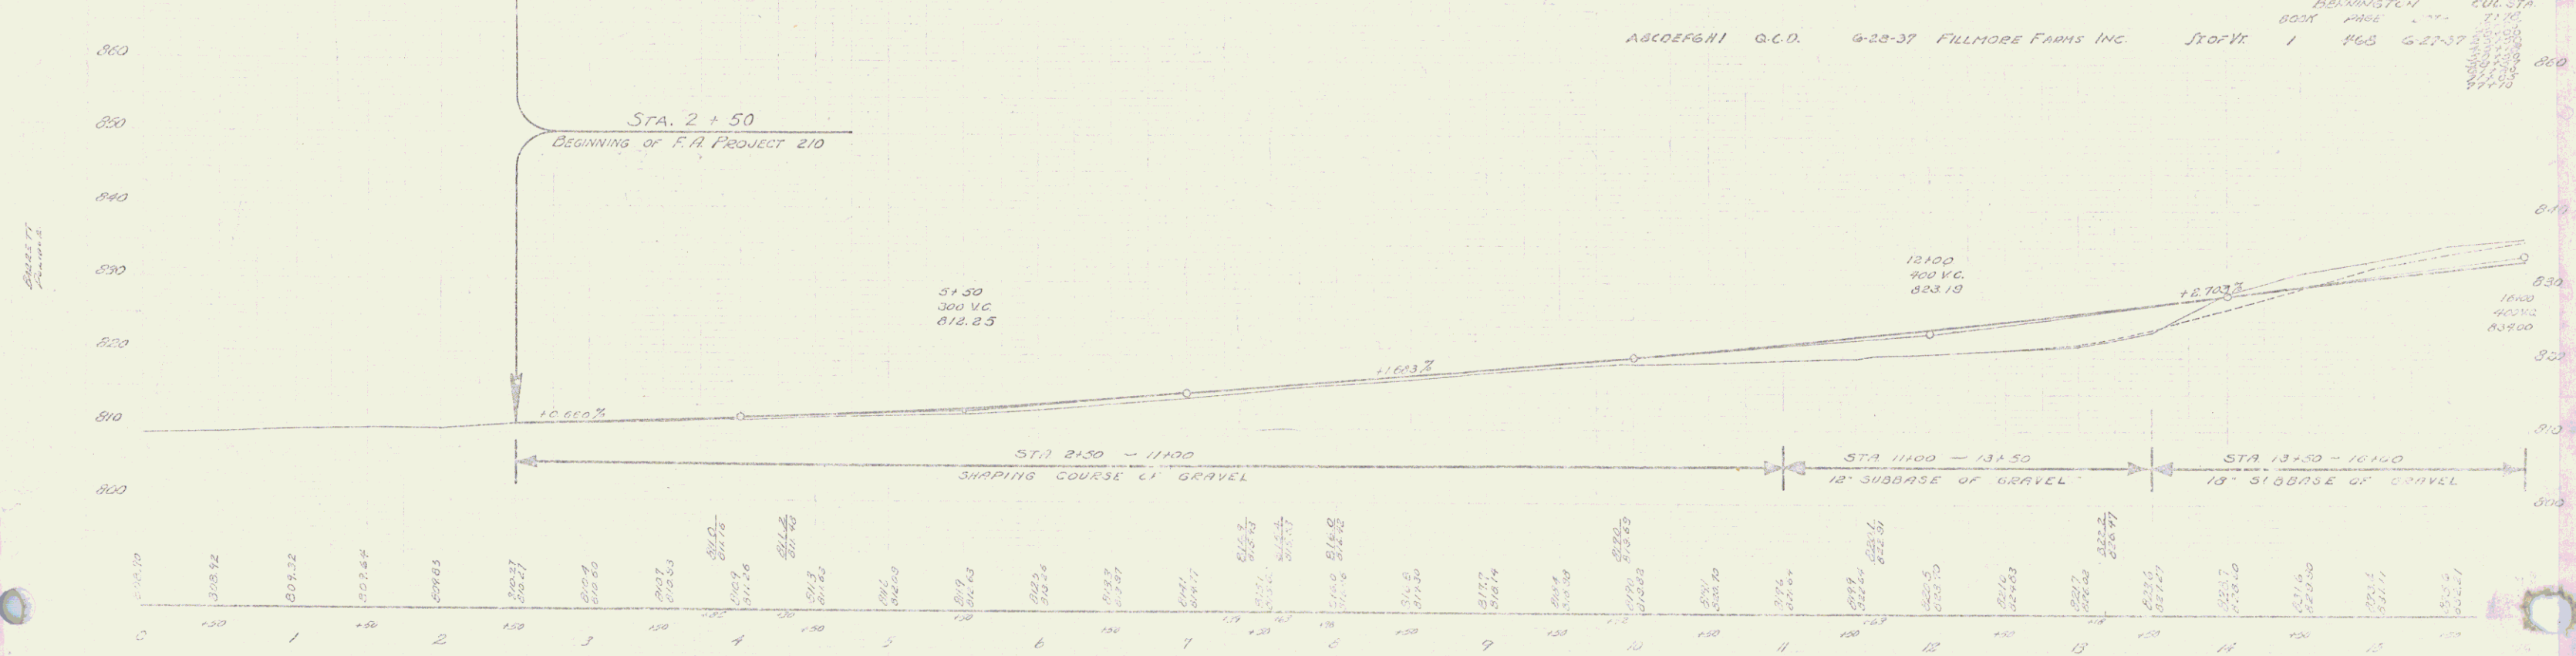

51+50 SPIKE IN FOOT BETWEEN STA 1105 AND 1106
 812 SPIKE IN FOOT BETWEEN STA 1106 AND 1107

SURVEY F.A.P. NO. 210
 SHEET 4 OF 50