



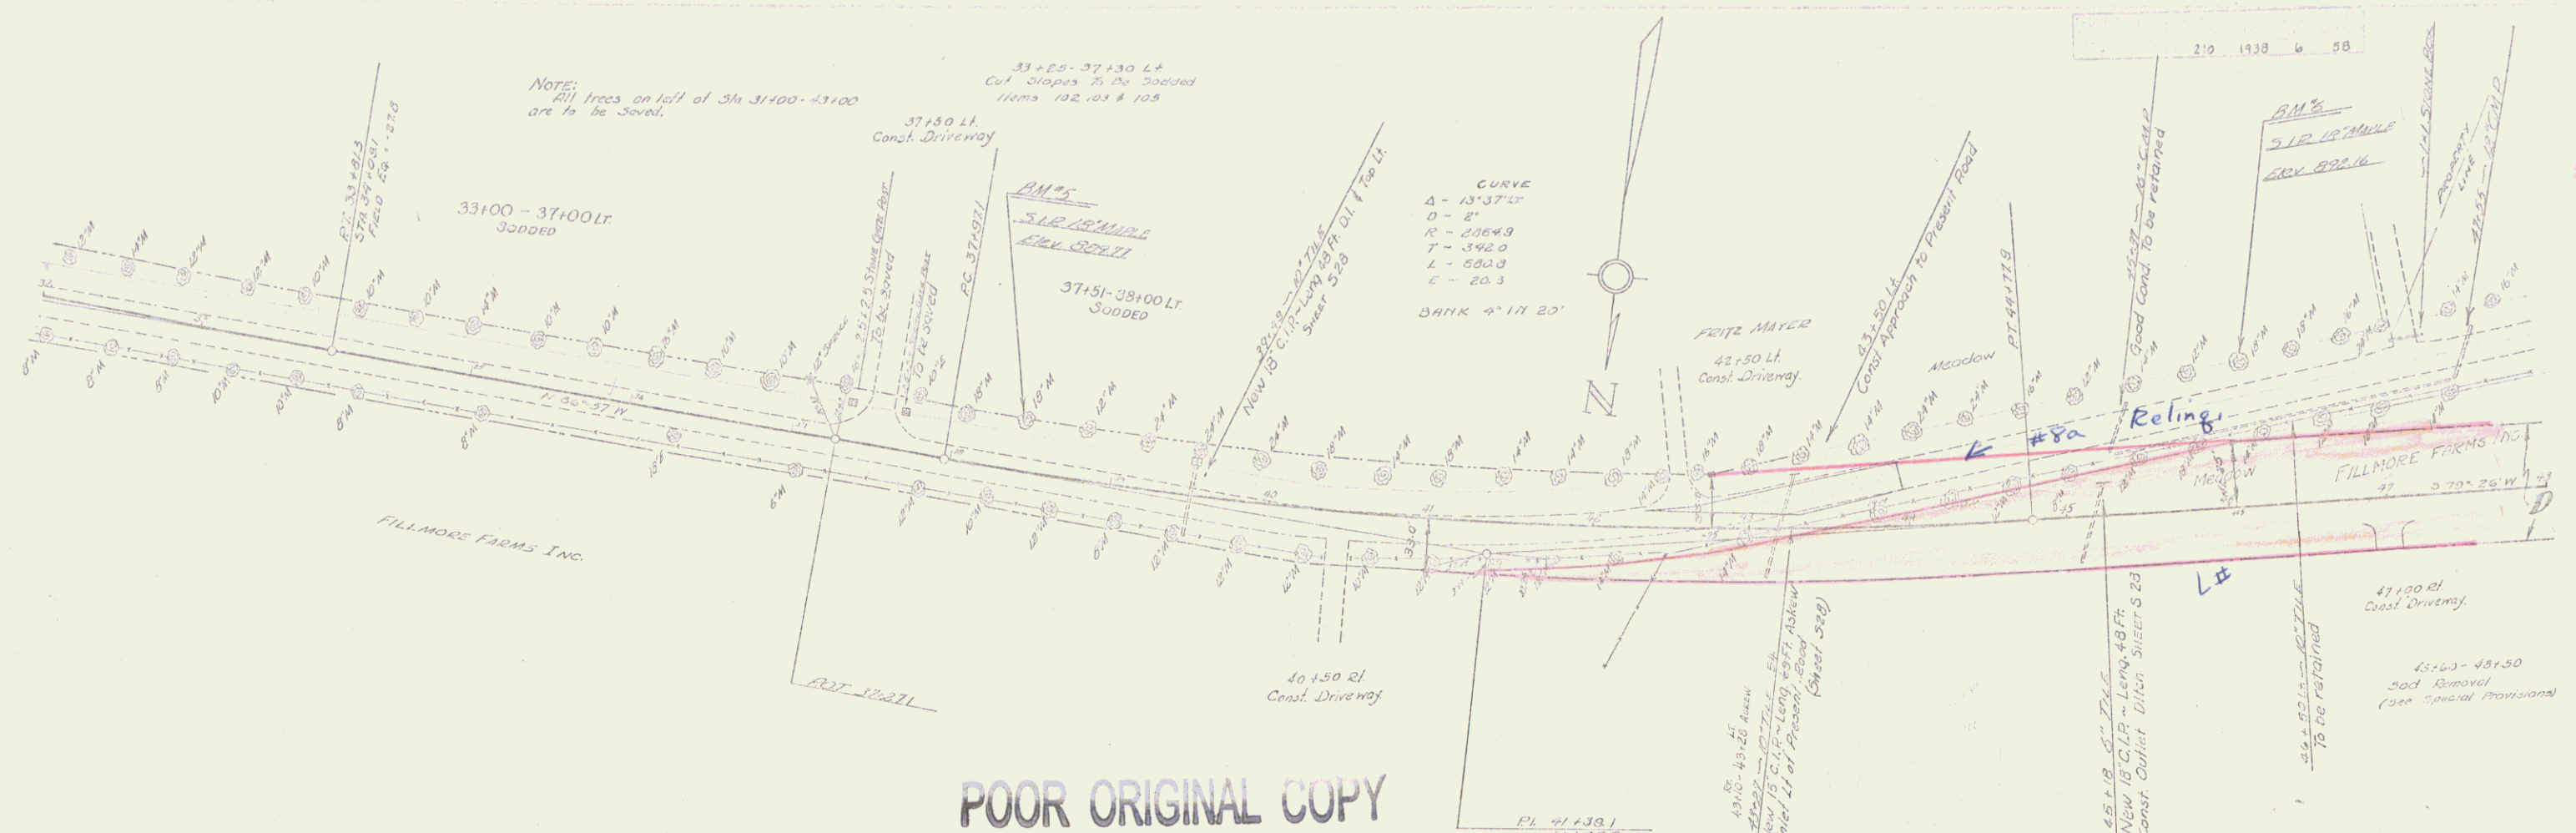

POOR ORIGINAL COPY

PARCEL INSTRUMENT	DATE	GRANTOR	GRANTEE	RECORDED	REMARKS
ACCORDS 111	6-28-37	FILLMORE FARMS INC.	FERDINAND L. MAYER	BOOK 1 PAGE 408	2195, 2140

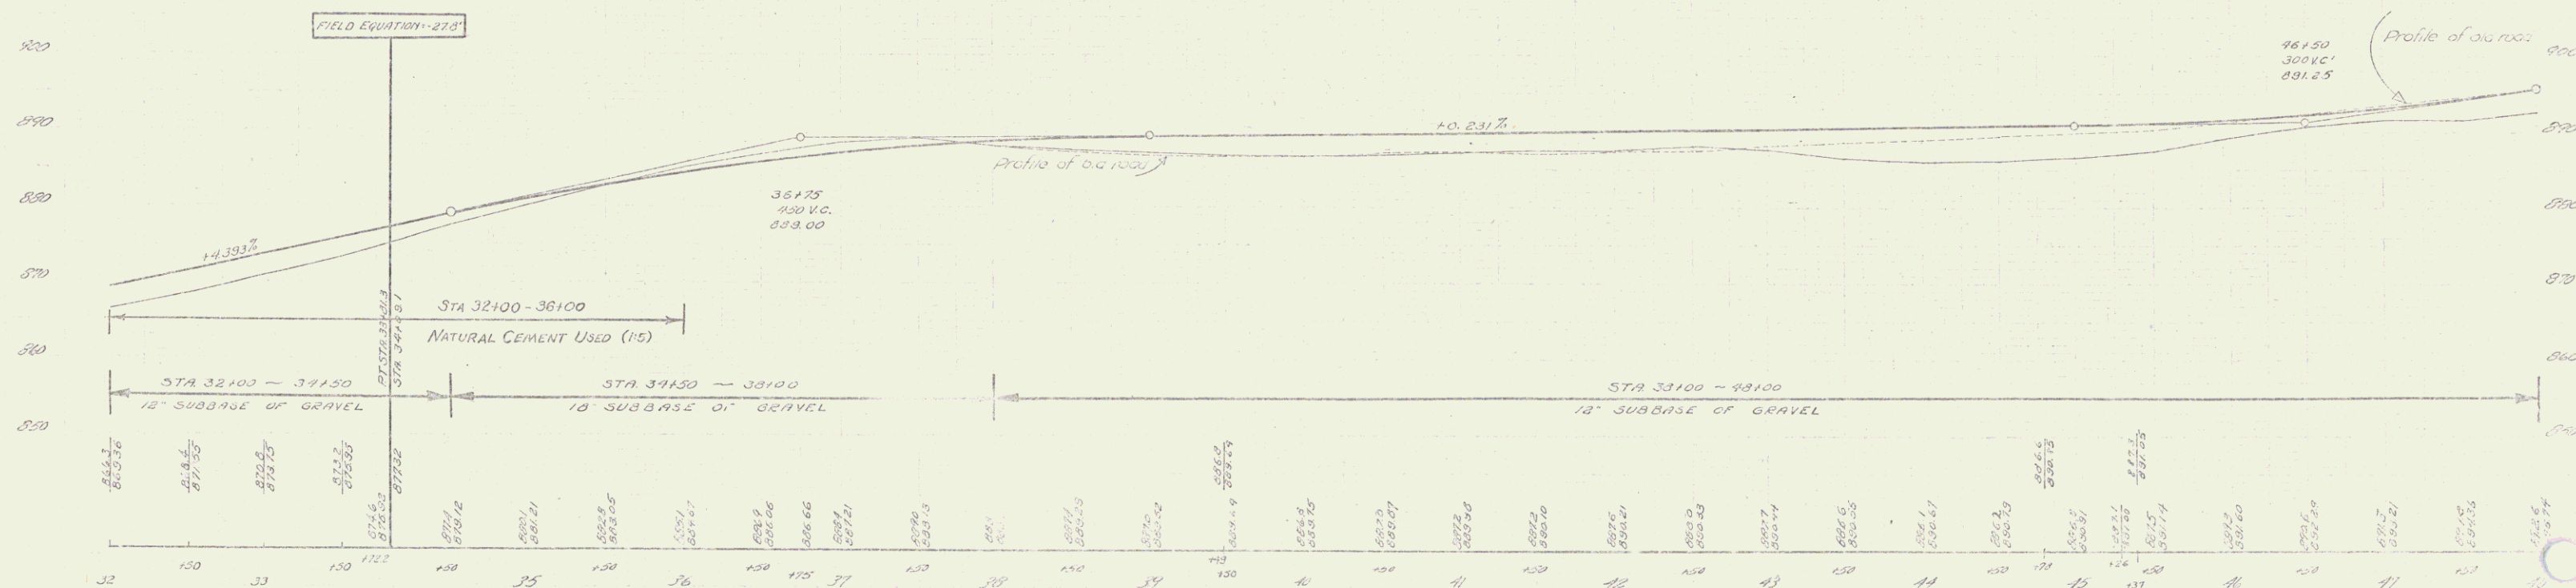

ERM'S SPIKE IN ROOT 15" MAPLE 31' LT STA 38+42 ERM 889.77
 3M'S SPIKE IN ROOT 15" MAPLE 30' LT STA 40+10 ERM 892.16

SHEET 6 OF 58