



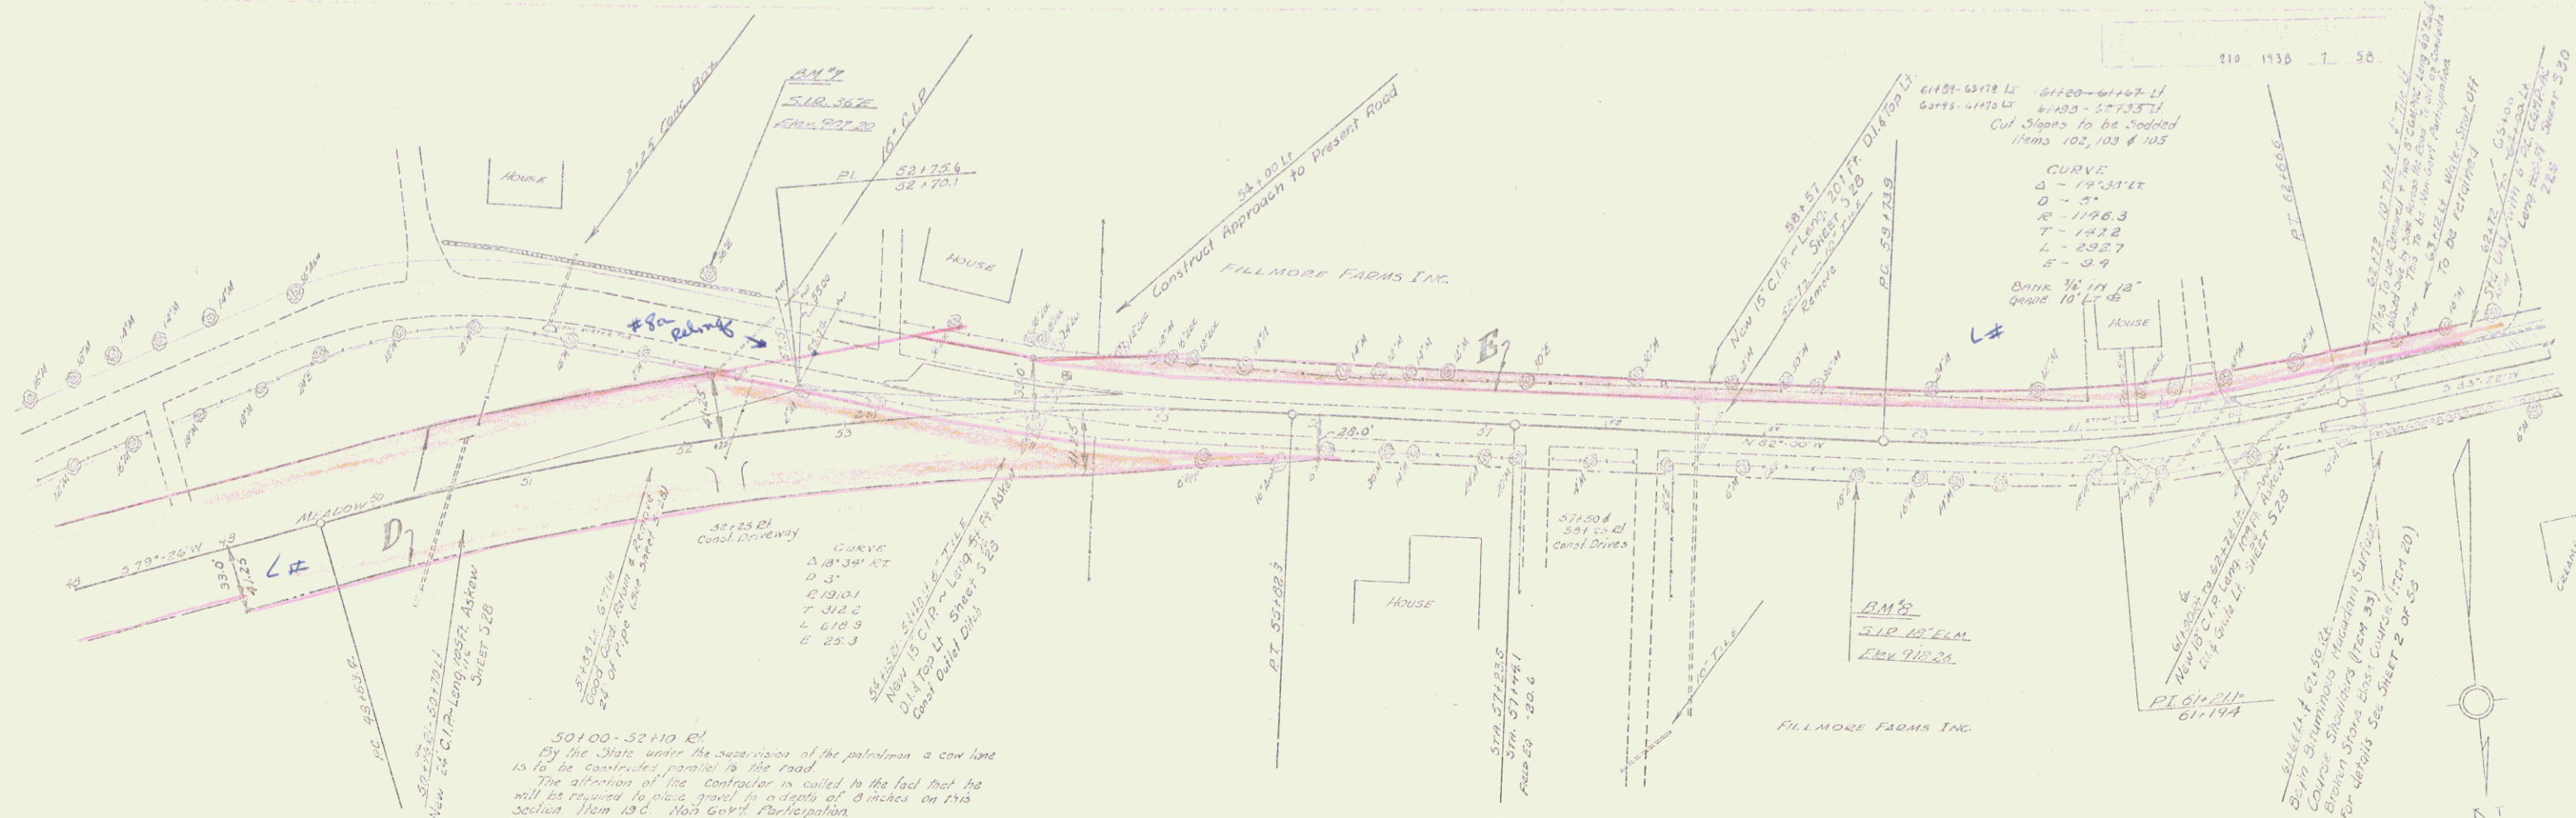

| PARCEL   | INSTRUMENT | DATE    | GRANTOR             | GRANTEE | RECORDED | BOOK | PAGE    | DATE                                                               | COL. STA. |
|----------|------------|---------|---------------------|---------|----------|------|---------|--------------------------------------------------------------------|-----------|
| ABCEFGHI | G.C.D.     | 6-28-37 | FILLMORE FARMS INC. | STORVY  | 1        | 408  | 6-29-37 | 7478.13-25, 20100, 25150, 45112, 50130, 58157, 61180, 71105, 77110 |           |

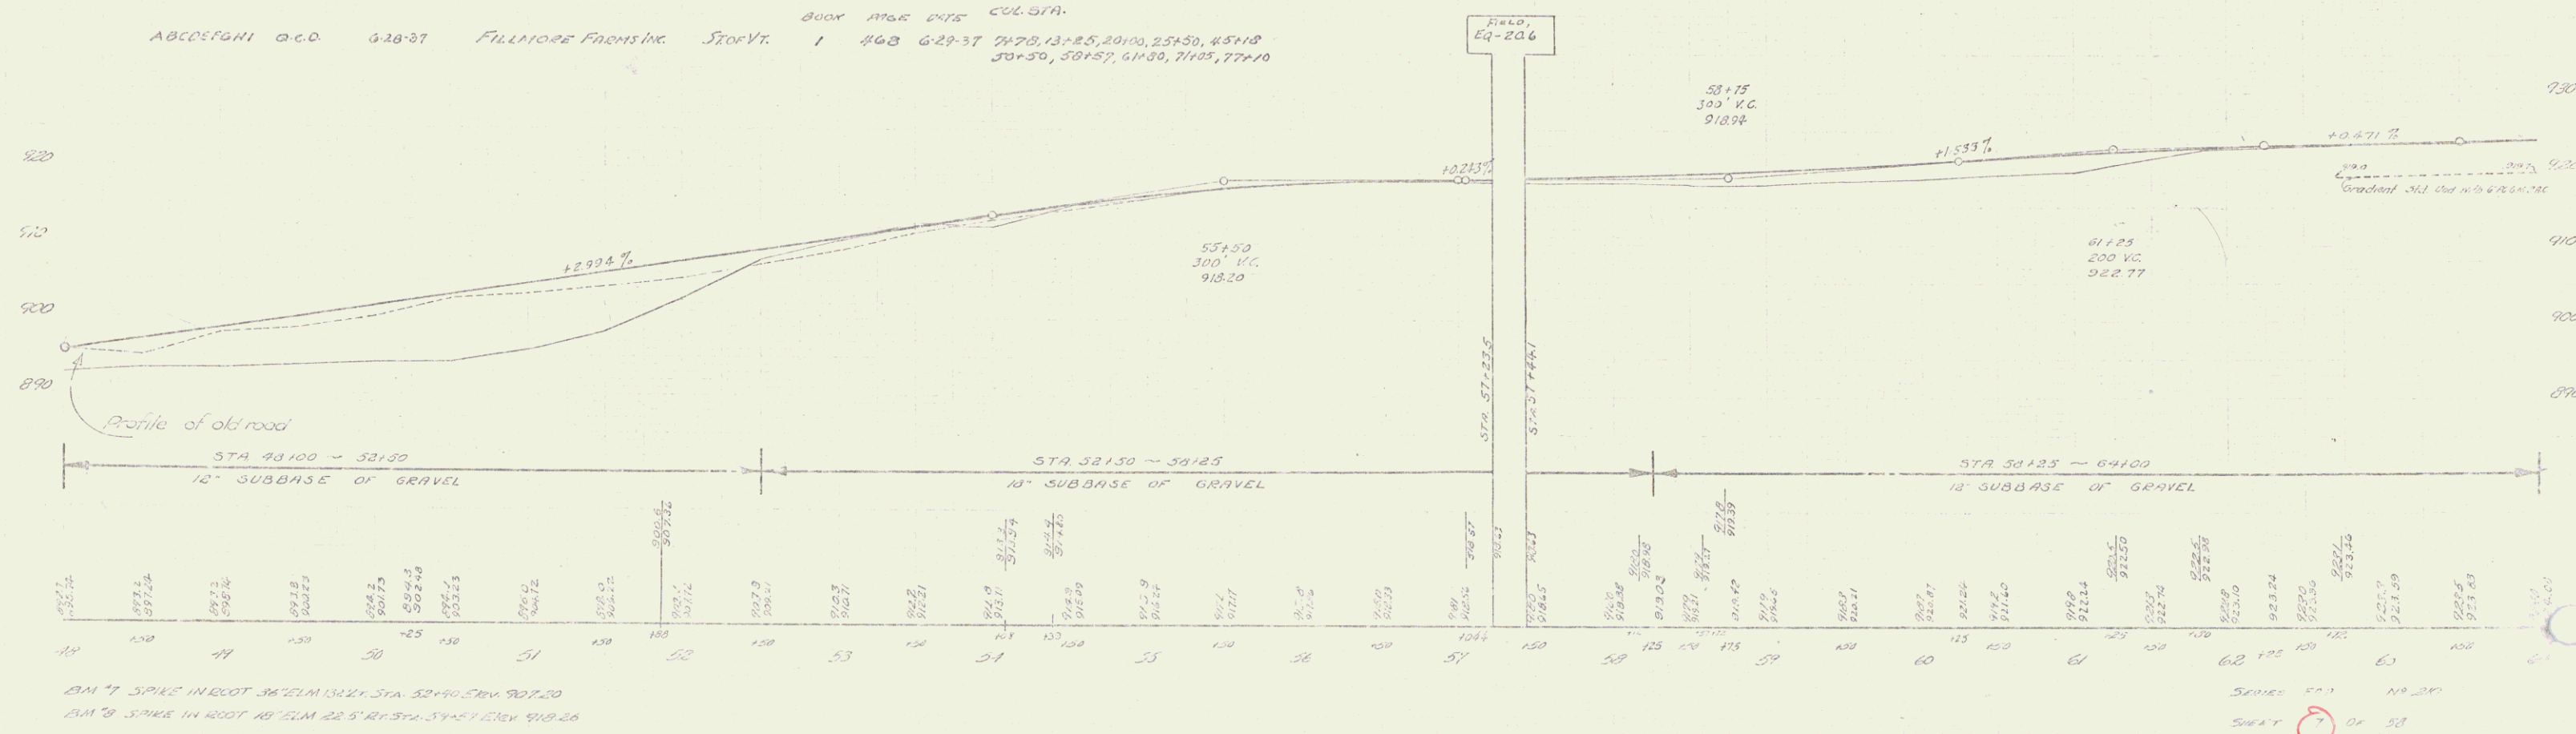

BM 7 SPIKE IN ROOT 34' ELM 134' STA 52+40.56V 907.20  
 BM 8 SPIKE IN ROOT 18' ELM 22' 5' 11" STA 57+27.57V 918.26

SHEET 7 OF 58